


PLAN
 C. E. PUTNAM
 D. MACCHI
 TRACED

DATE: FEB 29 1980
 SHEET NO. 6
 TOTAL SHEETS 10

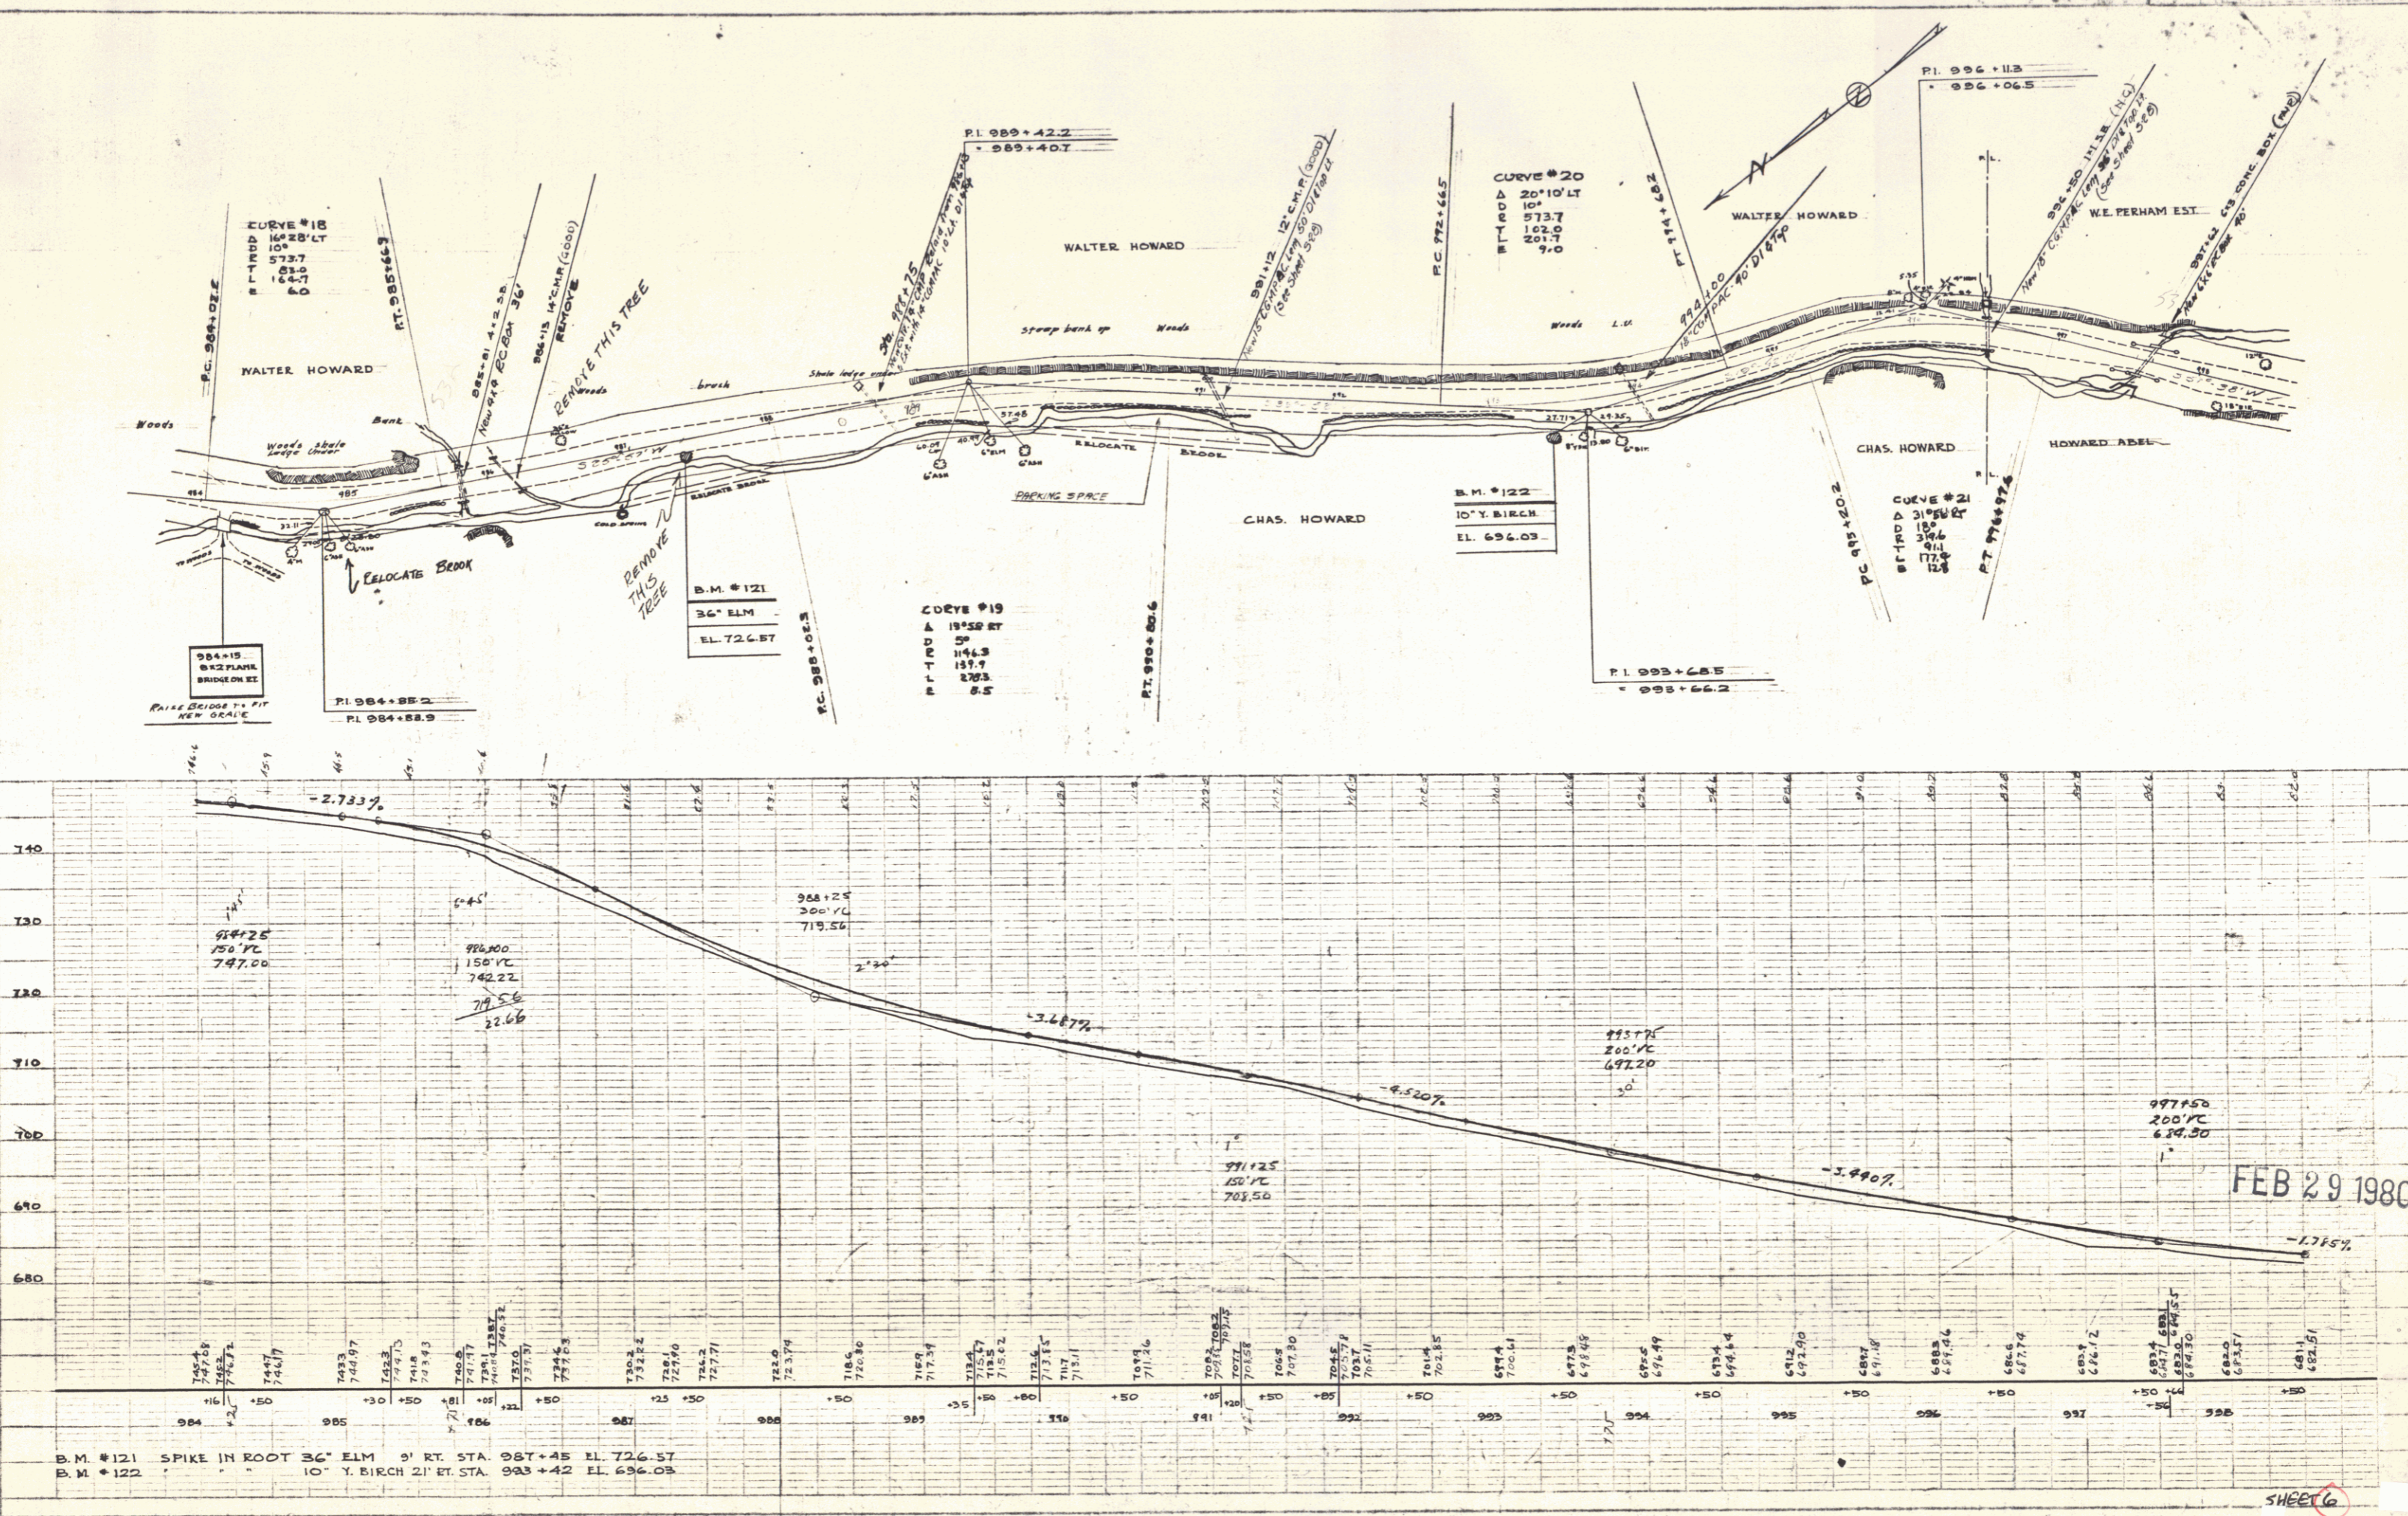

B.M. #121 SPIKE IN ROOT 36" ELM 9' RT. STA. 987+45 EL. 726.57
 B.M. #122 " " " " 10" Y. BIRCH 21' RT. STA. 993+42 EL. 696.03

FEB 29 1980

SHEET 6