
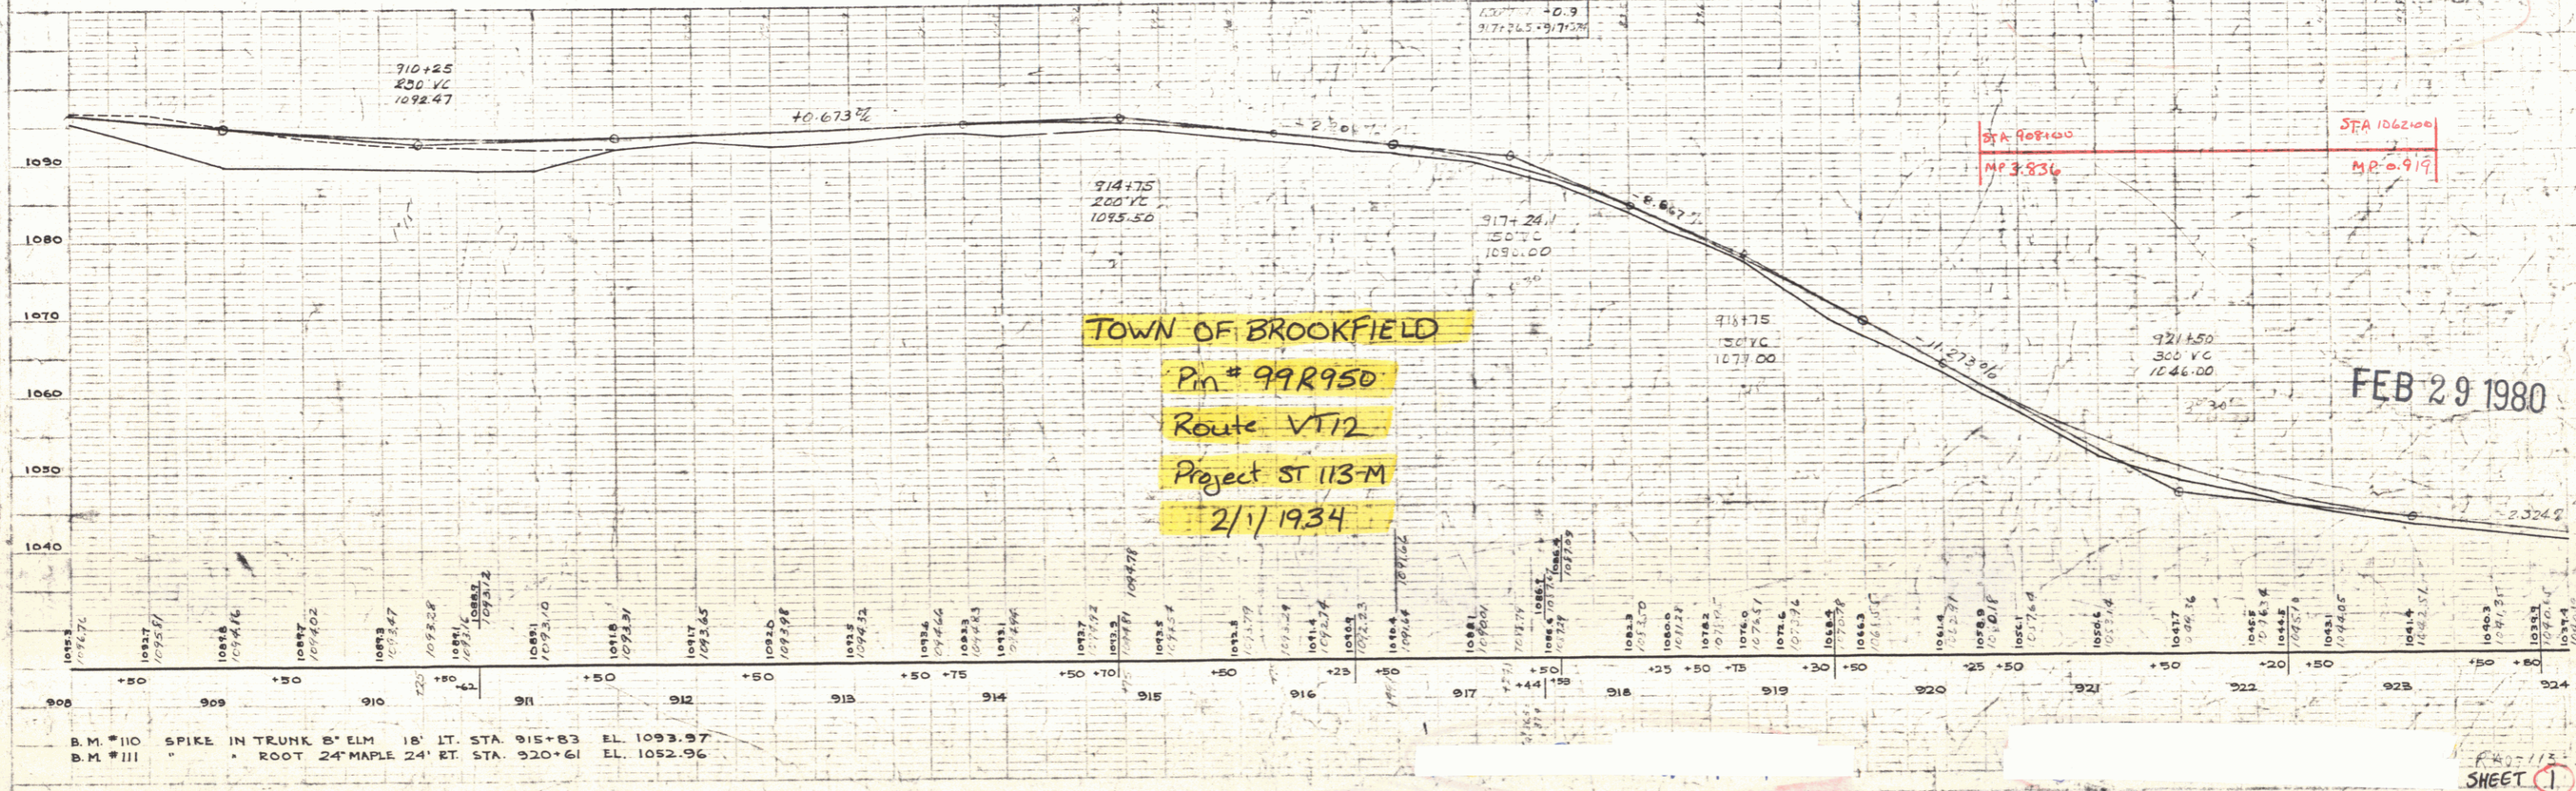


C.E. PUTNAM
 D. MAGGI
 2/74

C.E. PUTNAM
 D. MAGGI

Parcel	Kind of Instrument	Date of Grant	Grantor	Grantee	Recorded Brookfield	Remarks

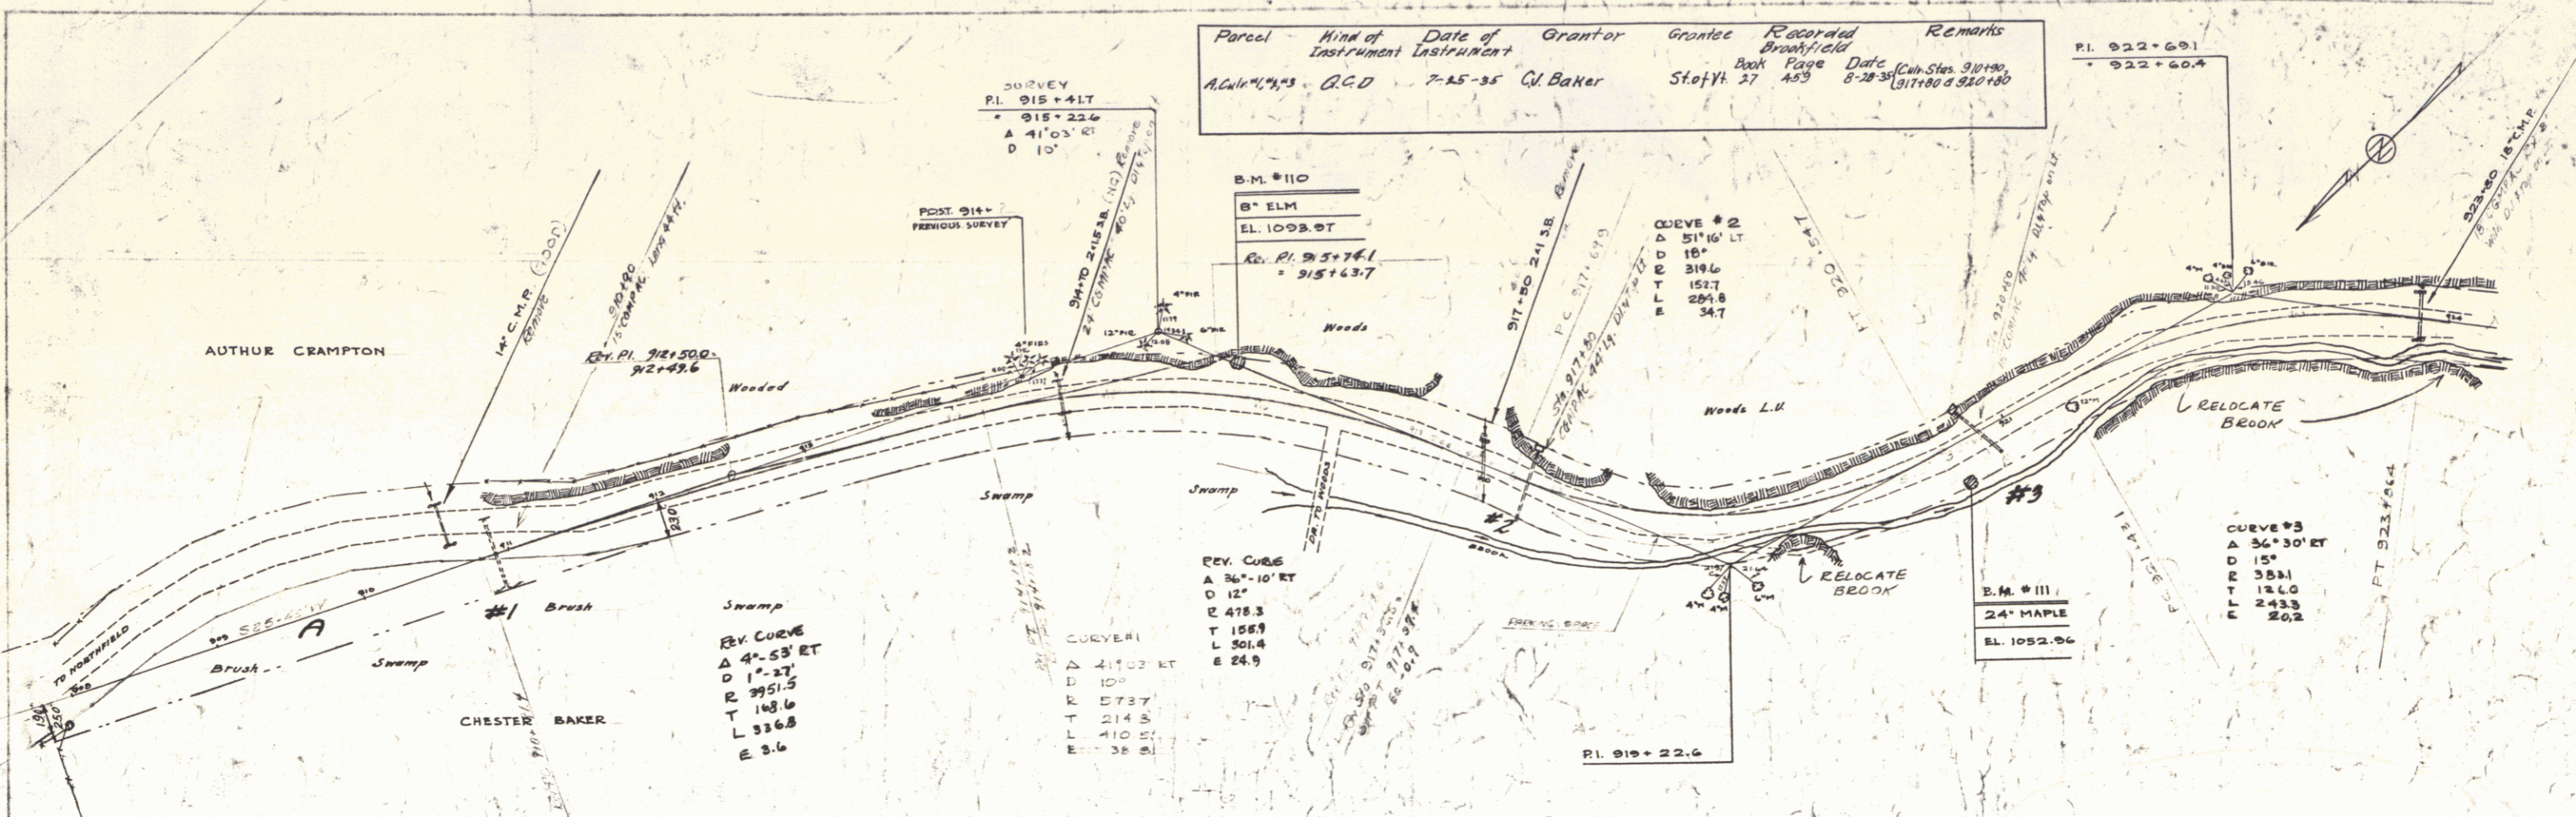

TOWN OF BROOKFIELD
 Pin # 99R950
 Route VT12
 Project ST 113-M
 2/1/1934


SFA 108100
 MP 3.836

FEB 29 1980

B.M. #110 SPIKE IN TRUNK B' ELM 18' LT. STA. 915+83 EL. 1093.97
 B.M. #111 ROOT 24' MAPLE 24' RT. STA. 920+61 EL. 1052.96

SHEET 1

Parcel Kind of Date of Granter Grantee Recorded Remarks
 Instrument Cdr. # A25 Q.C.D. 7-25-35 C.J. Baker St of Vt. 27 1899 Book Page Date
 8-28-35 Cdr. 5th 928100 2301+25

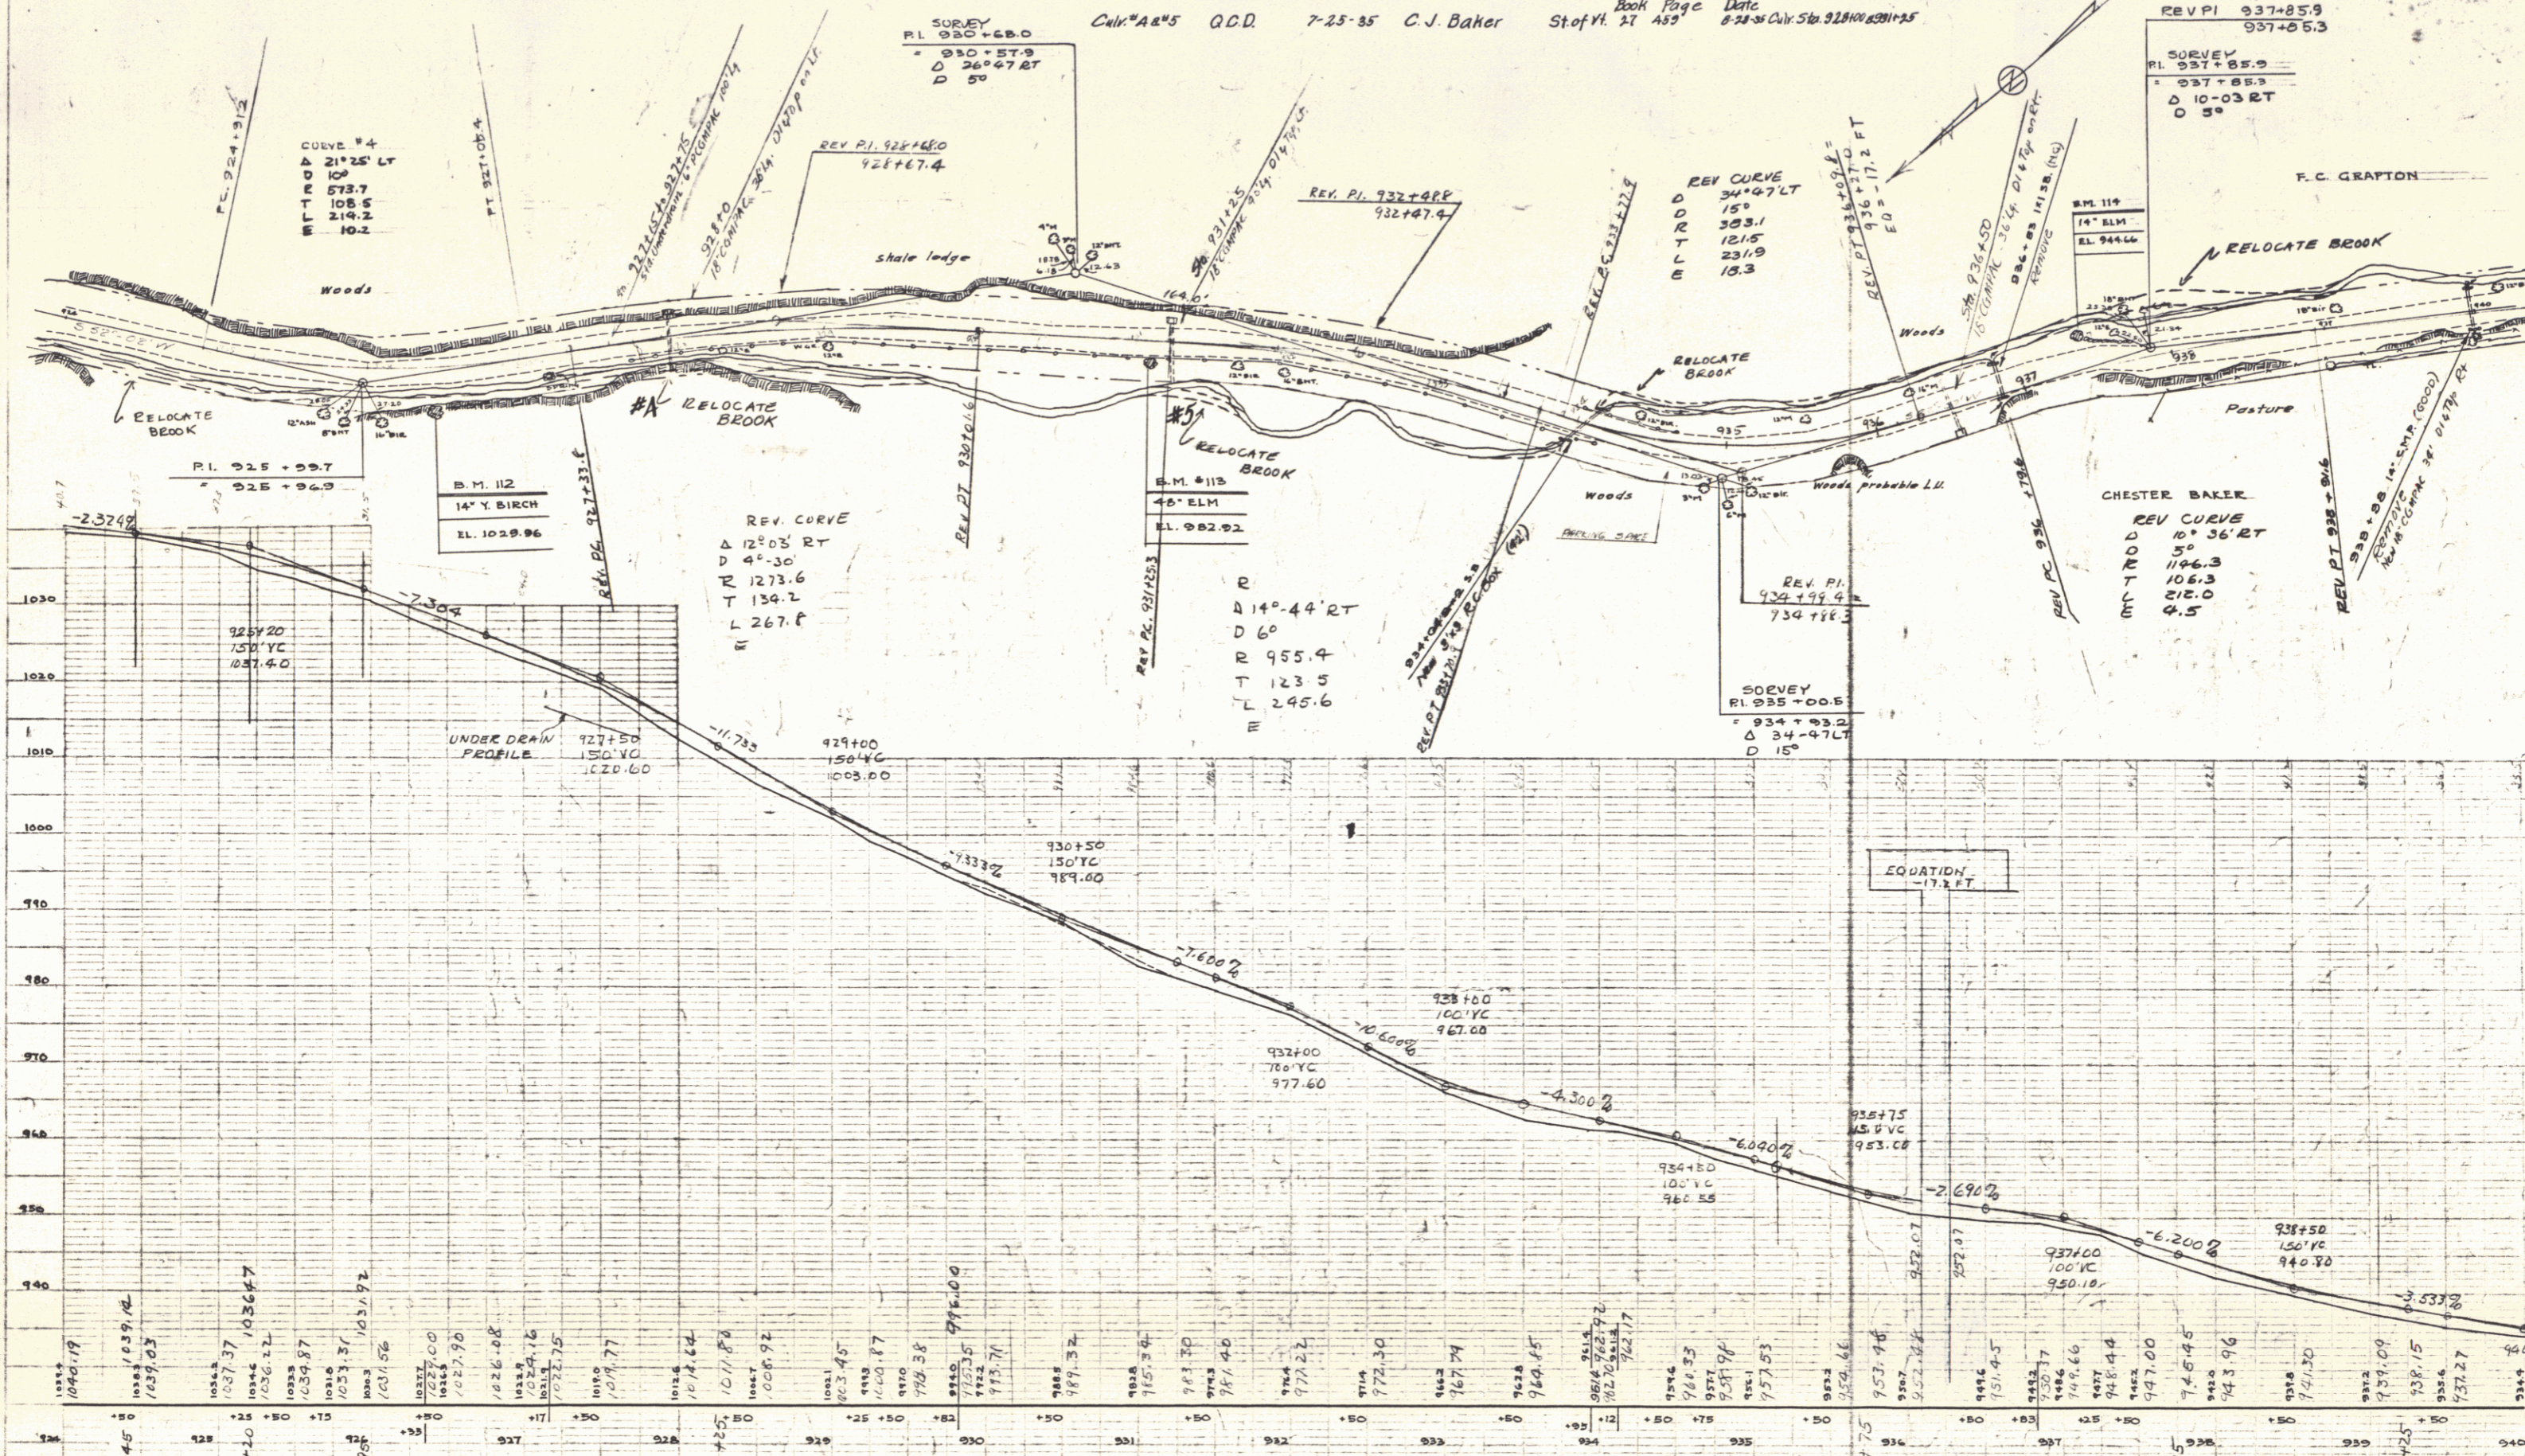

C. PUTNAM
 S. MACCHI
 D. MACCHI

S. PUTNAM
 S. MACCHI


B.M. # 112	SPIKE	IN	ROOT	14"	BIRCH	25'	LT.	STA.	926+48	EL.	1029.96
B.M. # 113	"	"	TRUNK	40"	ELM	22'	RT.	STA.	931+15	EL.	982.92
B.M. # 114	"	"	ROOT	14"	ELM	21'	LT.	STA.	937+40	EL.	944.66

FEB 29 1980
 SHEET 2


C. E. POTNAM
 D. MACENT
 2/78
 TRACED

C. E. POTNAM
 D. MACENT

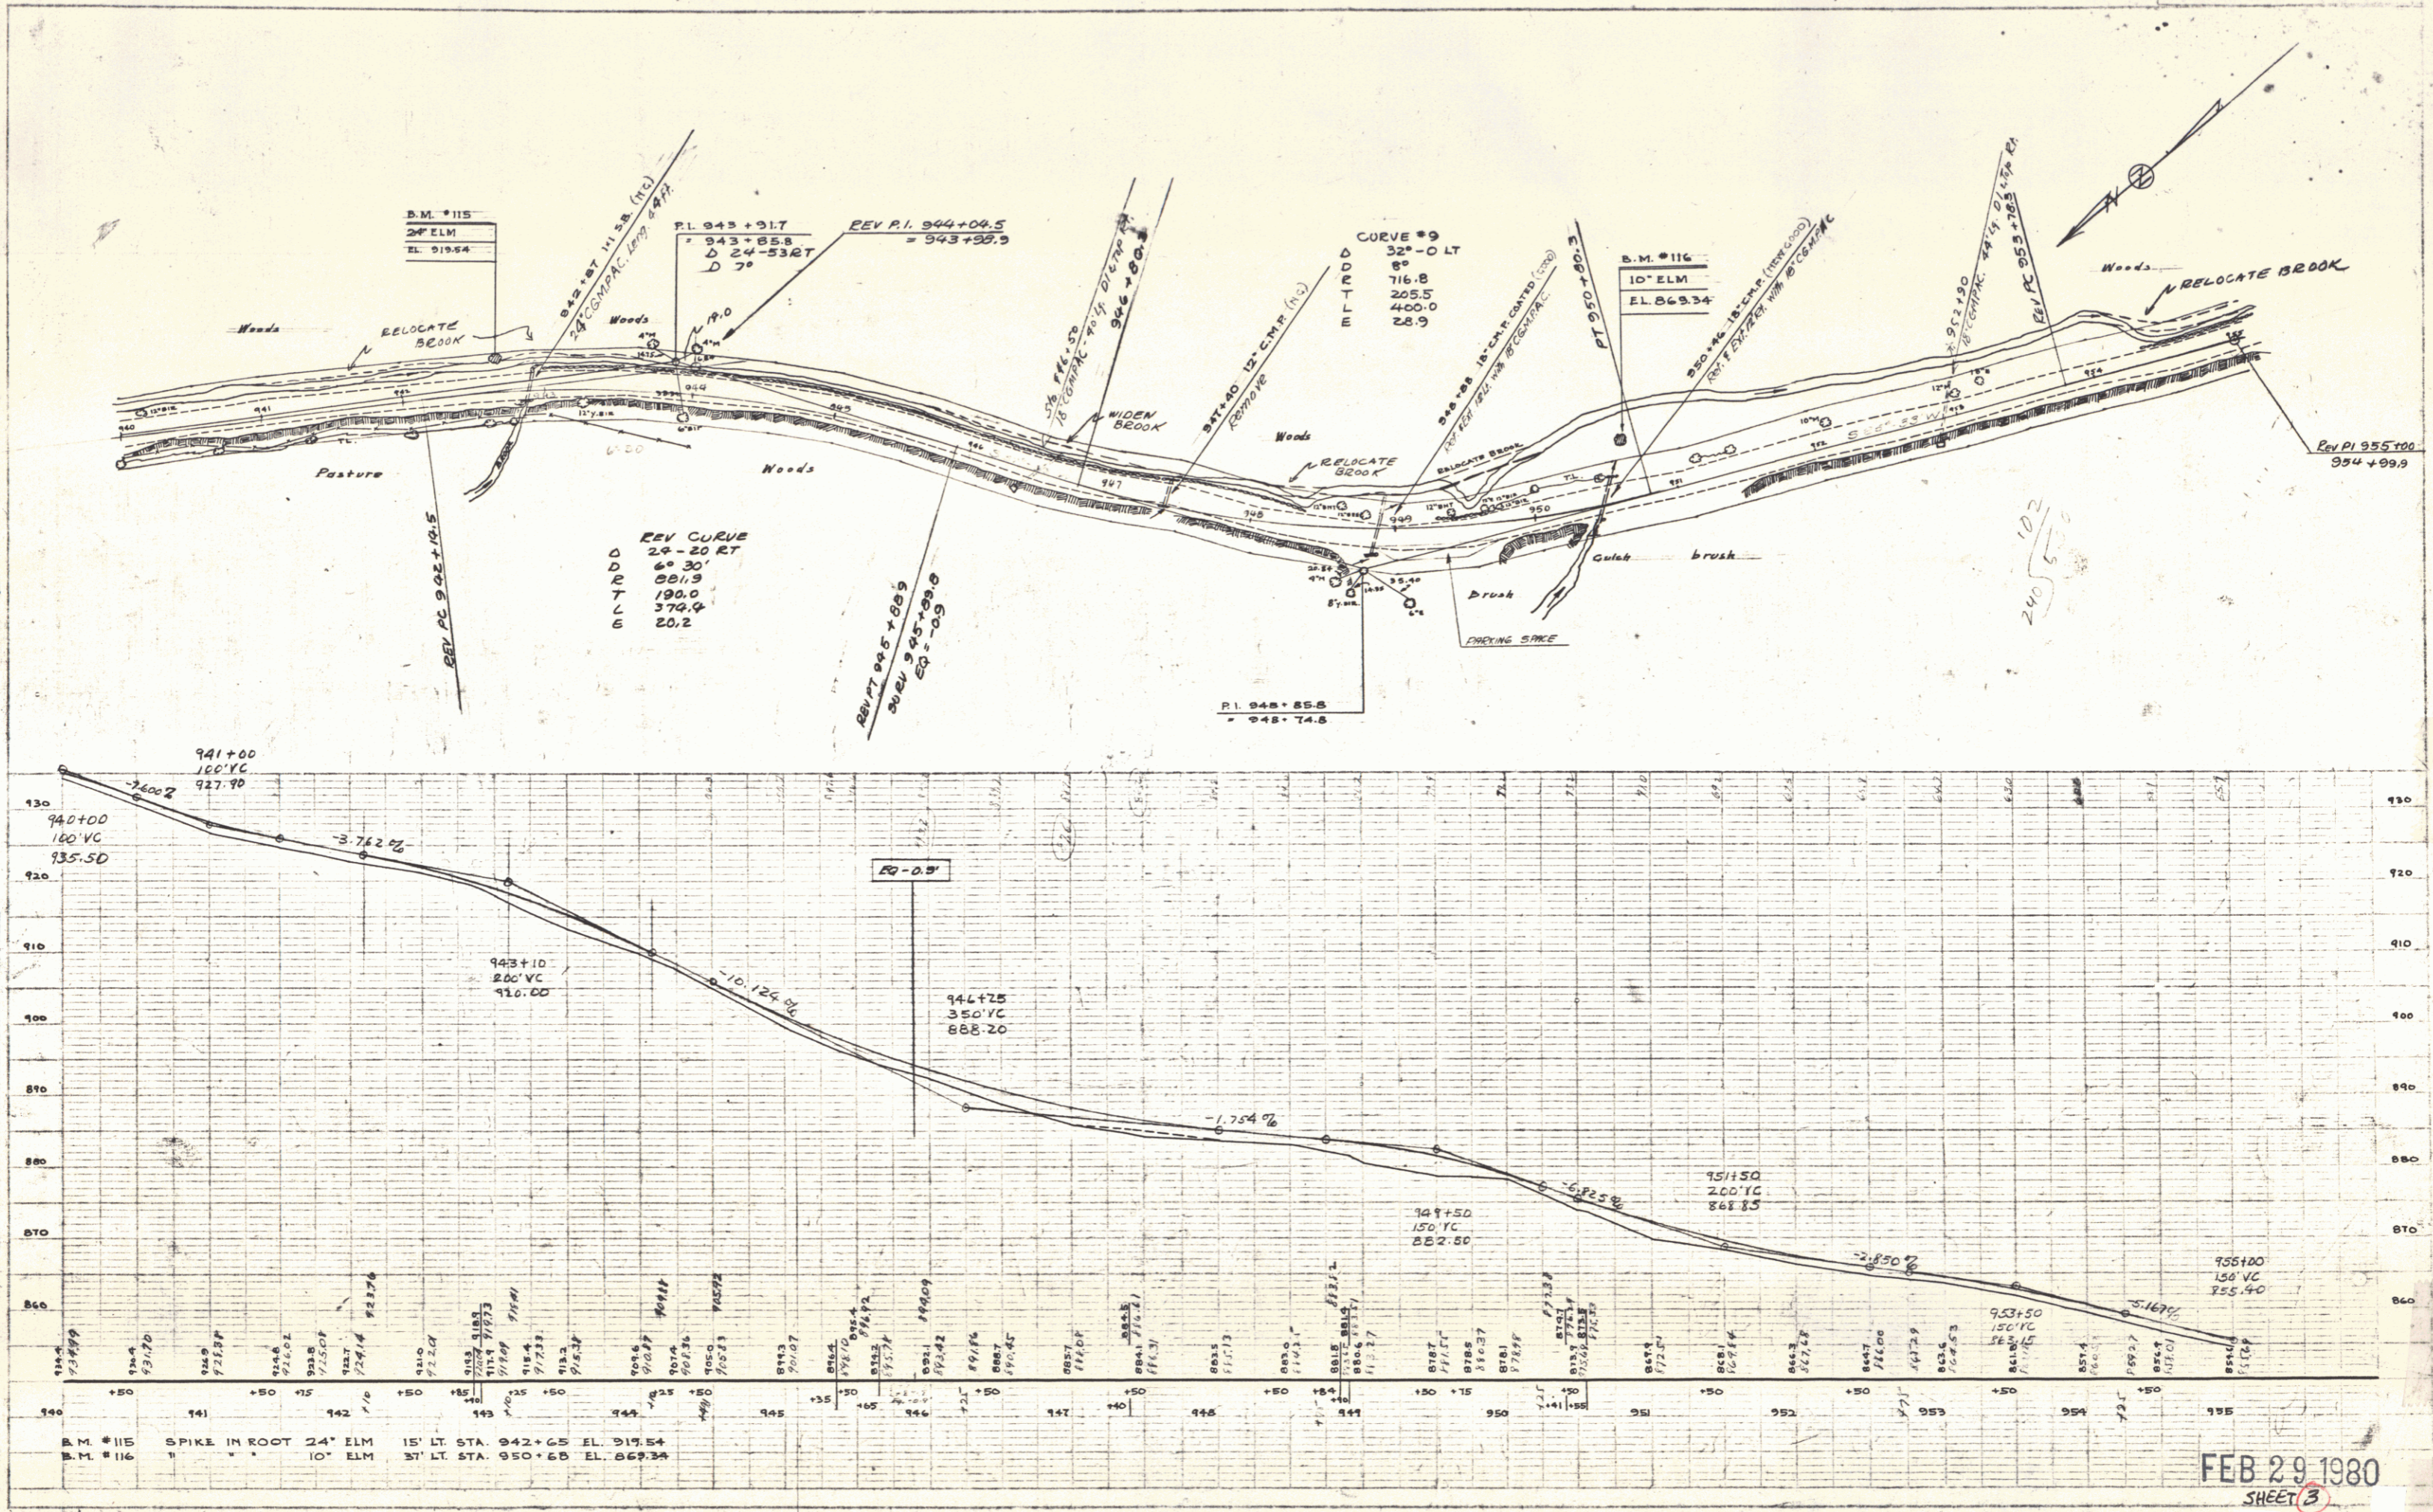


FEB 29 1980
 SHEET 3

3

PLAN
 C. E. PUTNAM
 D. MACCHI
 2/24
 3/24
 TRACED

PLAN
 C. E. PUTNAM
 D. MACCHI
 2/24
 3/24
 TRACED

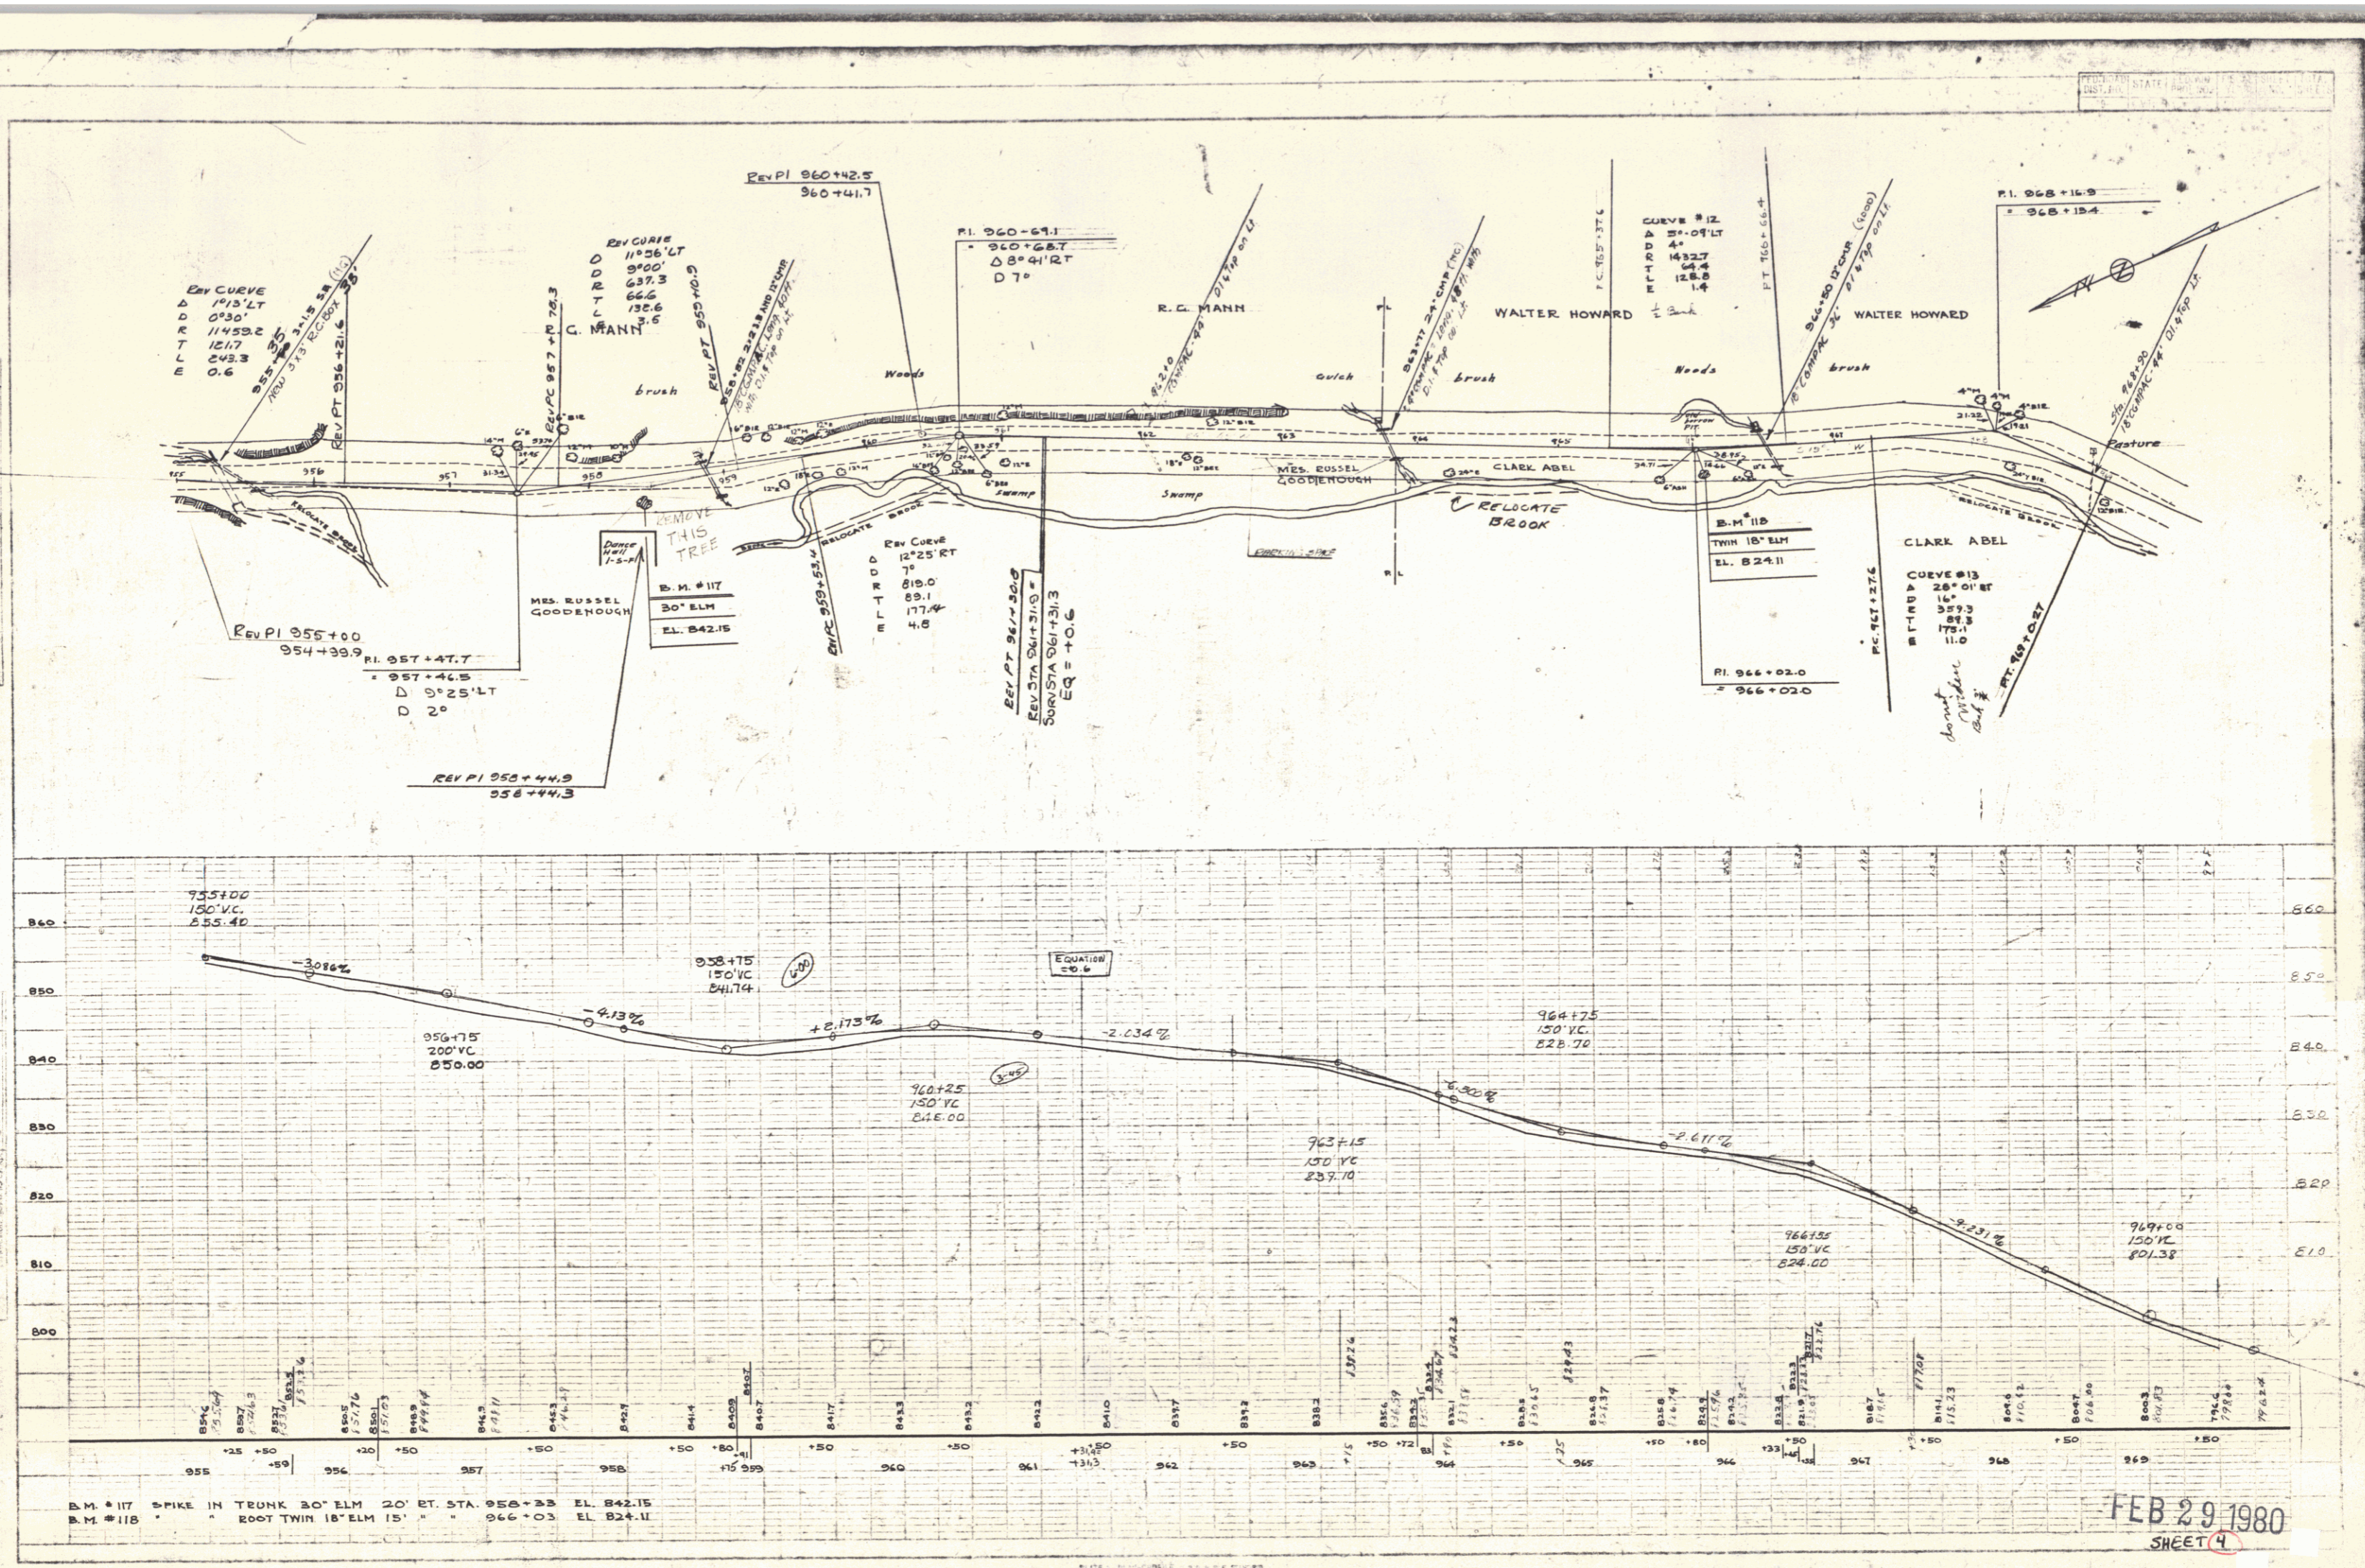


B.M. #117 SPIKE IN TRUNK 30' ELM 20' RT. STA. 958+25 EL. 842.15
 B.M. #118 ROOT TWIN 18' ELM 15' " 966+03 EL. 824.11

FEB 29 1980
 SHEET 4

4

PLAN
 C. E. PUTNAM
 D. MACCHI
 TRACED




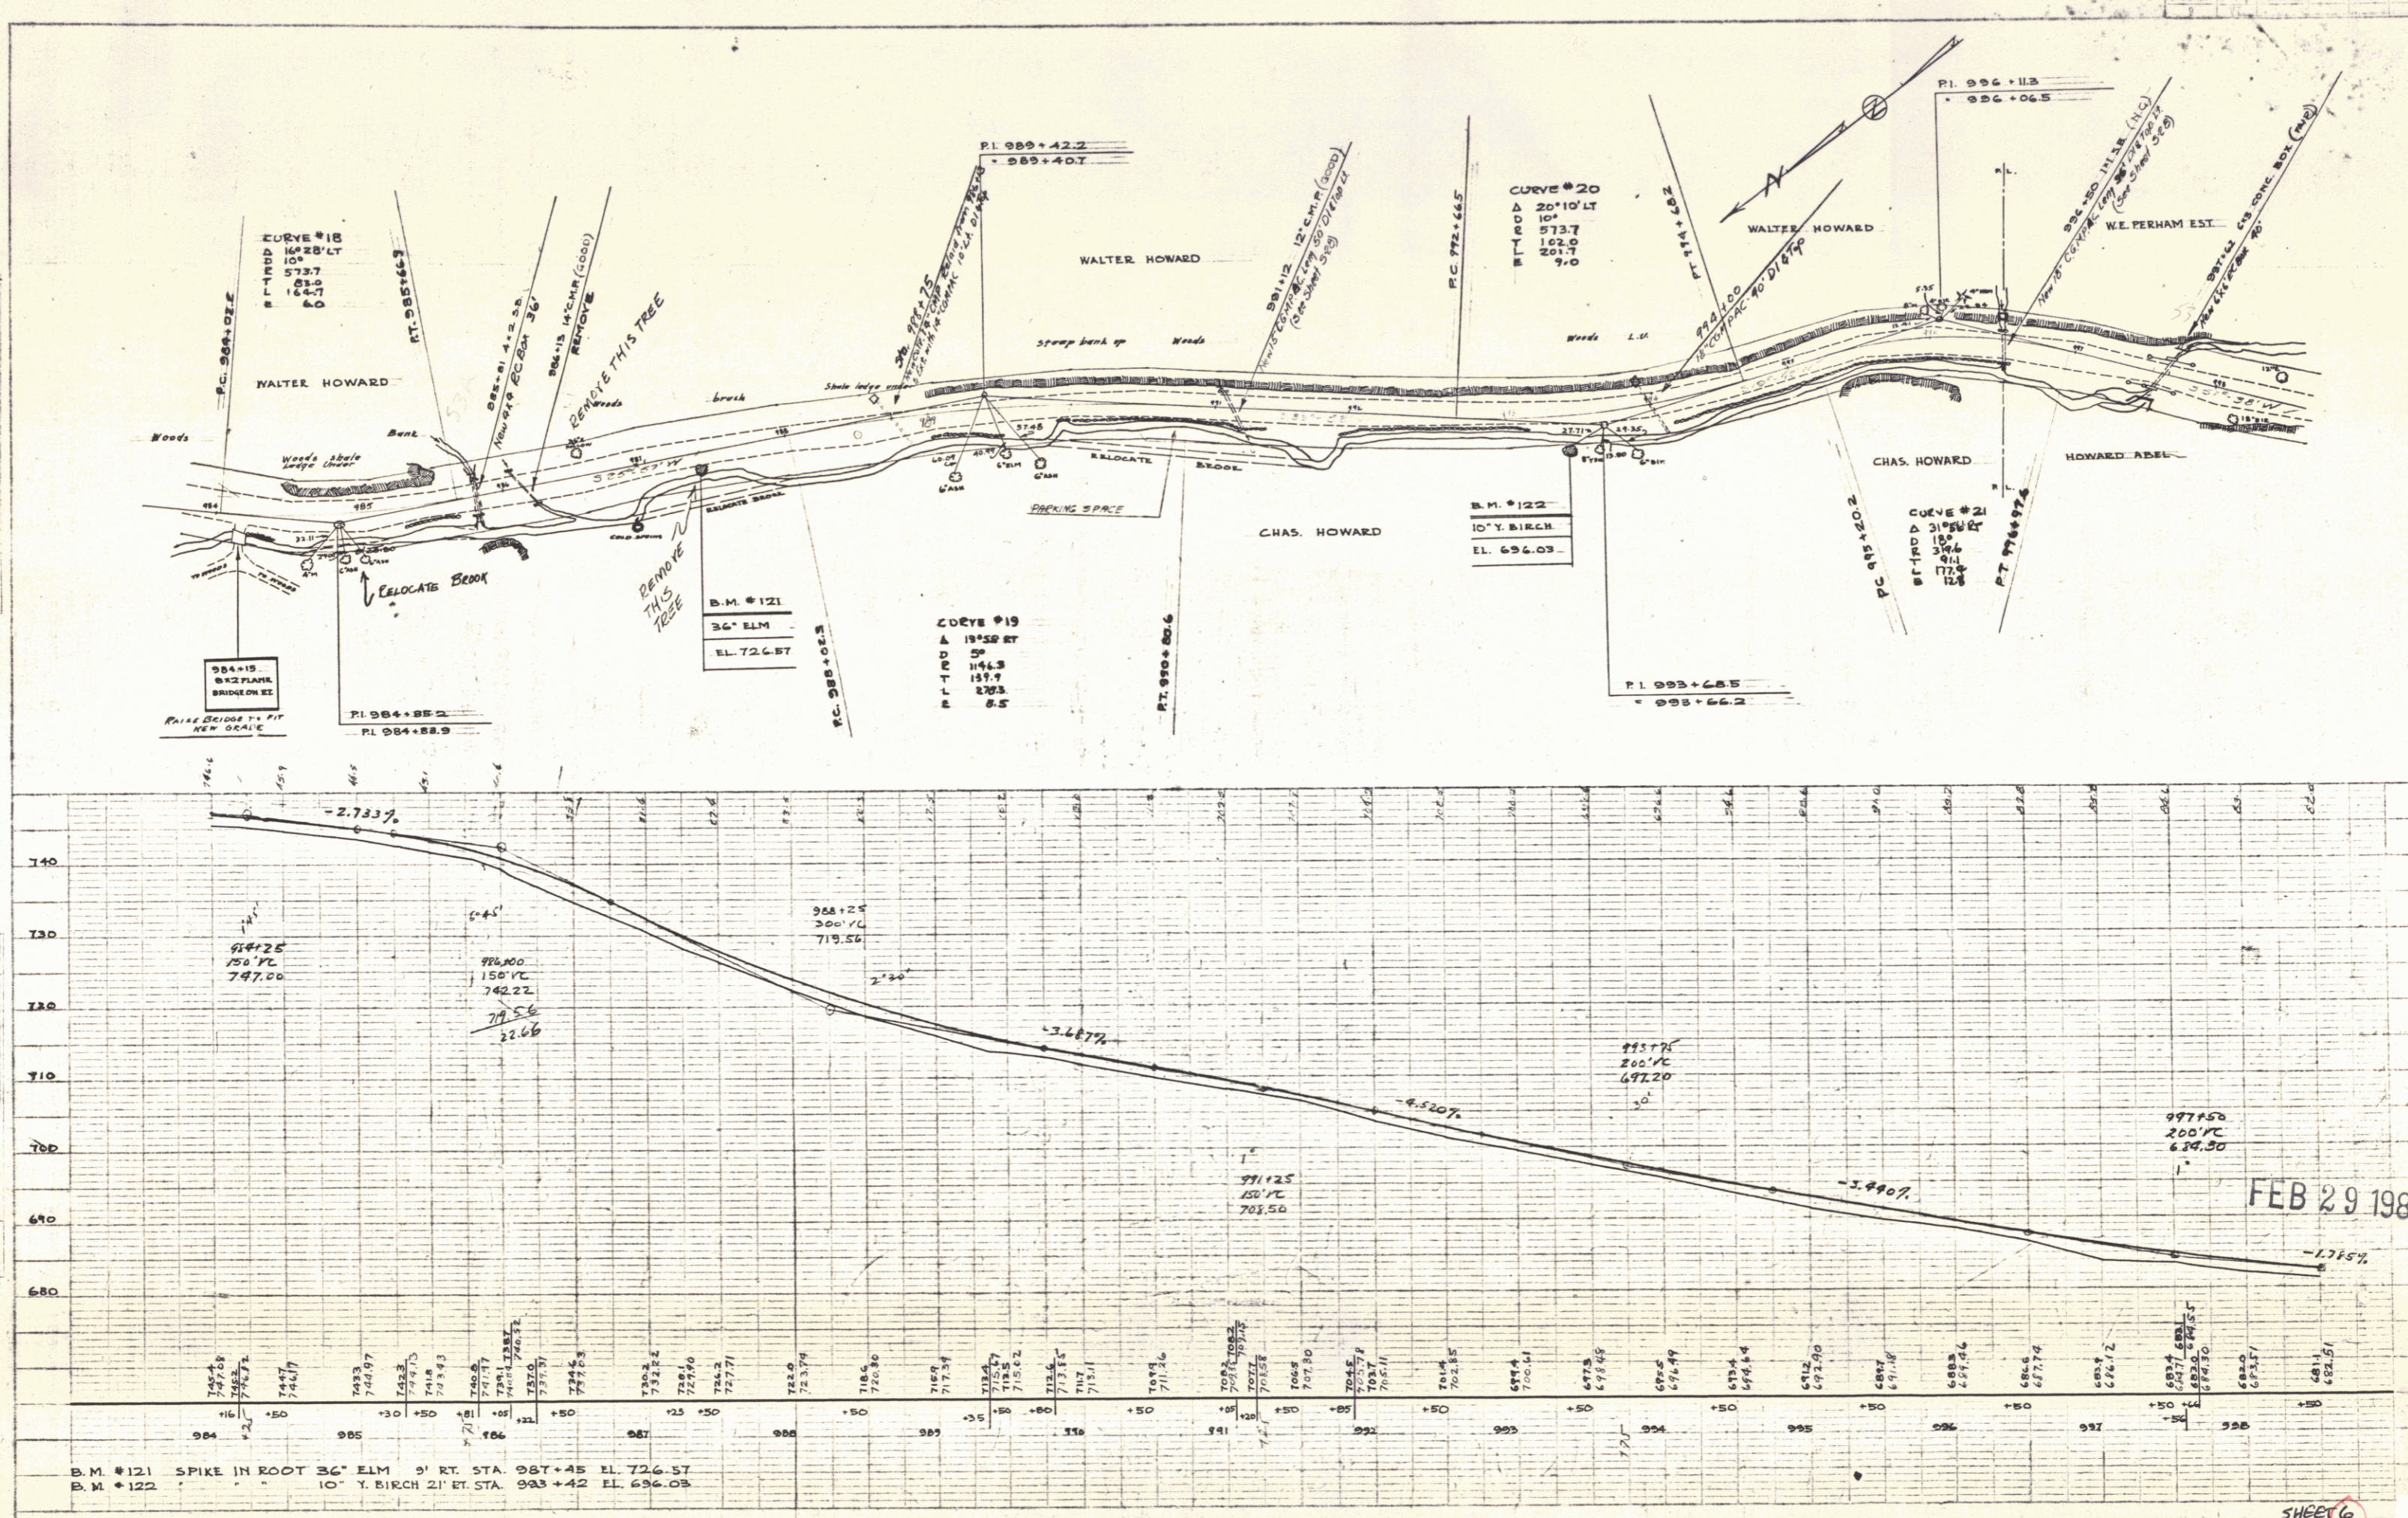

FEB 29 1980

SHEET 6

PLAN
 C. E. POTNAM
 D. MACCHI
 7/84
 TRACED
 D. MACCINI
 2/84

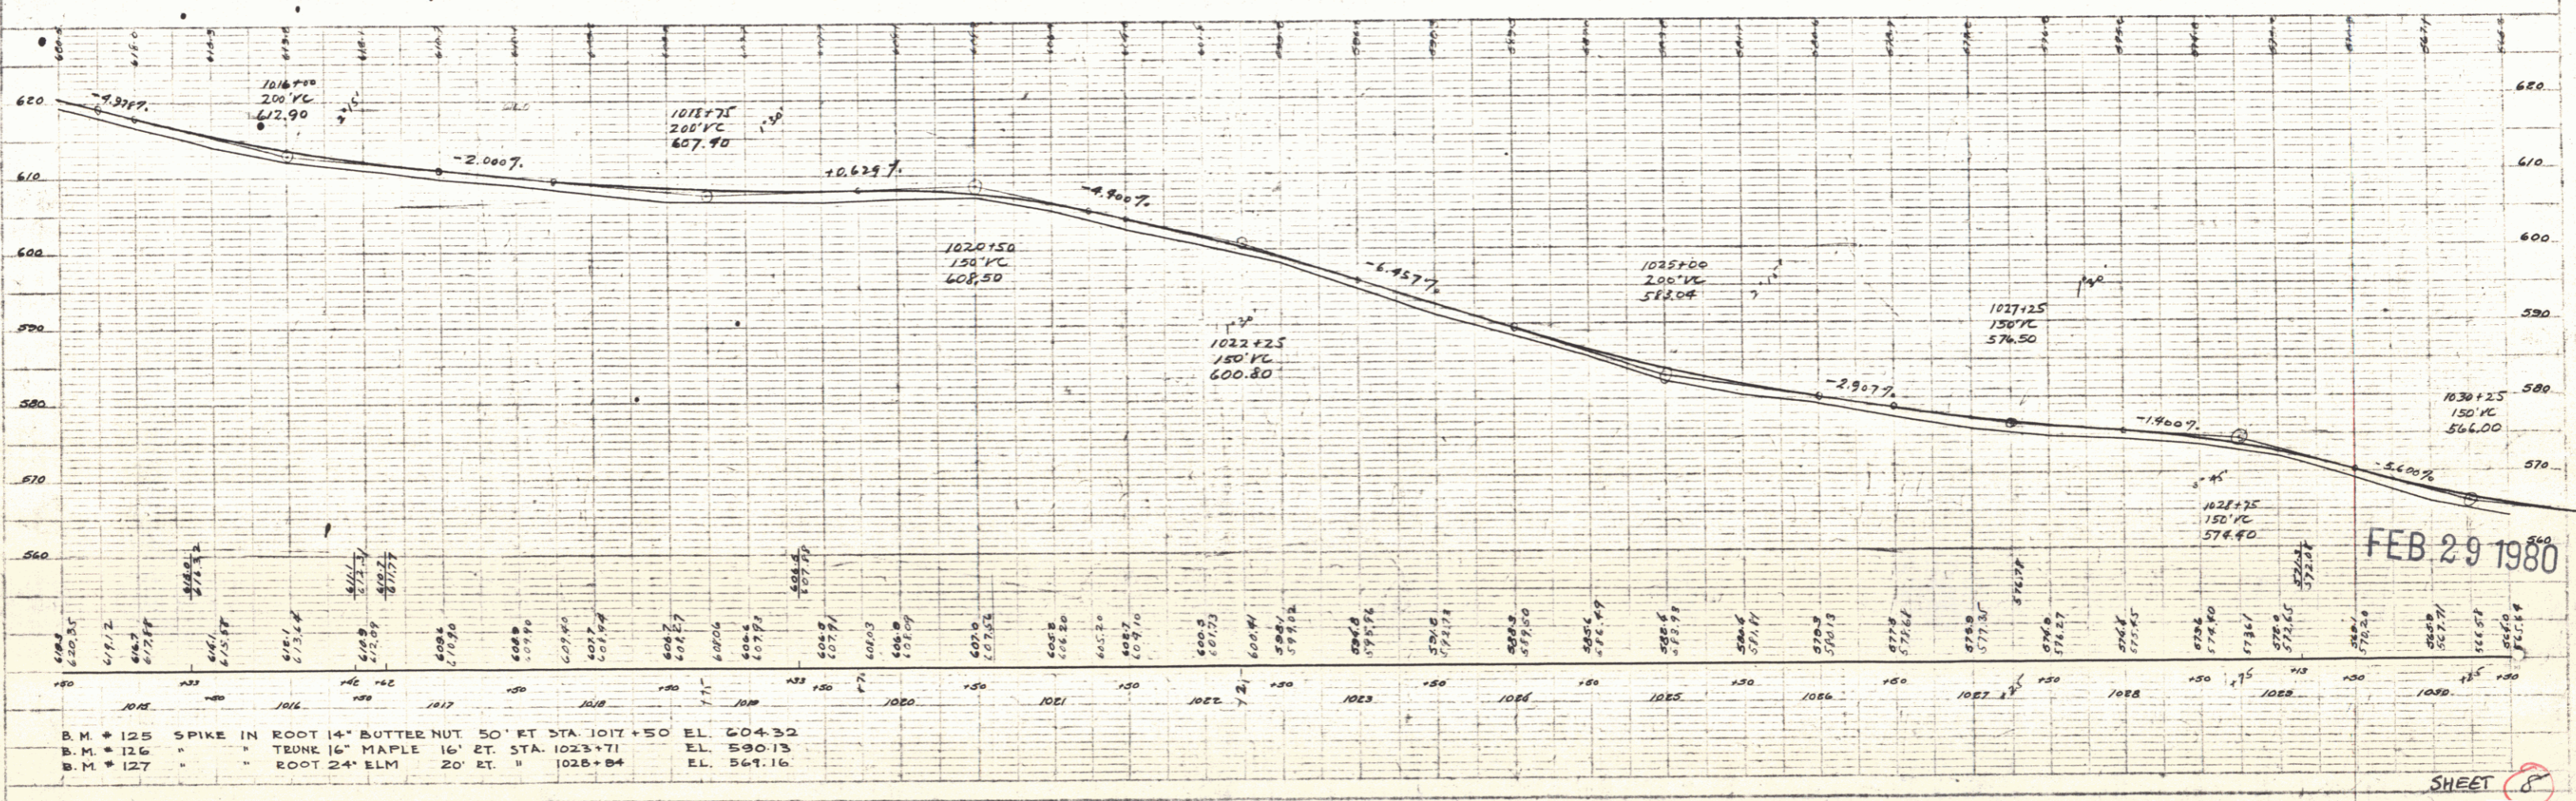
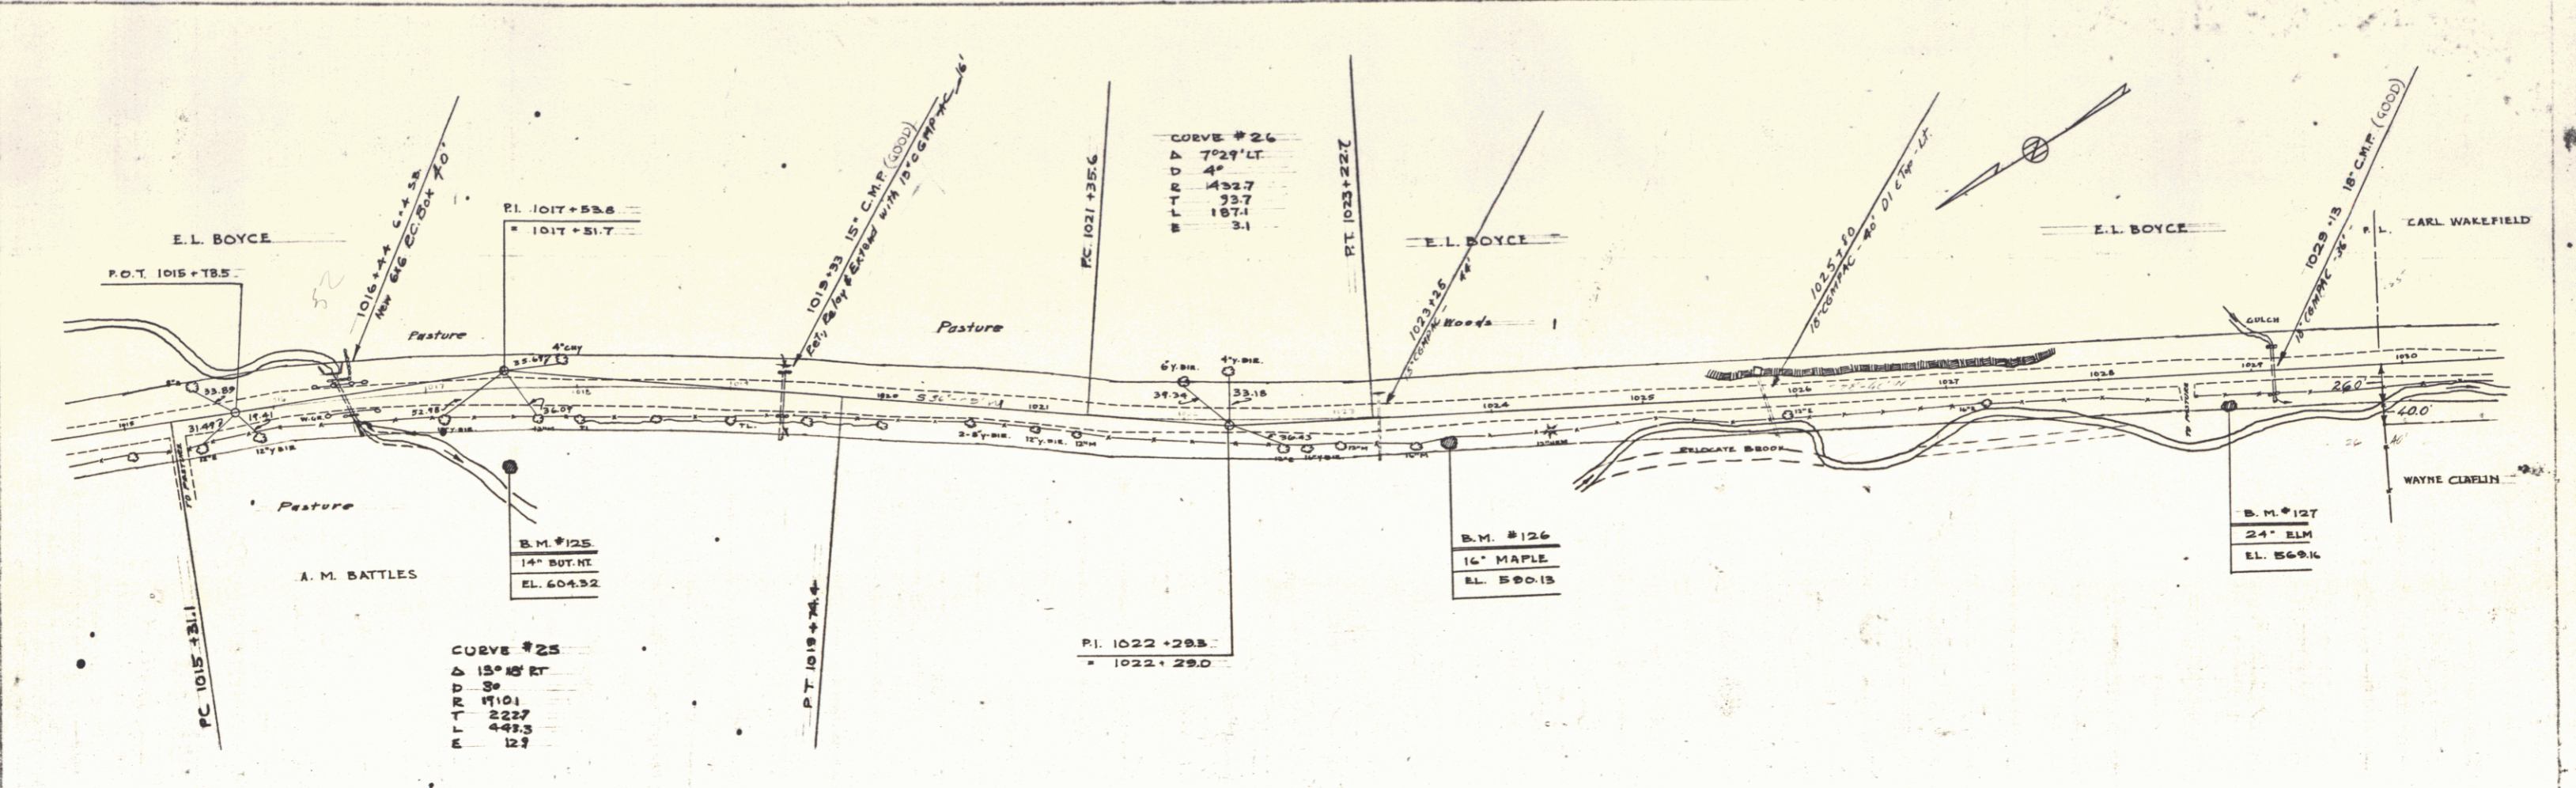


B.M. #125 SPIKE IN ROOT 14' BUTTER NUT 50' ET STA. 1011+50 EL. 604.32
 B.M. #126 " TRUNK 16' MAPLE 16' ET. STA. 1023+71 EL. 590.13
 B.M. #127 " ROOT 24' ELM 20' ET. " 1028+84 EL. 569.16

FEB. 29 1980

SHEET 8

PLAN
 C. E. POTNAM 2/74
 D. MACCHI 2/74
 D. MACCHI 2/74

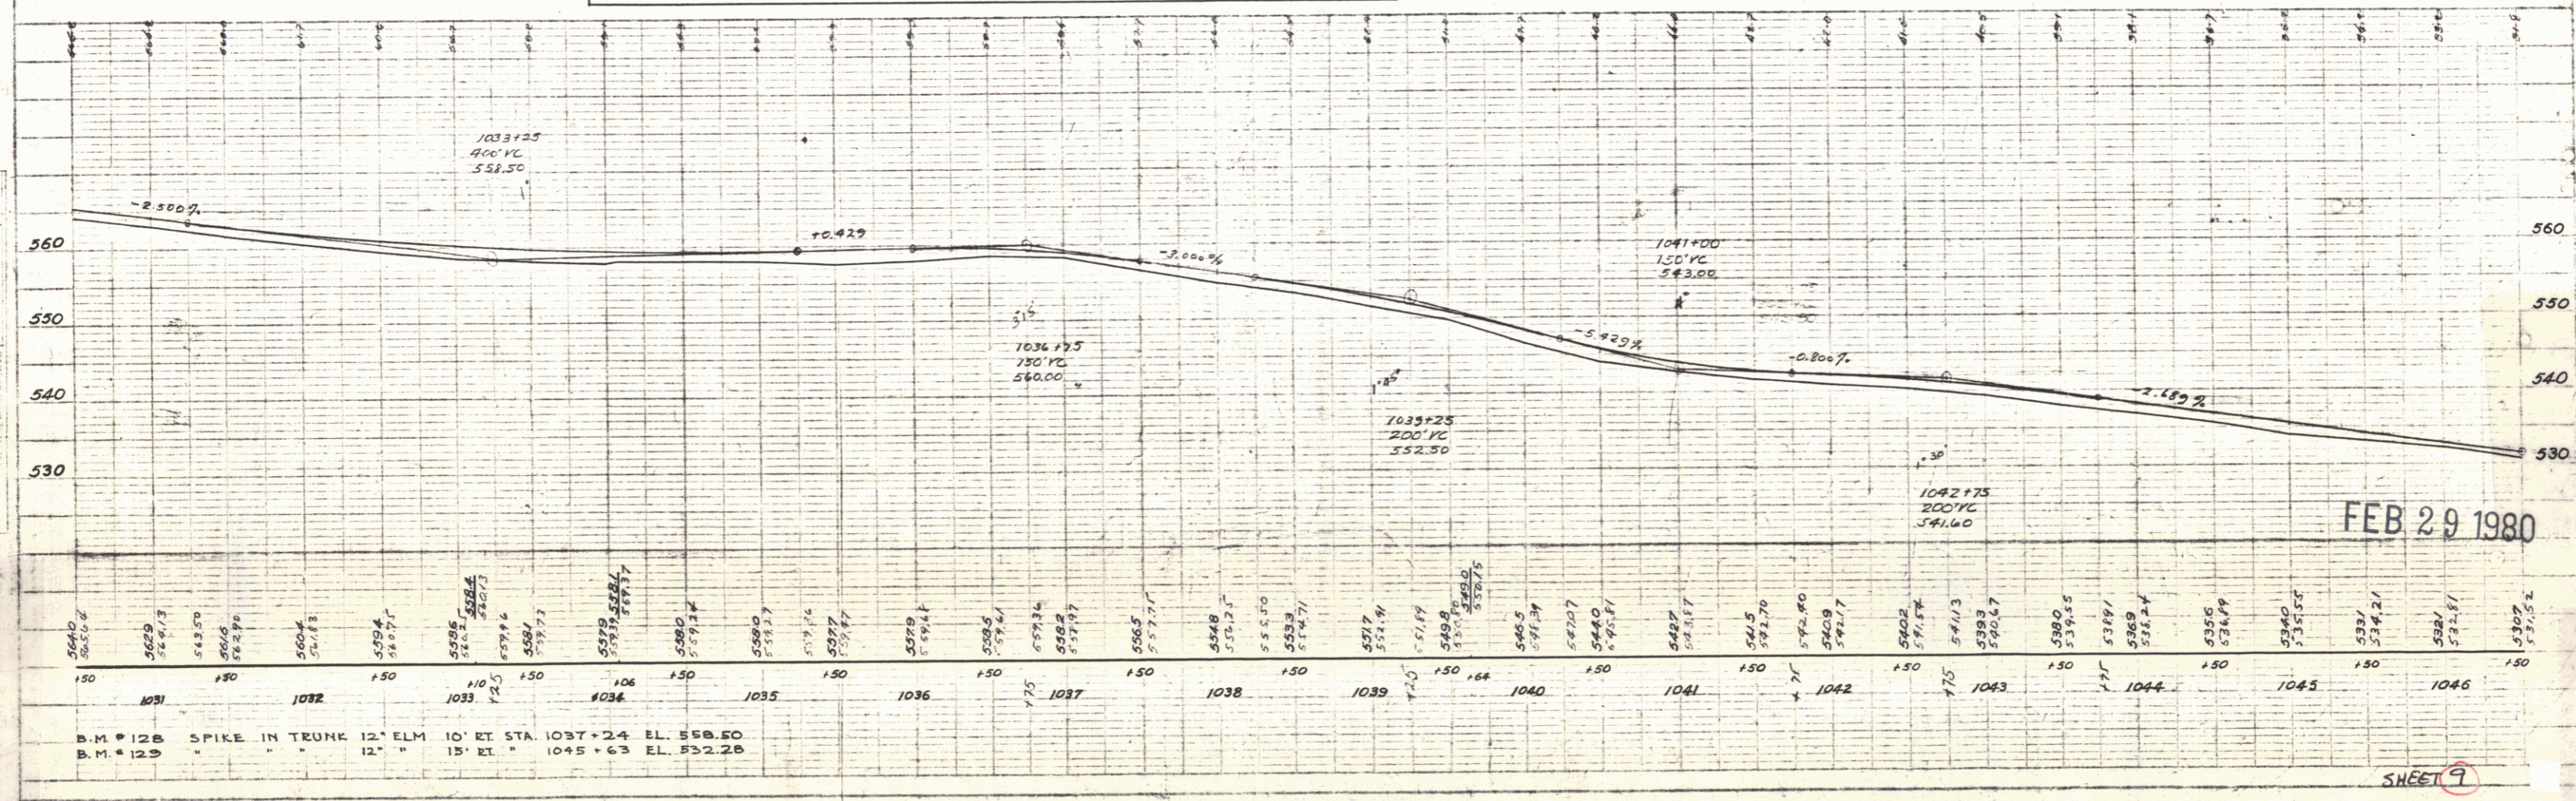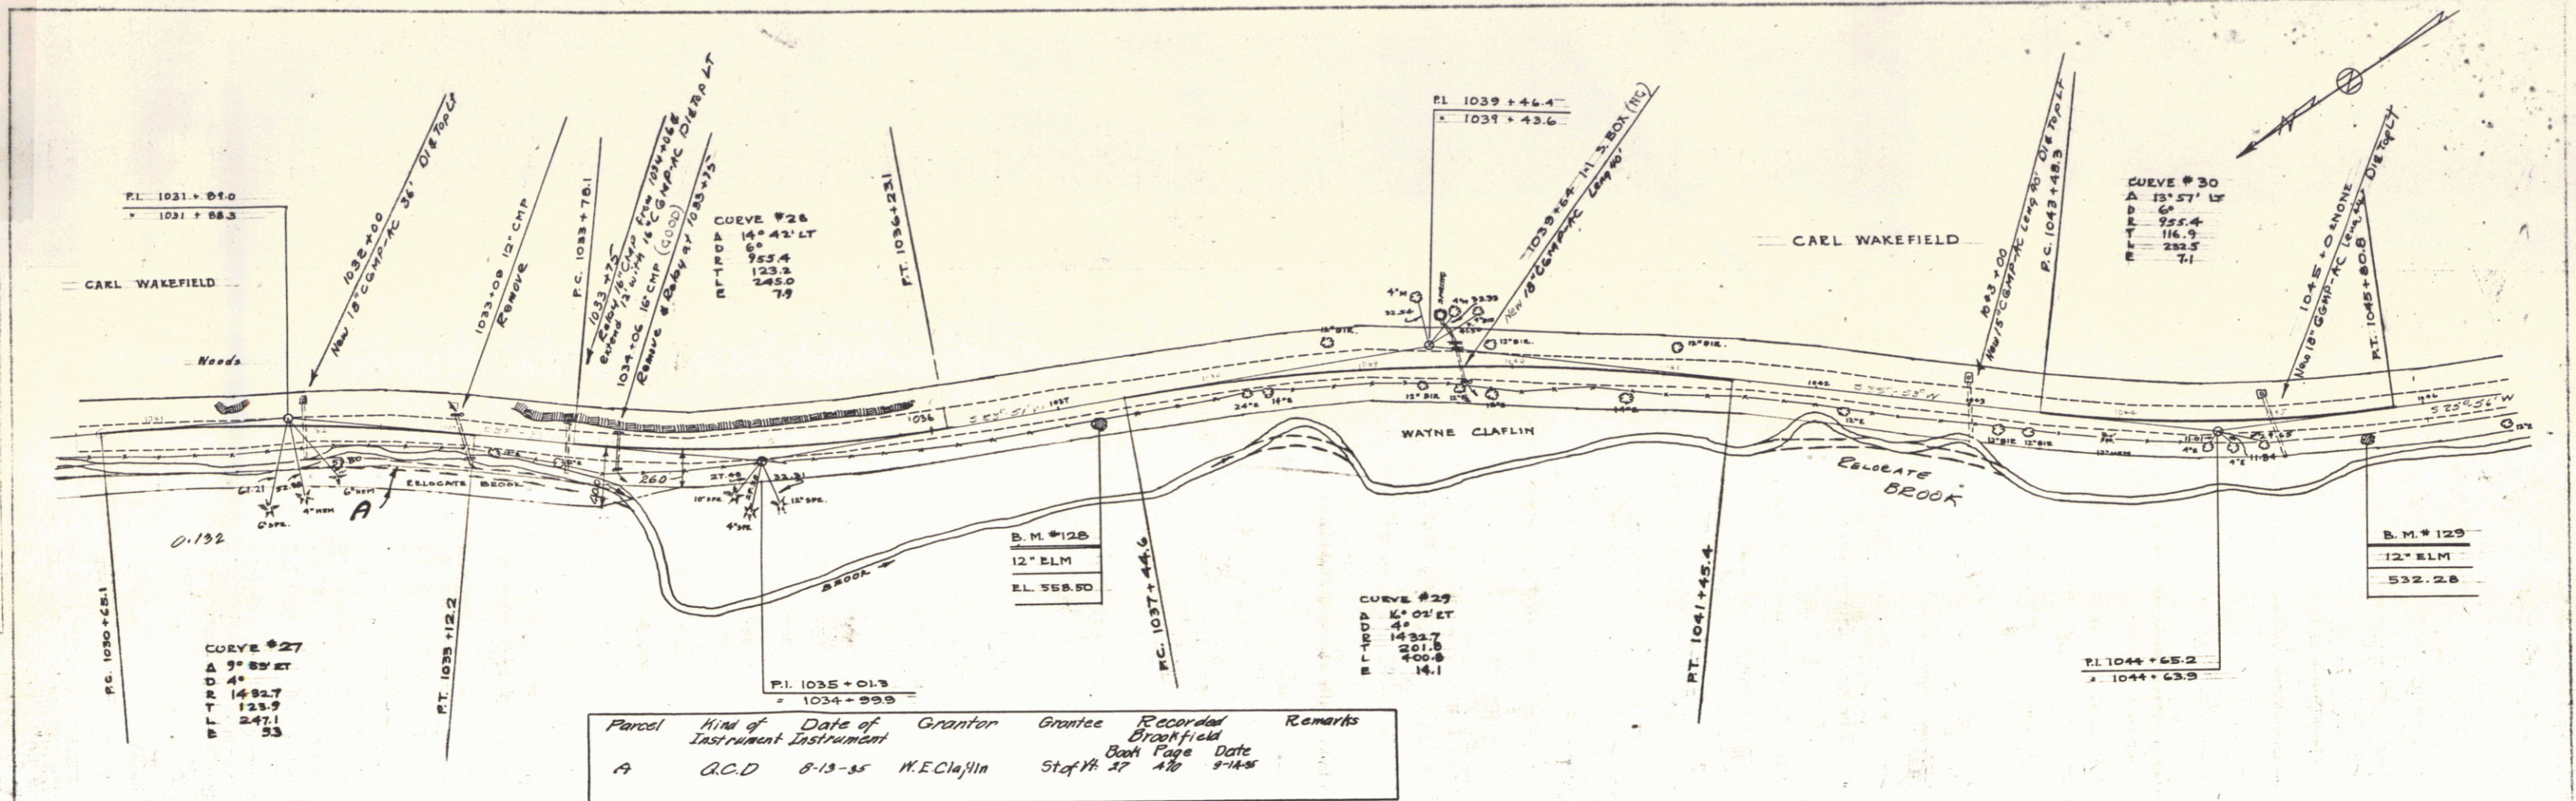

FEB 29 1980



B.M. #128 SPIKE IN TRUNK 12" ELM 10' RT STA. 1037+24 EL. 558.50
 B.M. #129 SPIKE " " 12" " 15' RT. 1045+63 EL. 552.28

SHEET 9

9

Parent Kind of Date of Grant or Grantee Recorded Remarks
 Instrument Instrument Date Book Page Date

TECH
 C.E. PUTNAM
 D. MACCHI
 5/78
 5/85

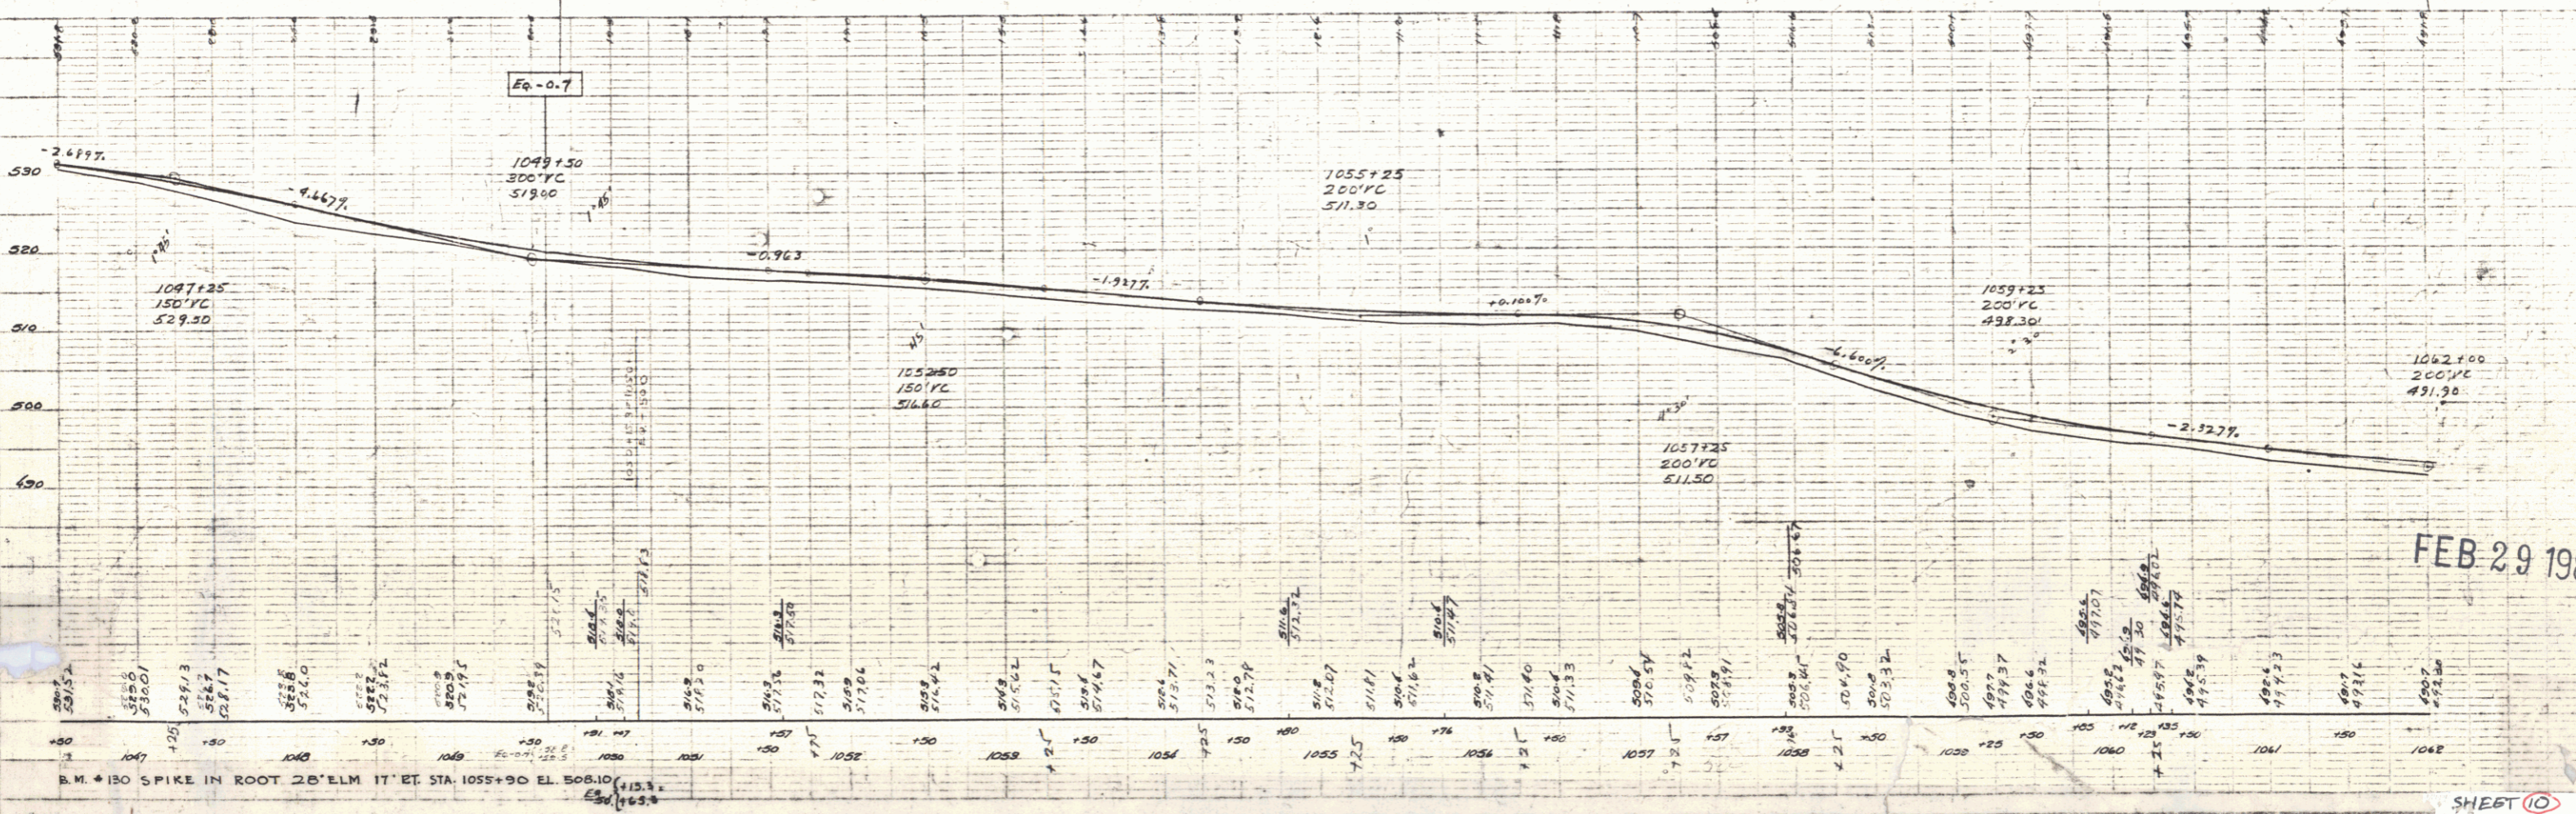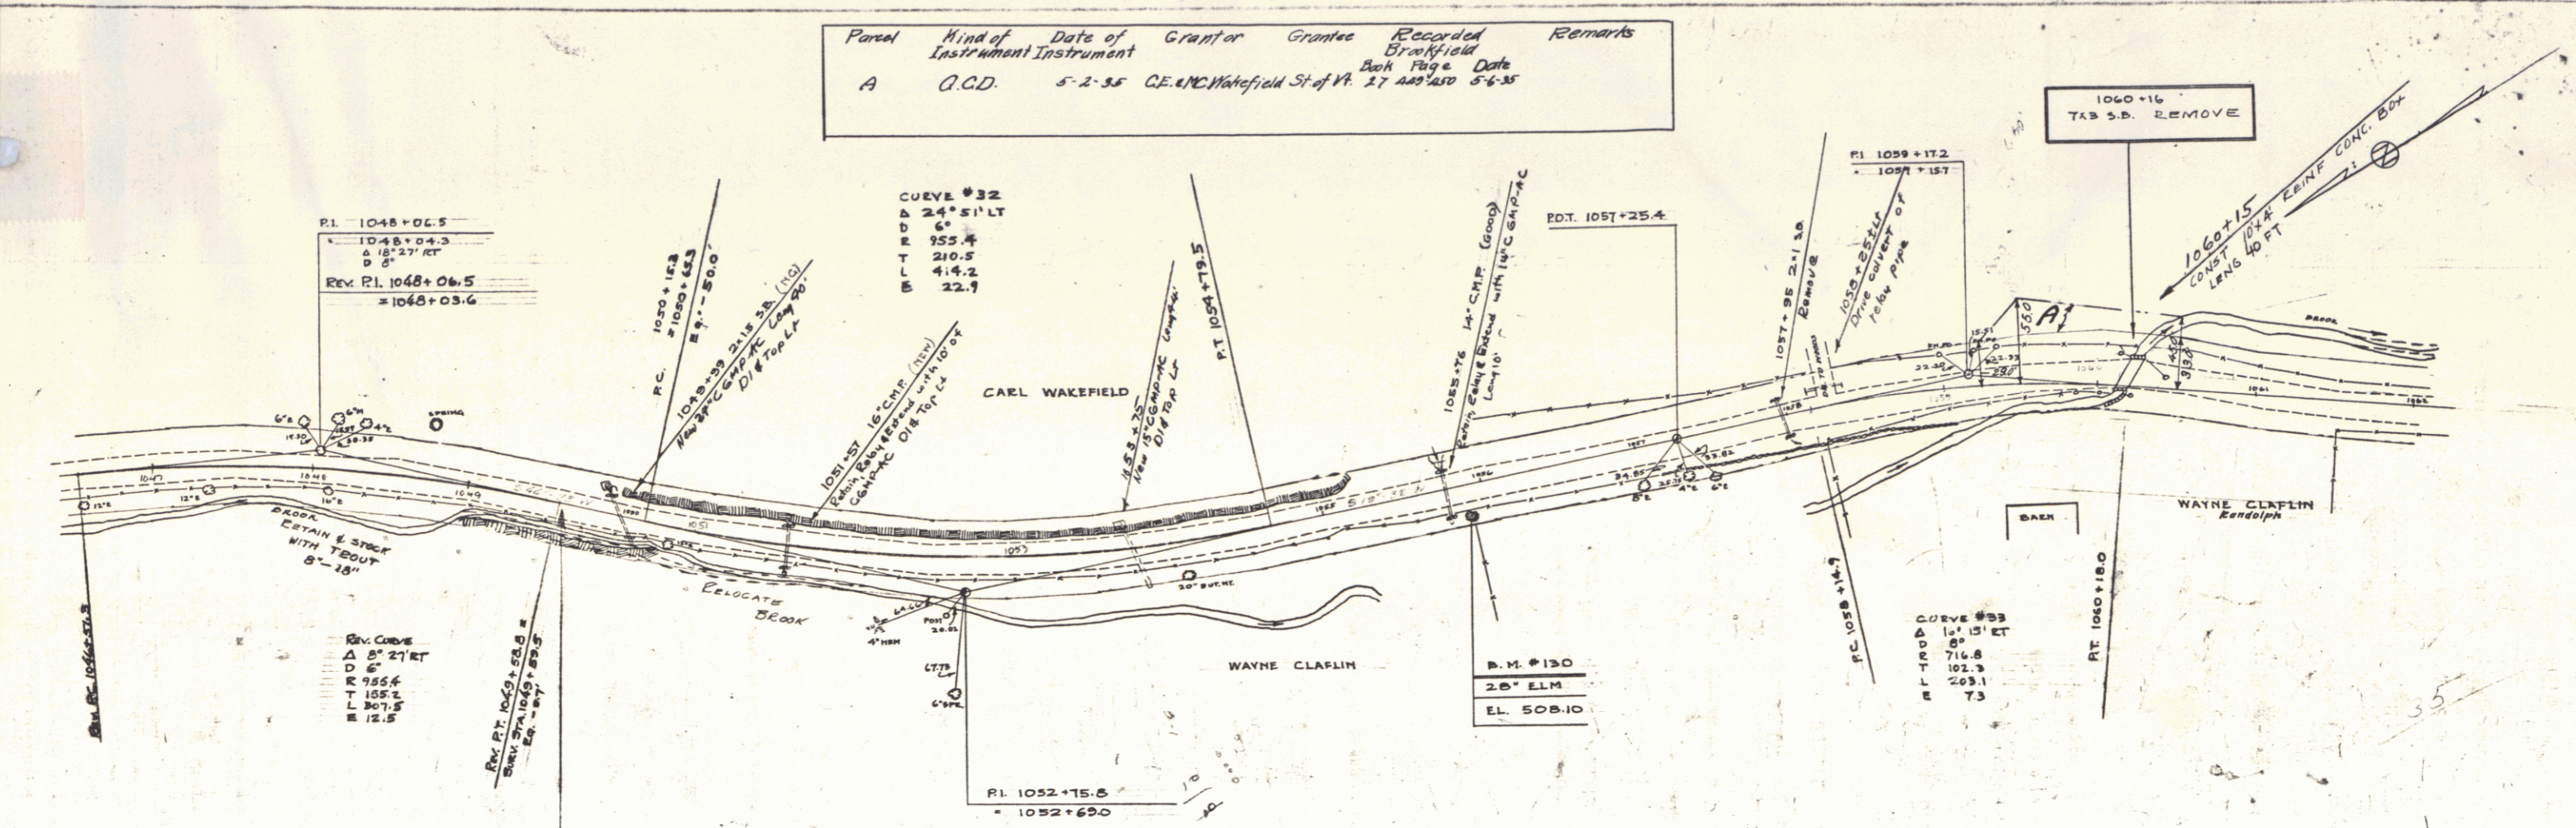

B.M. #130 SPIKE IN ROOT 2" ELM. 17' ET. STA. 1055+90 EL. 508.10

FEB 29 1980

SHEET 10