

PLAN	DATE	BY
REVISED		
NOTE FROM		
ALIGNED CHECKED		
BY		
NO.		

PROFILE	DATE	BY
REVISED		
NOTE FROM		
ALIGNED CHECKED		
BY		
NO.		

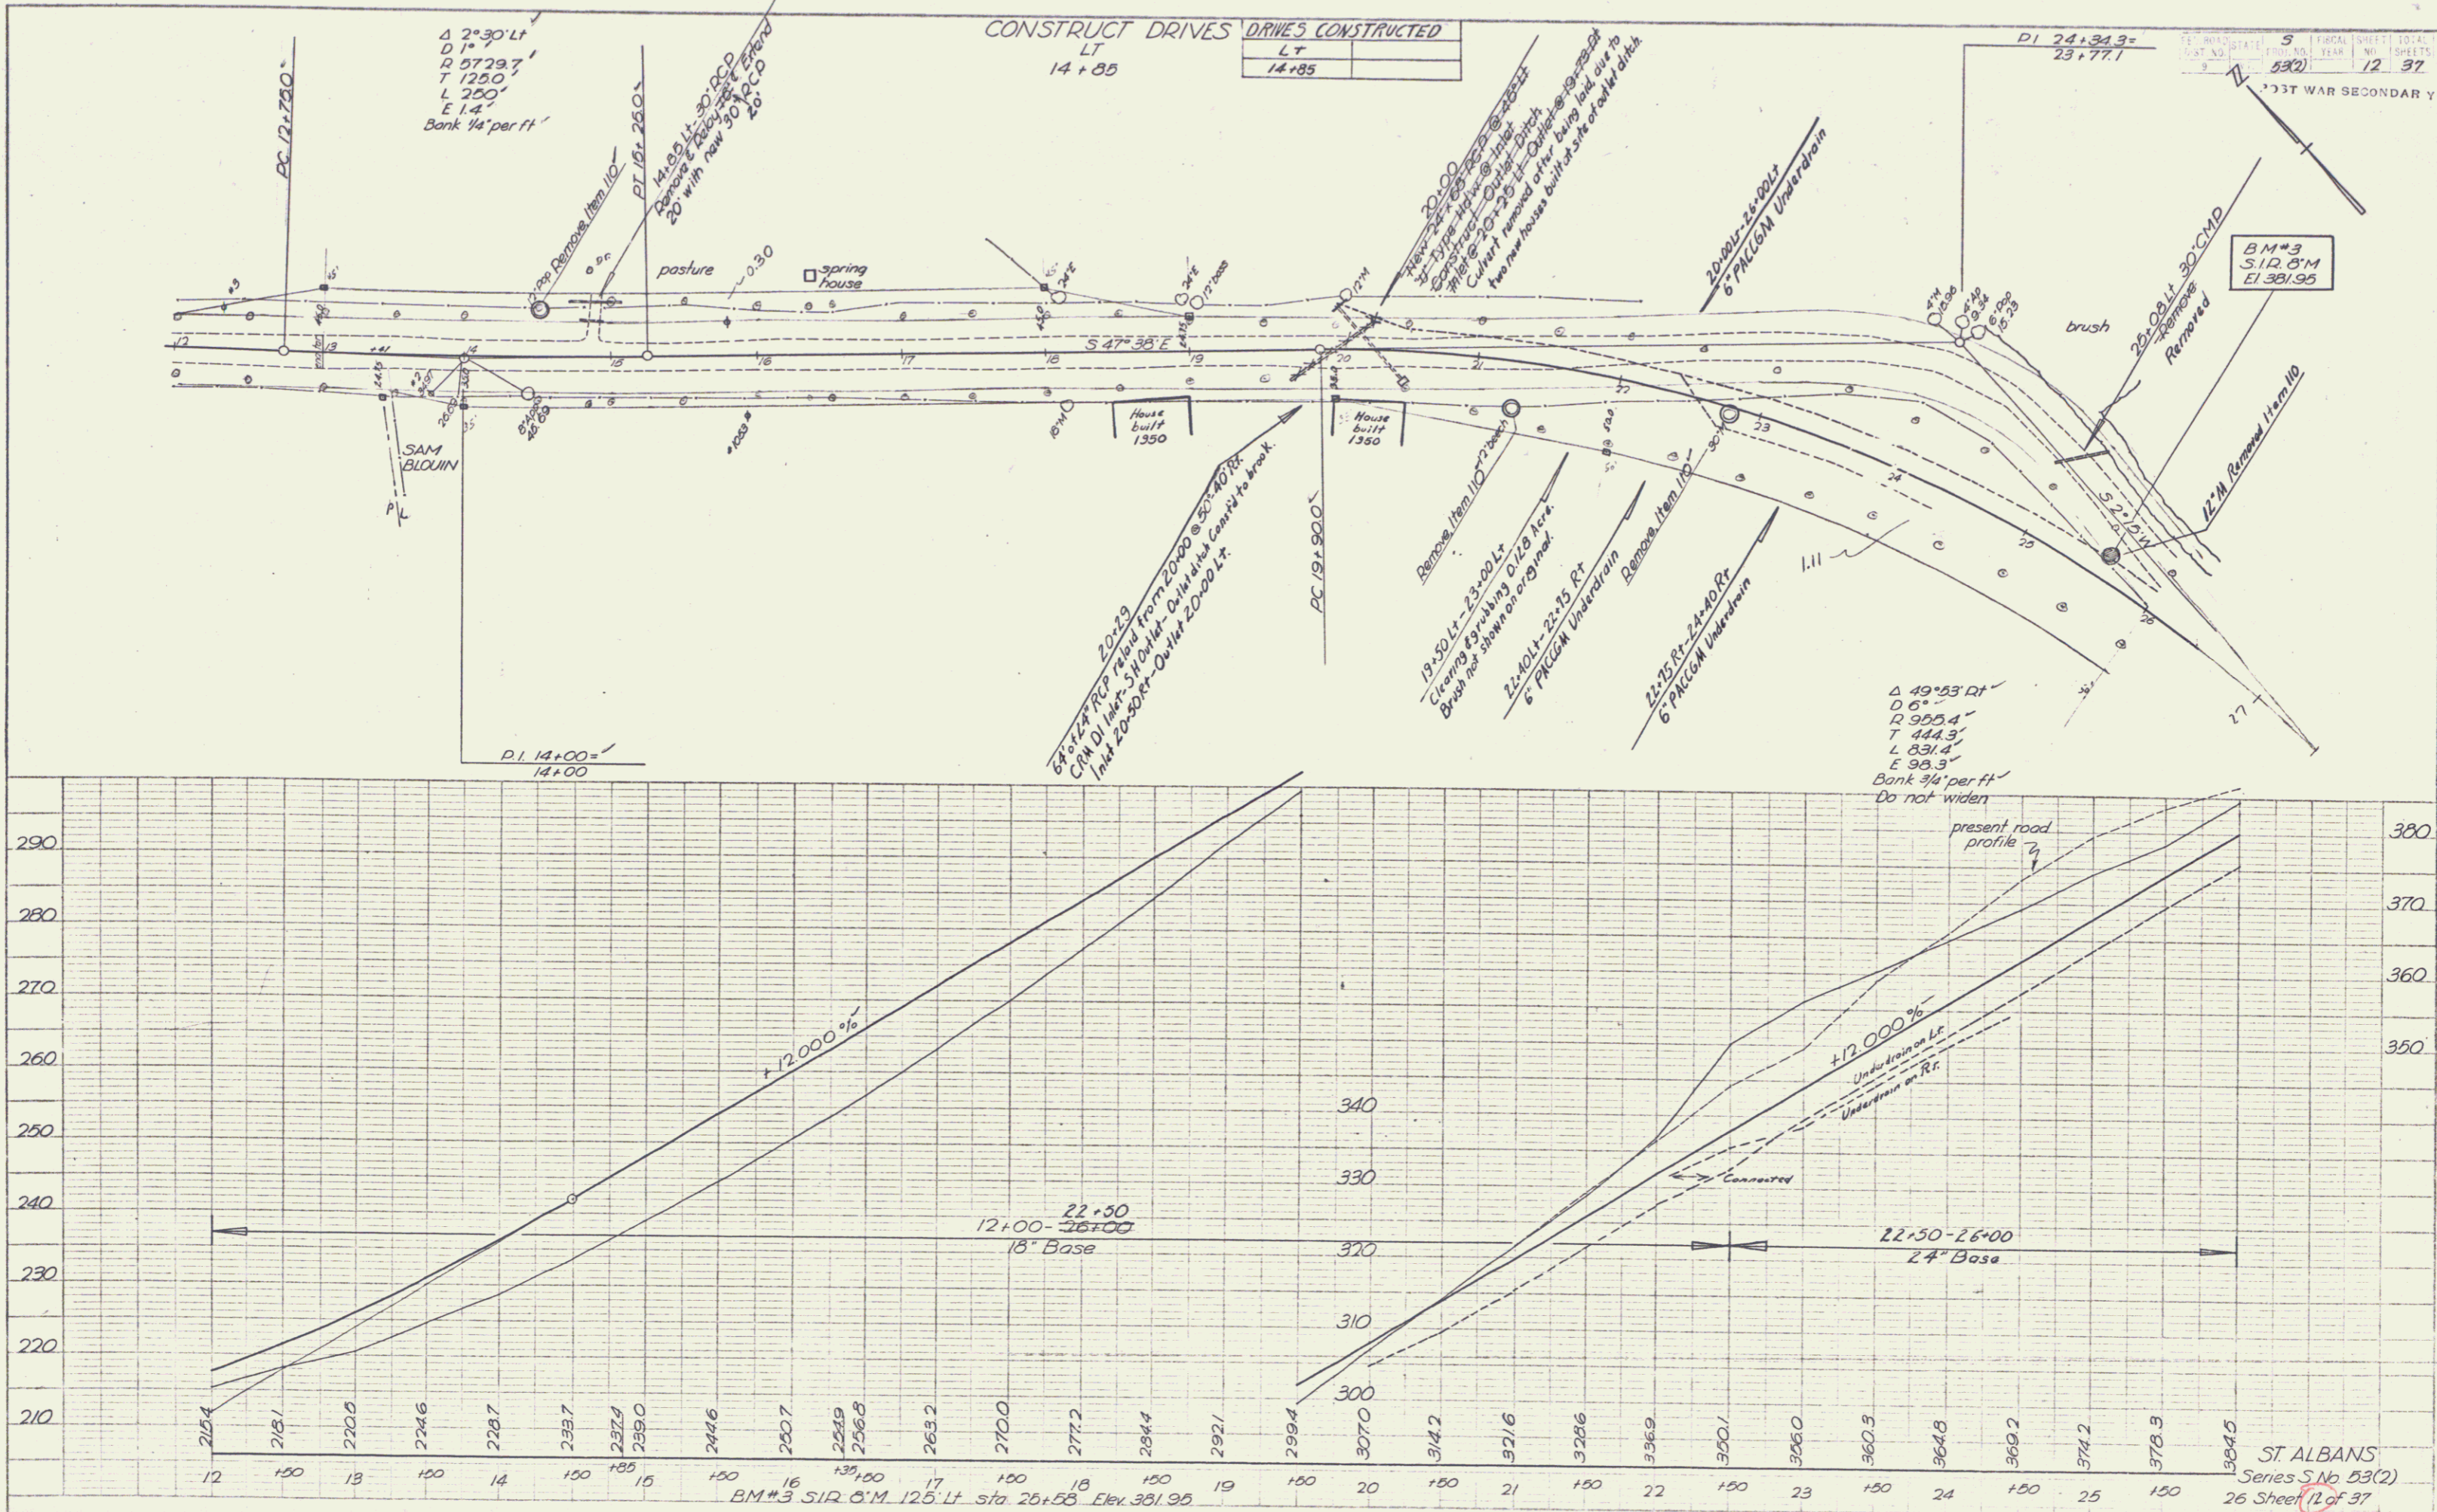


