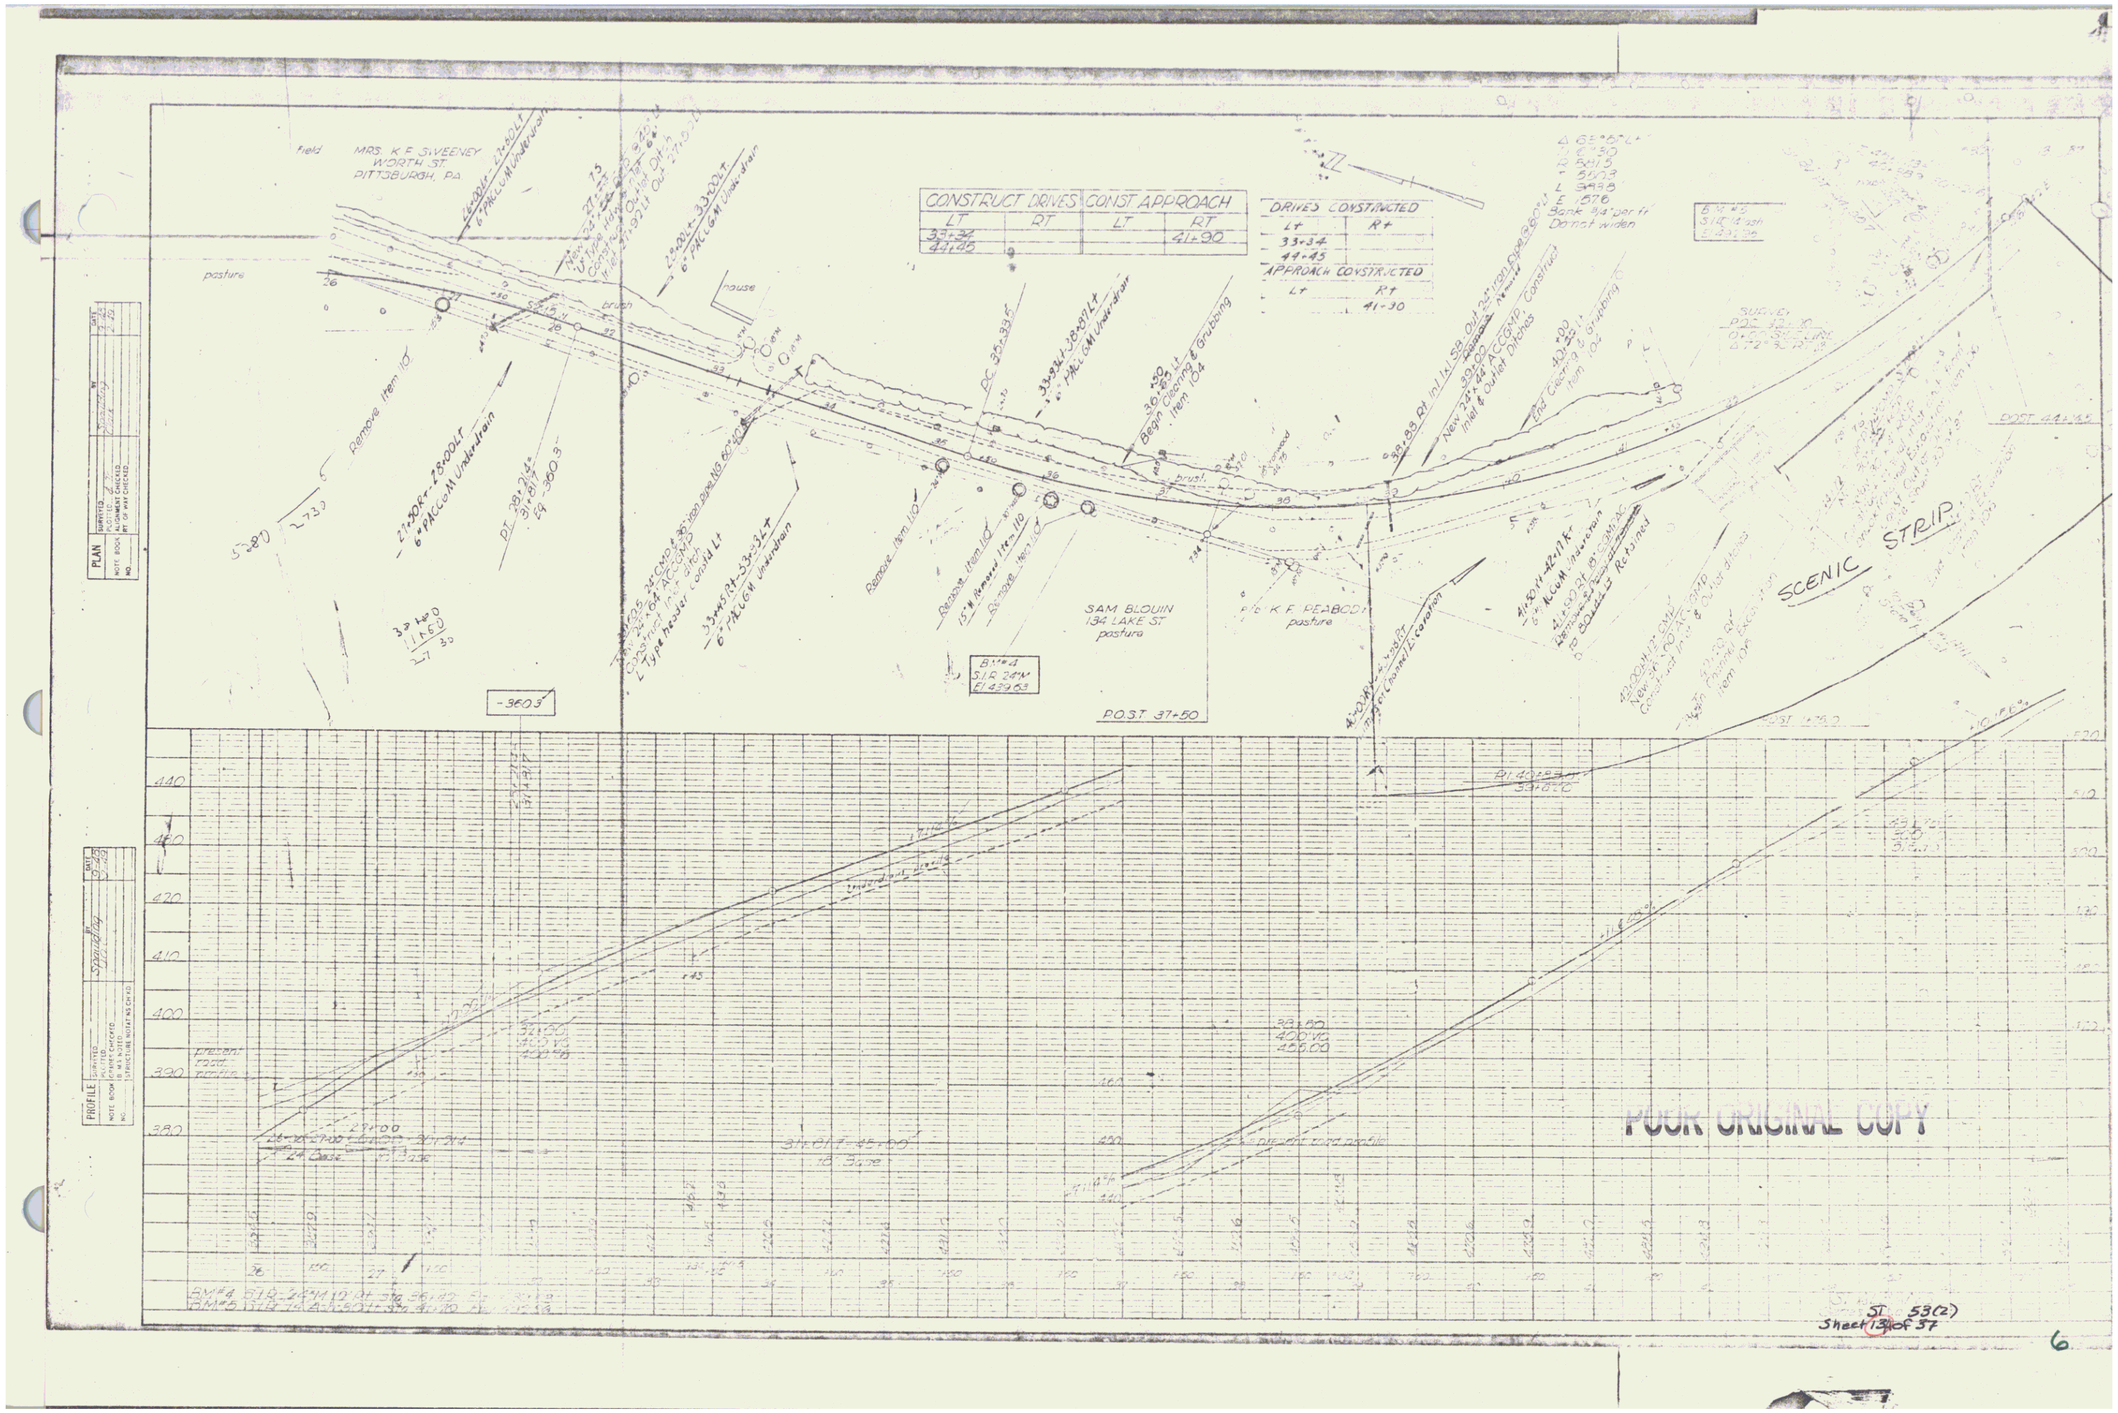

ST 53(2)
Sheet 13 of 37

6