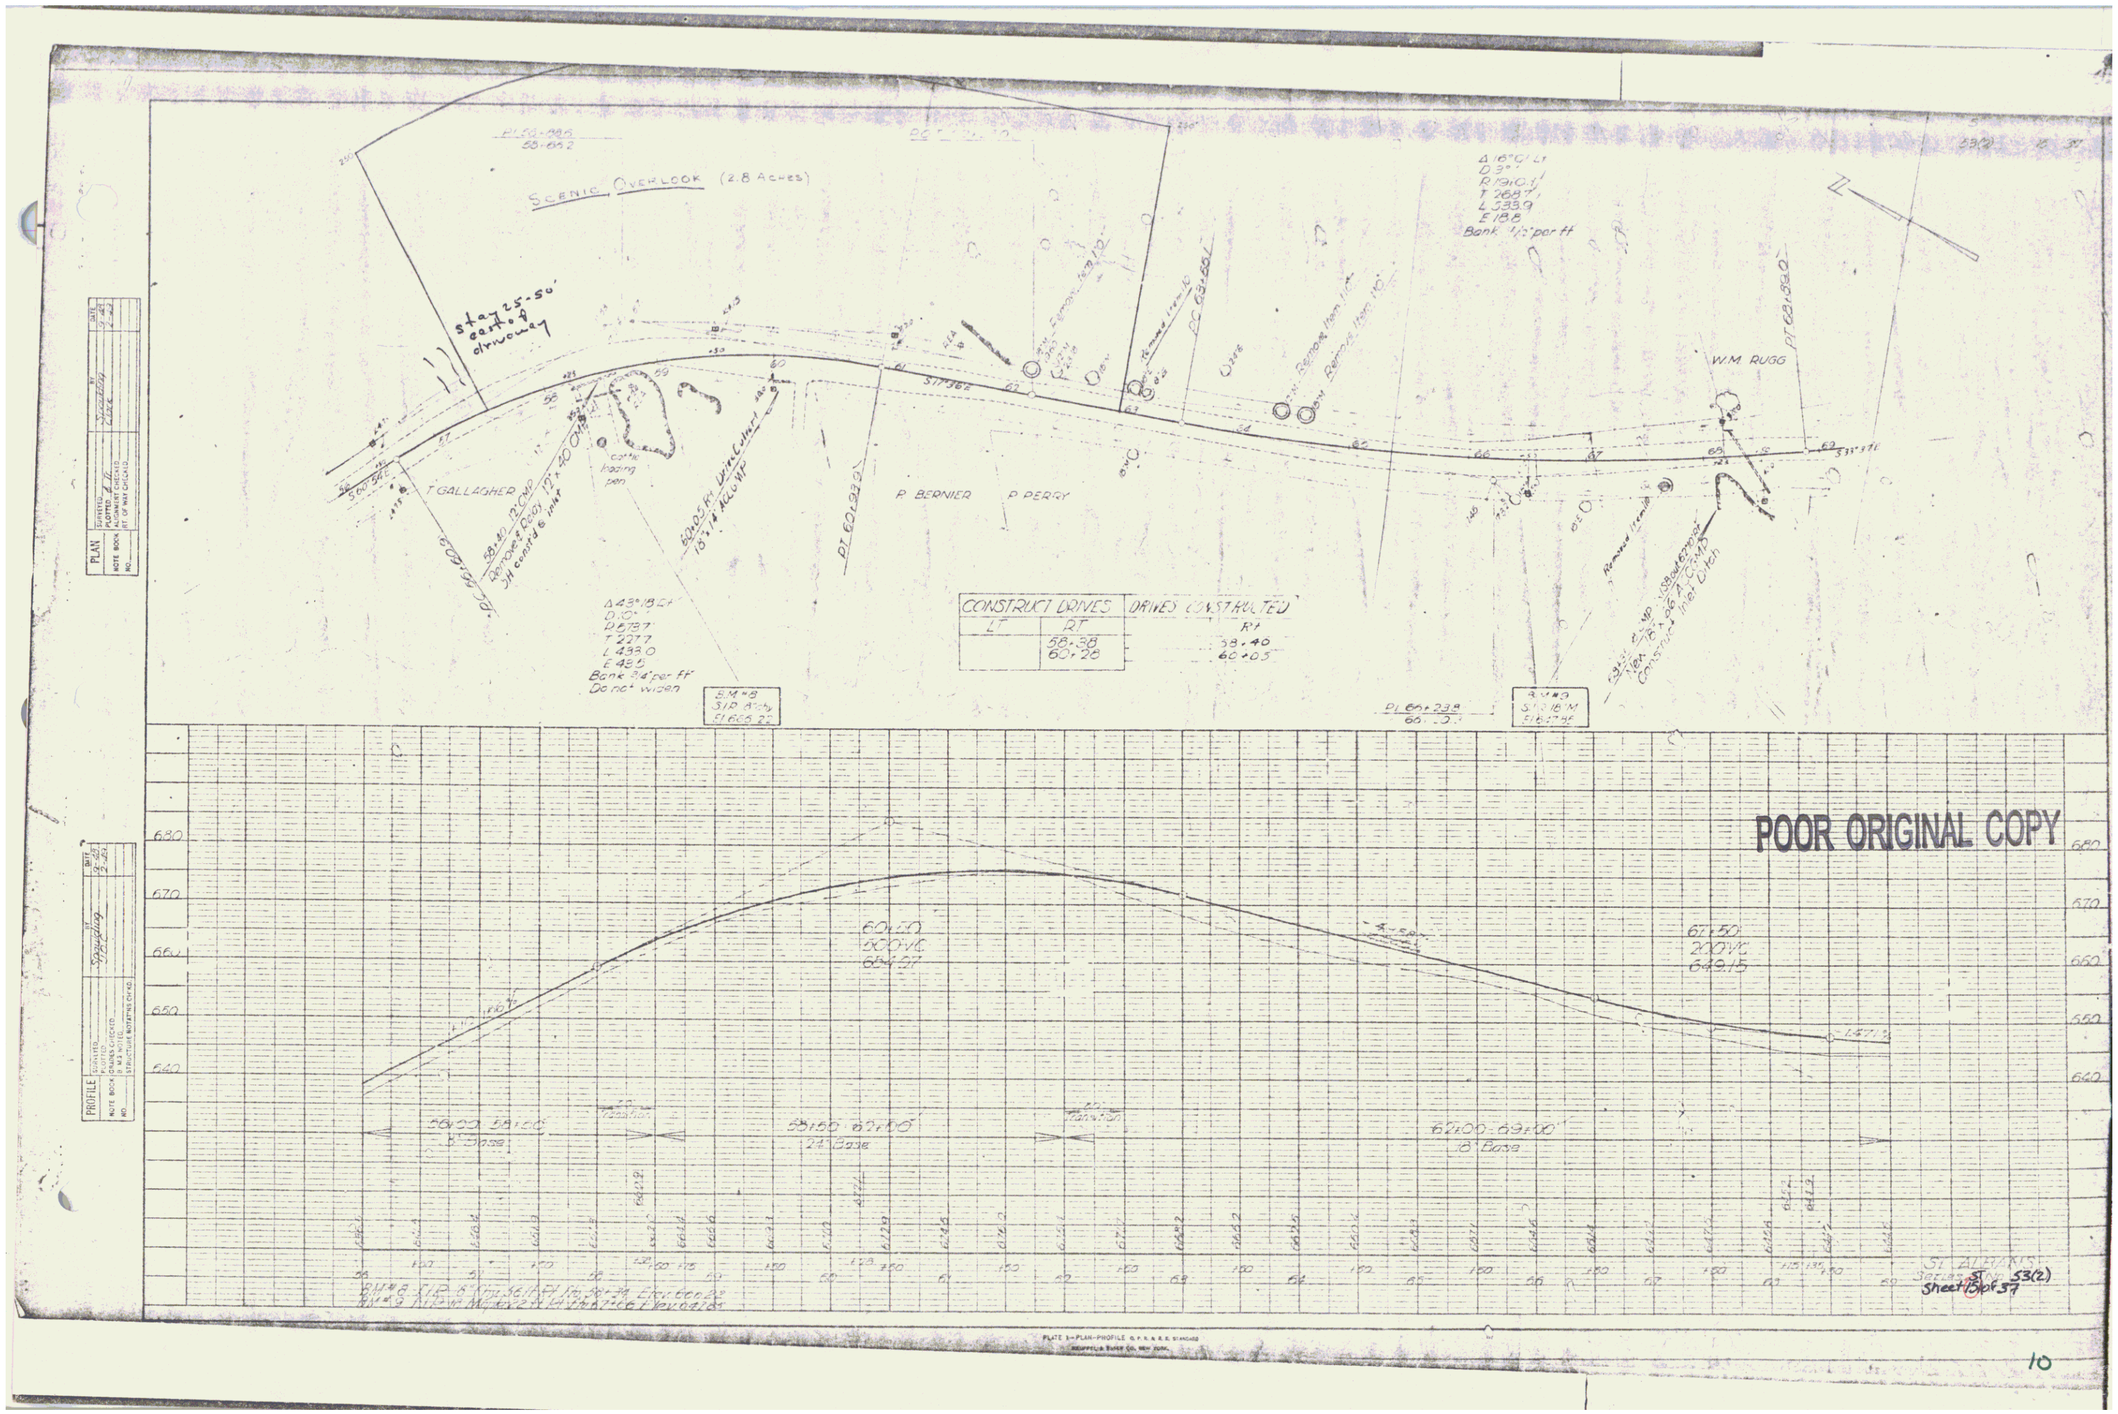
SCENIC OVERLOOK (2.8 Acres)
T GALLAGHER
P. BERNIER
P. PERRY
W.M. RUGG
POOR ORIGINAL COPY