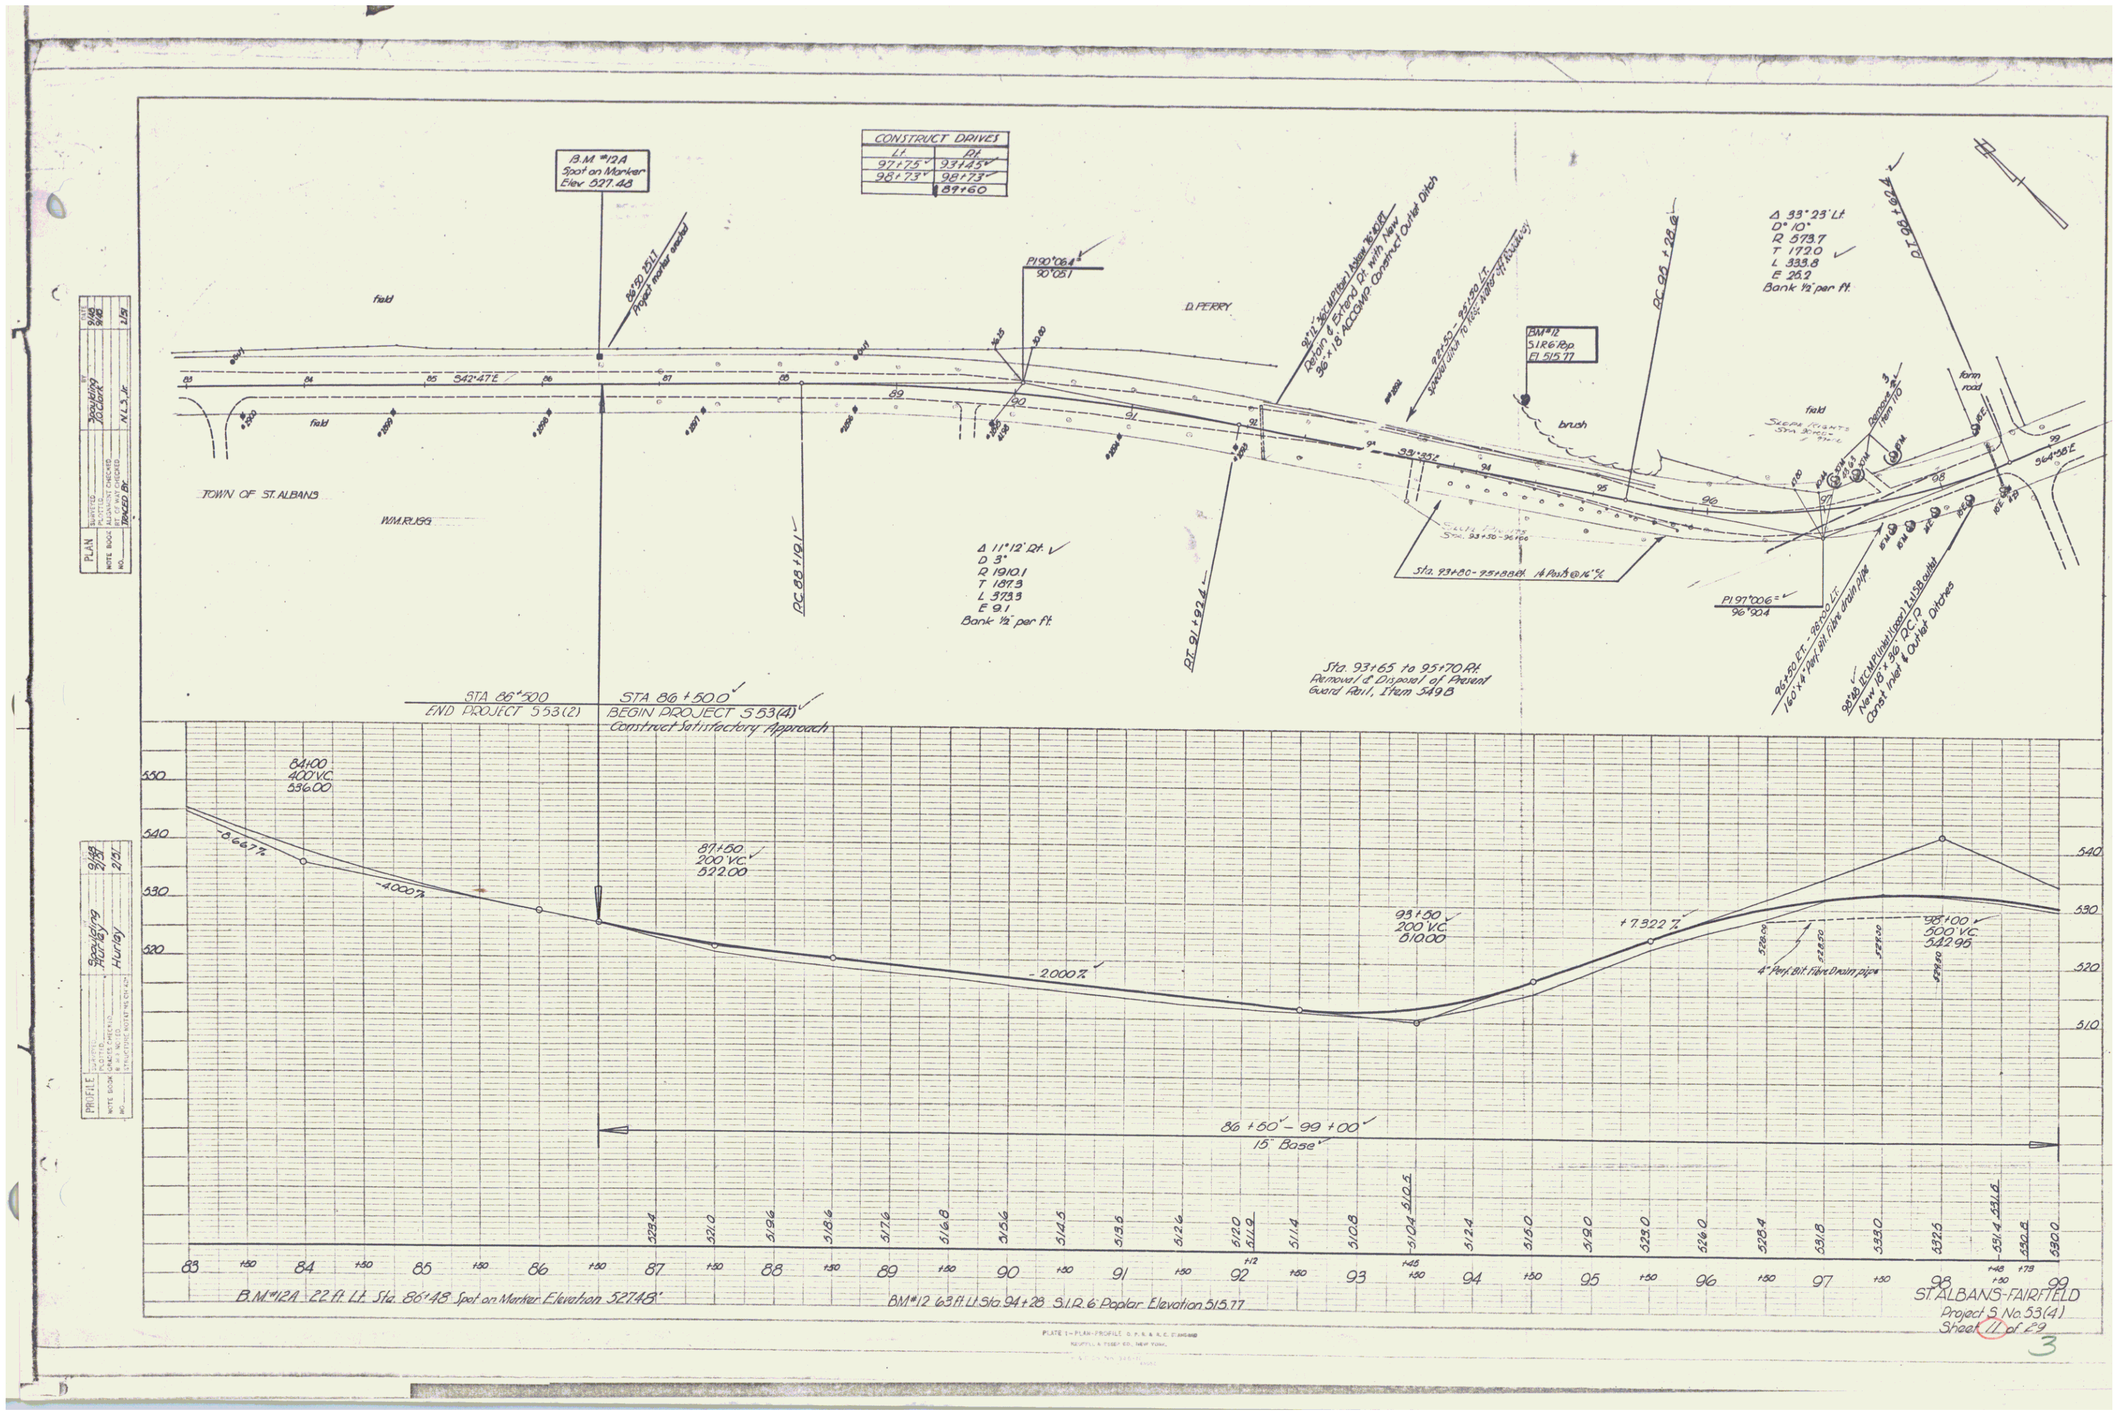
B.M. #12A
Spot on Marker
Elev 527.48
CONSTRUCT DRIVES
Lt. Rt.
97+75 93+45
98+73 98+73
89+60
field
D. PERRY
TOWN OF ST. ALBANS
W.M.R.J.59
S42°47'E
Δ 11°12' Rt.
D 3°
R 1910.1
T 187.3
L 373.3
E 9.1
Bank ½" per ft.
Sta. 93+65 to 95+70 Rt.
Remove & Dispose of Present
Guard Rail, Item 349B
Sta. 93+80 - 95+88 Rt. 14 Posts @ 16'%
BM #12
51.R6 Rp
El. 515.77
brush
Δ 33°23' Lt
D° 10°
R 573.7
T 172.0
L 333.8
E 26.2
Bank ½" per ft.
form road
S64°36'E
STA 86+50
END PROJECT 5.53(2)
STA 86+50.0
BEGIN PROJECT 5.53(4)
Construct Satisfactory Approach
84+00
400 V.C.
536.00
87+50
200 V.C.
522.00
93+50
200 V.C.
510.00
98+00
500 V.C.
542.95
-0.667%
-4.000%
-2.000%
+7.322%
4" Perf. Blt. Fibre Drain pipe
86+50 - 99+00
15' Base
B.M. #12A 22 ft. Lt. Sta. 86+48 Spot on Marker Elevation 527.48'
BM #12 63 ft. Lt. Sta. 94+28 S.I.R. 6 Poplar Elevation 515.77
ST. ALBANS-FAIRFIELD
Project S. No. 53(4)
Sheet 11 of 29
3