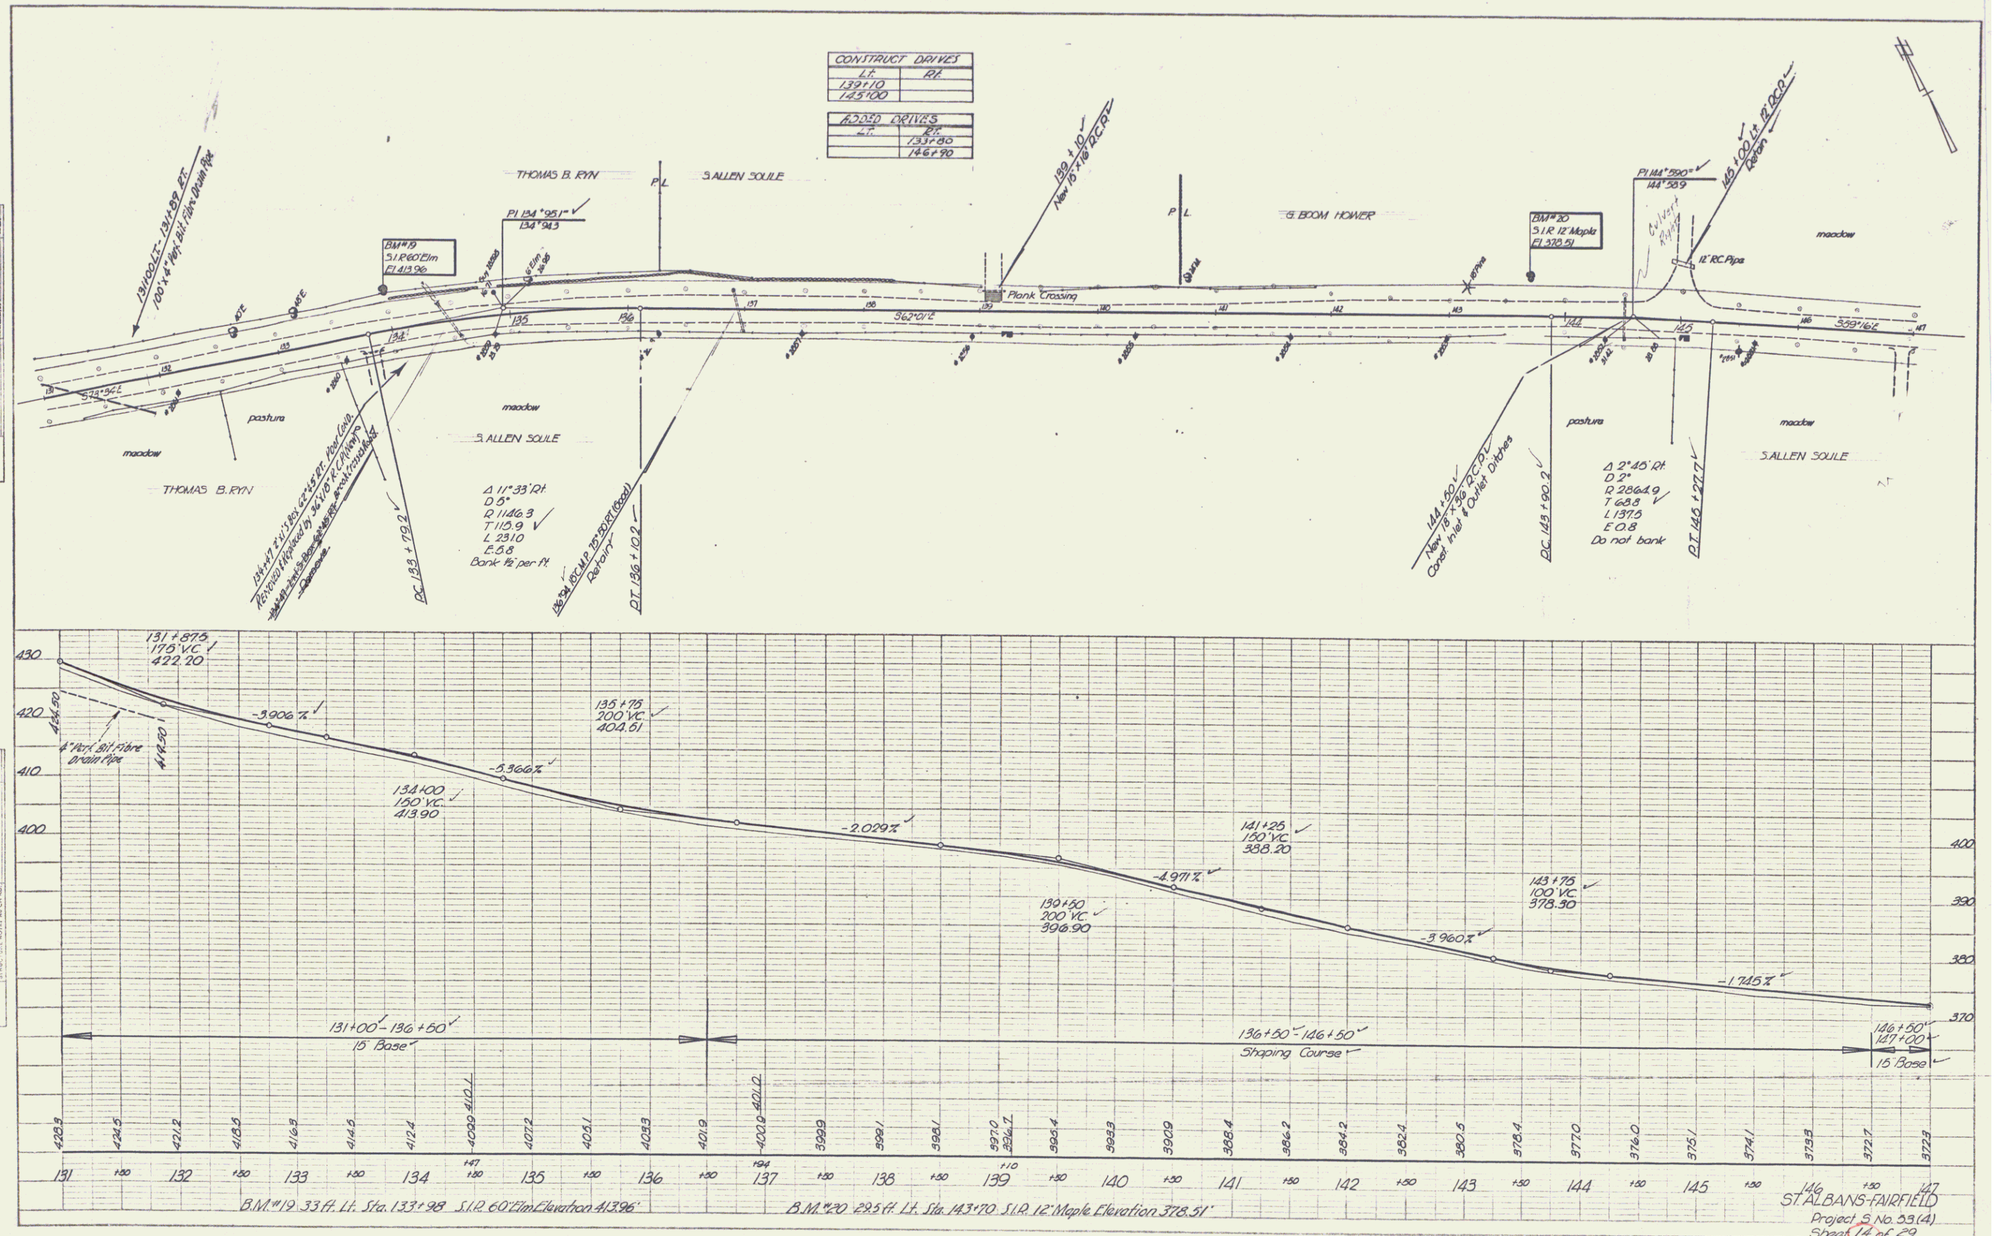

PLAN
SURVEYED 2/90
PLOTTED 2/90
COMPUTATIONS CHECKED
PT. OF WAY CHECKED
NOTE BOOK
NO.
Louis Murray
R.L.S. Jr.

PROFILE
SURVEYED
PLOTTED
COMPUTATIONS CHECKED
IN N.B. NOTES
OF PROPOSED WATERWAYS CHECKED
NO.
Louis Murray
4/90

PLATE 1 - PLAN-PROFILE - U.P.R.R.E. STANDARD
KEUFFEL & ESSER CO., NEW YORK

ST. ALBANS-FAIRFIELD
Project S No. 33(4)
Sheet 14 of 29
6