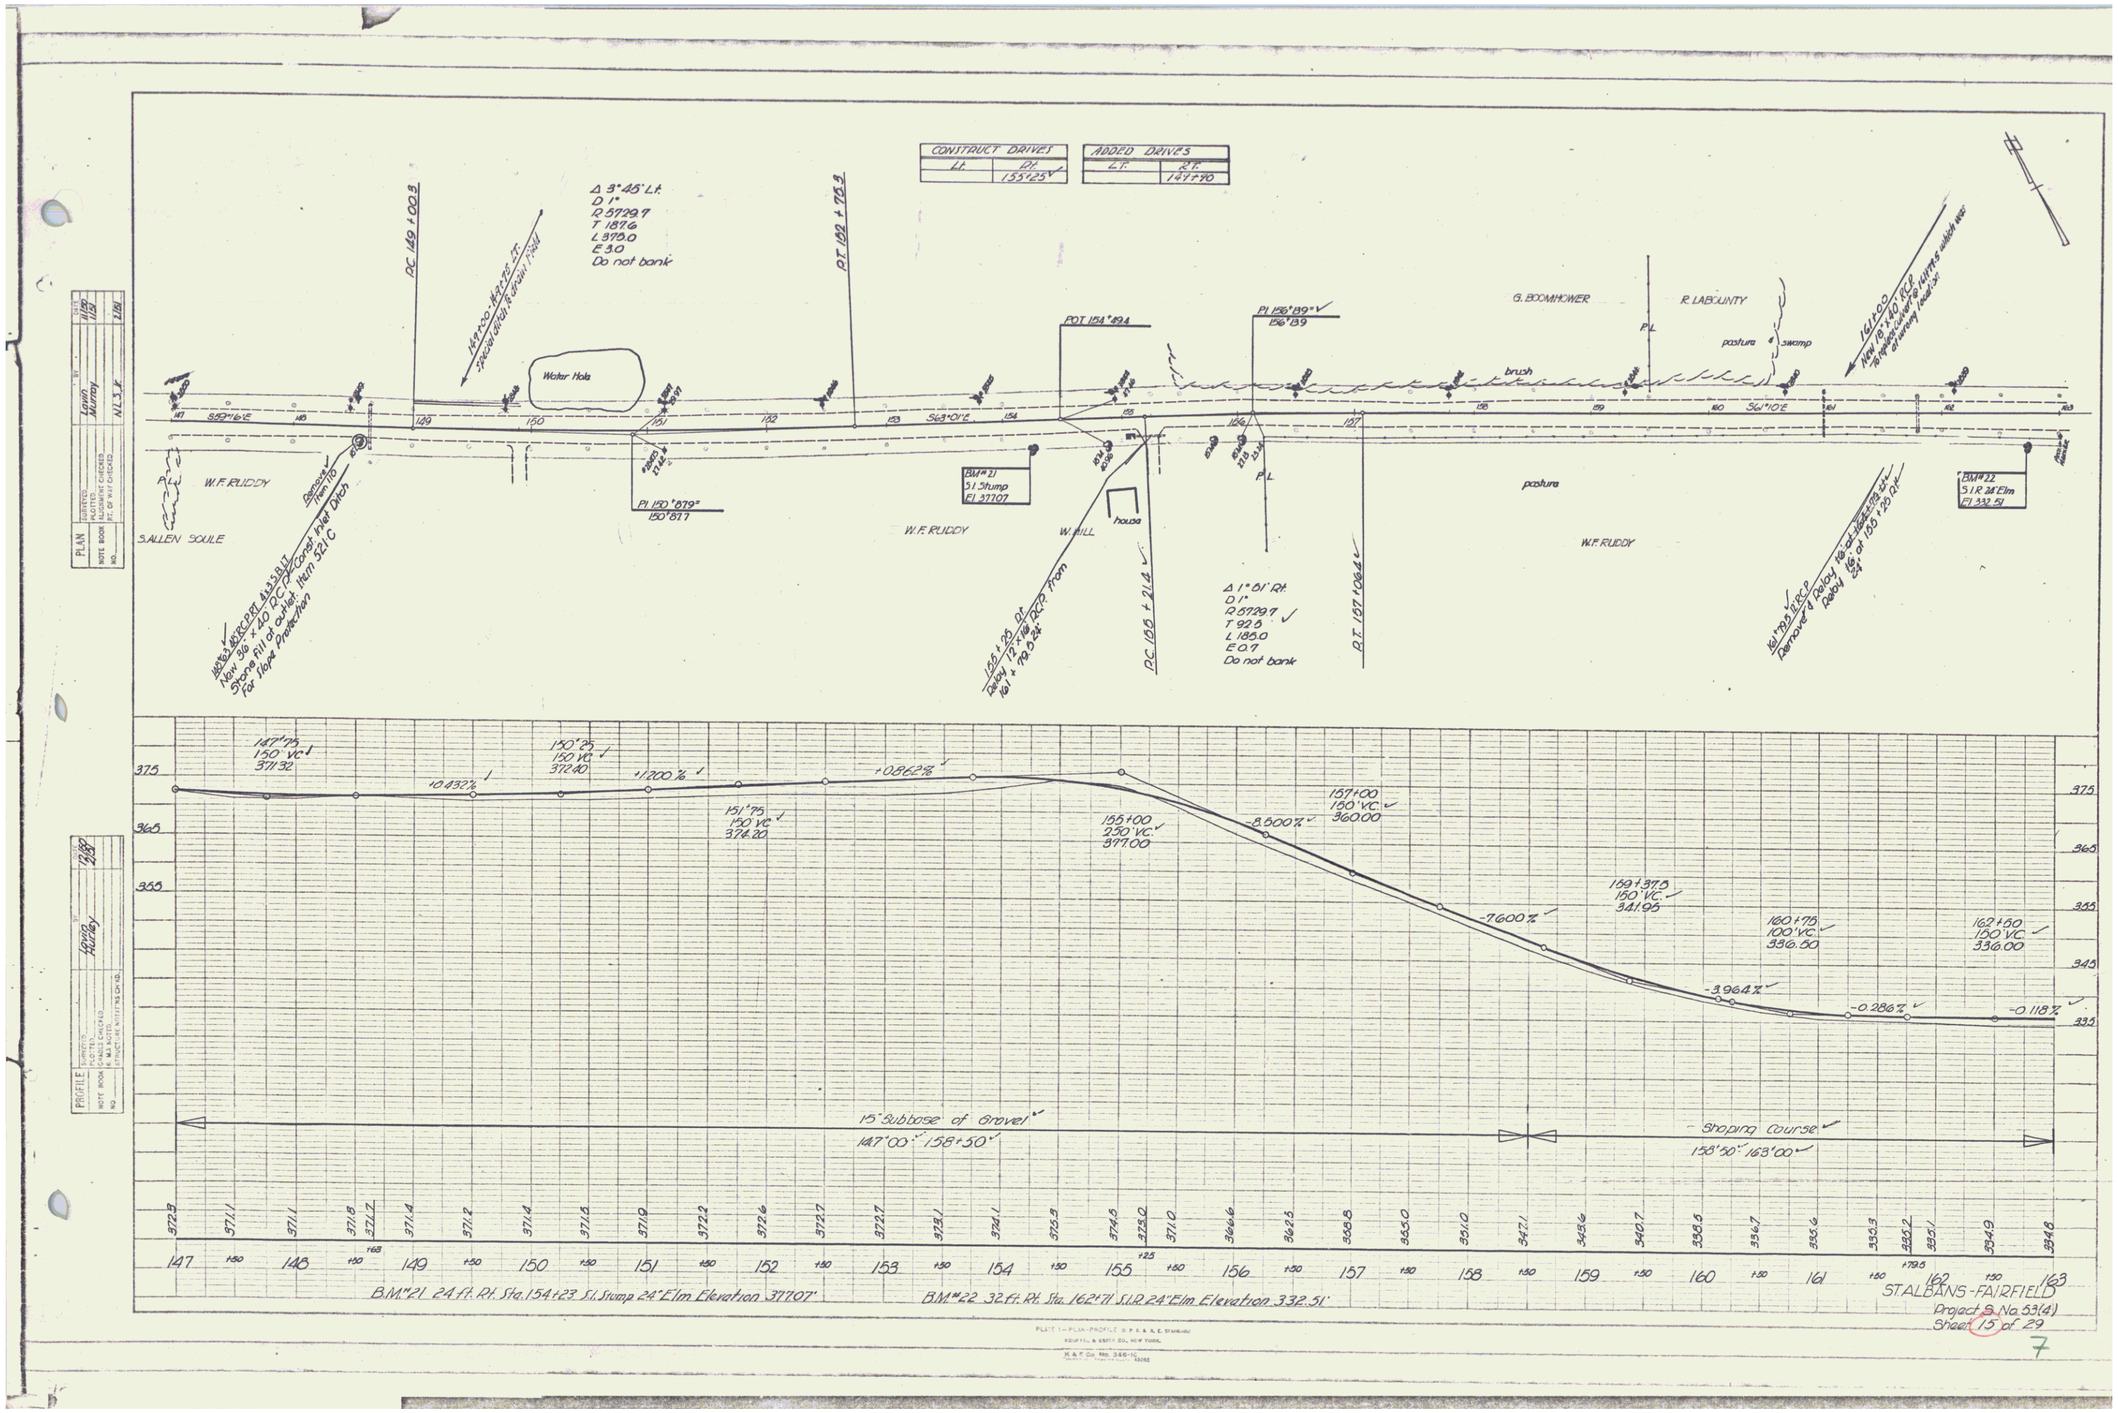
CONTRACT DRIVES
Lt. Rt. 155+25
ADDED DRIVES
LT. RT. 149+90
Δ 3°45' Lt.
D 1°
R 5729.7
T 187.6
L 375.0
E 3.0
Do not bank
PC 149+00.3
PT 152+75.3
Water Hole
POT 154+89.4
PI 156+89 = 156+89
G. BOOMHOWER
R. LABOUNTY
pasture
swamp
brush
W.F. RUDDY
S. ALLEN SOULE
PI 150+87.9 = 150+87.7
BM #21
51.5 Stump
El 377.07
house
W. HILL
Δ 1°01' Rt.
D 1°
R 5729.7
T 92.5
L 185.0
E 0.7
Do not bank
PC 155+21.4
PT 157+06.4
BM #22
51.R 24" Elm
El 332.51
147+75
150' VC
371.32
150+75
150 VC
372.40
151+75
150' VC
374.20
155+00
250' VC
377.00
157+00
150' VC
360.00
159+37.5
150' VC
341.95
160+75
100' VC
336.50
162+50
150' VC
336.00
+0.432%
+1.200%
+0.862%
-8.500%
-7.600%
-3.964%
-0.286%
-0.118%
15" Subbase of Gravel
147+00 - 158+50
Shoping Course
158+50 - 163+00
BM #21 24 ft. Rt. Sta. 154+23 S.I. Stump 24" Elm Elevation 377.07'
BM #22 32 ft. Rt. Sta. 162+71 S.I.R. 24" Elm Elevation 332.51'
ST. ALBANS - FAIRFIELD
Project S. No. 53(4)
Sheet 15 of 29
7