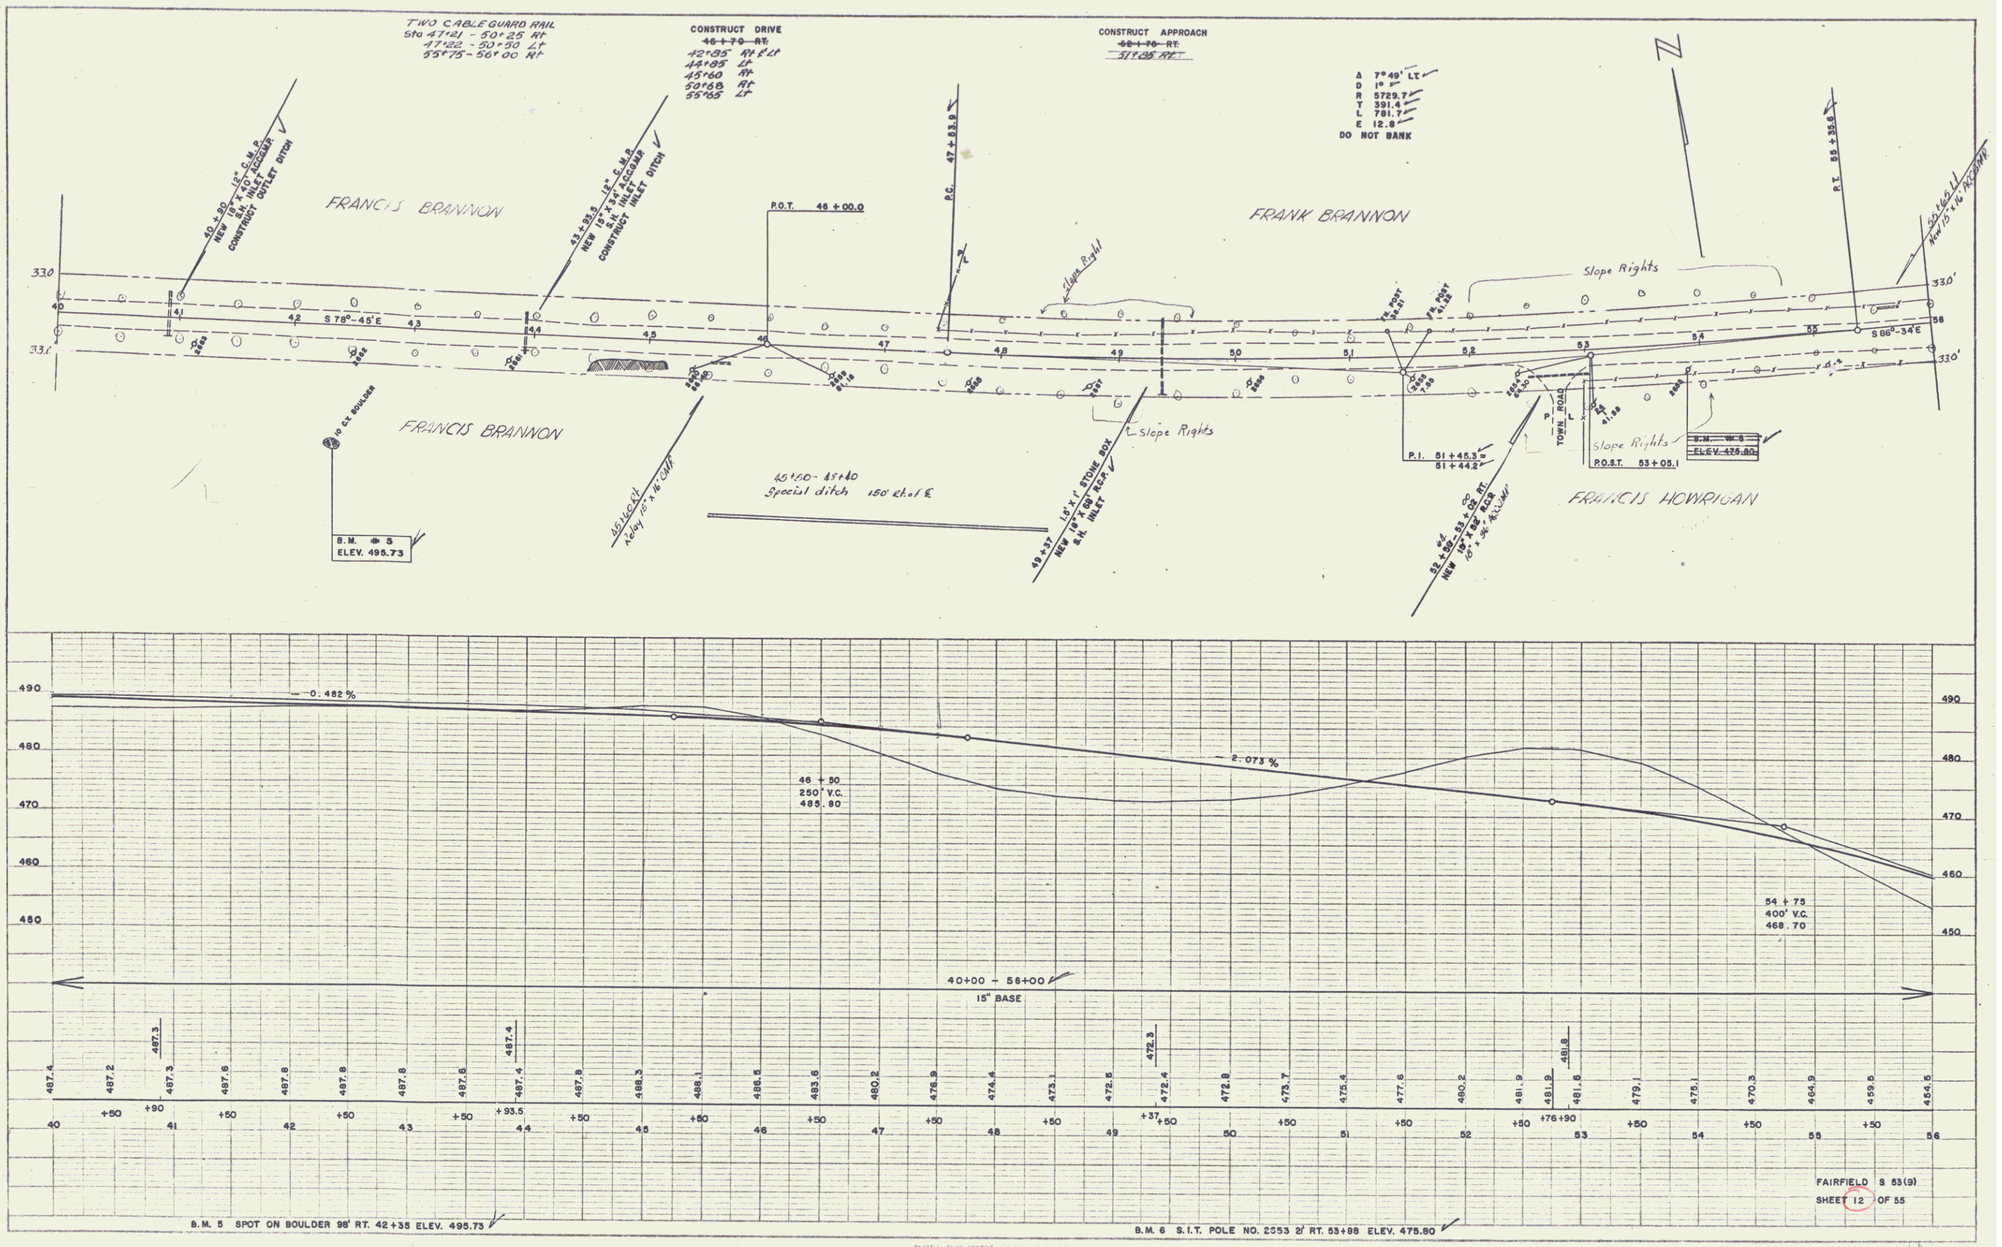


PLAN
DRAWN
PLOTTED
PROFILE CHECKED
PLAN CHECKED
NOTE BOOK
NO.

SPAULDING
WEBSTER-MARTIN INC. 10-54
8-54

PROFILE
DRAWN
PLOTTED
PROFILE CALCULATED
PROFILE CHECKED
NOTE BOOK
NO.

DELANO
WEBSTER-MARTIN INC. 10-54
8-54

PLATE 1—PLAN-PROFILE C. F. & R. E. STANDARD
KEUFFEL & ESSER CO., NEW YORK
K & E Co. No. 349-12

4