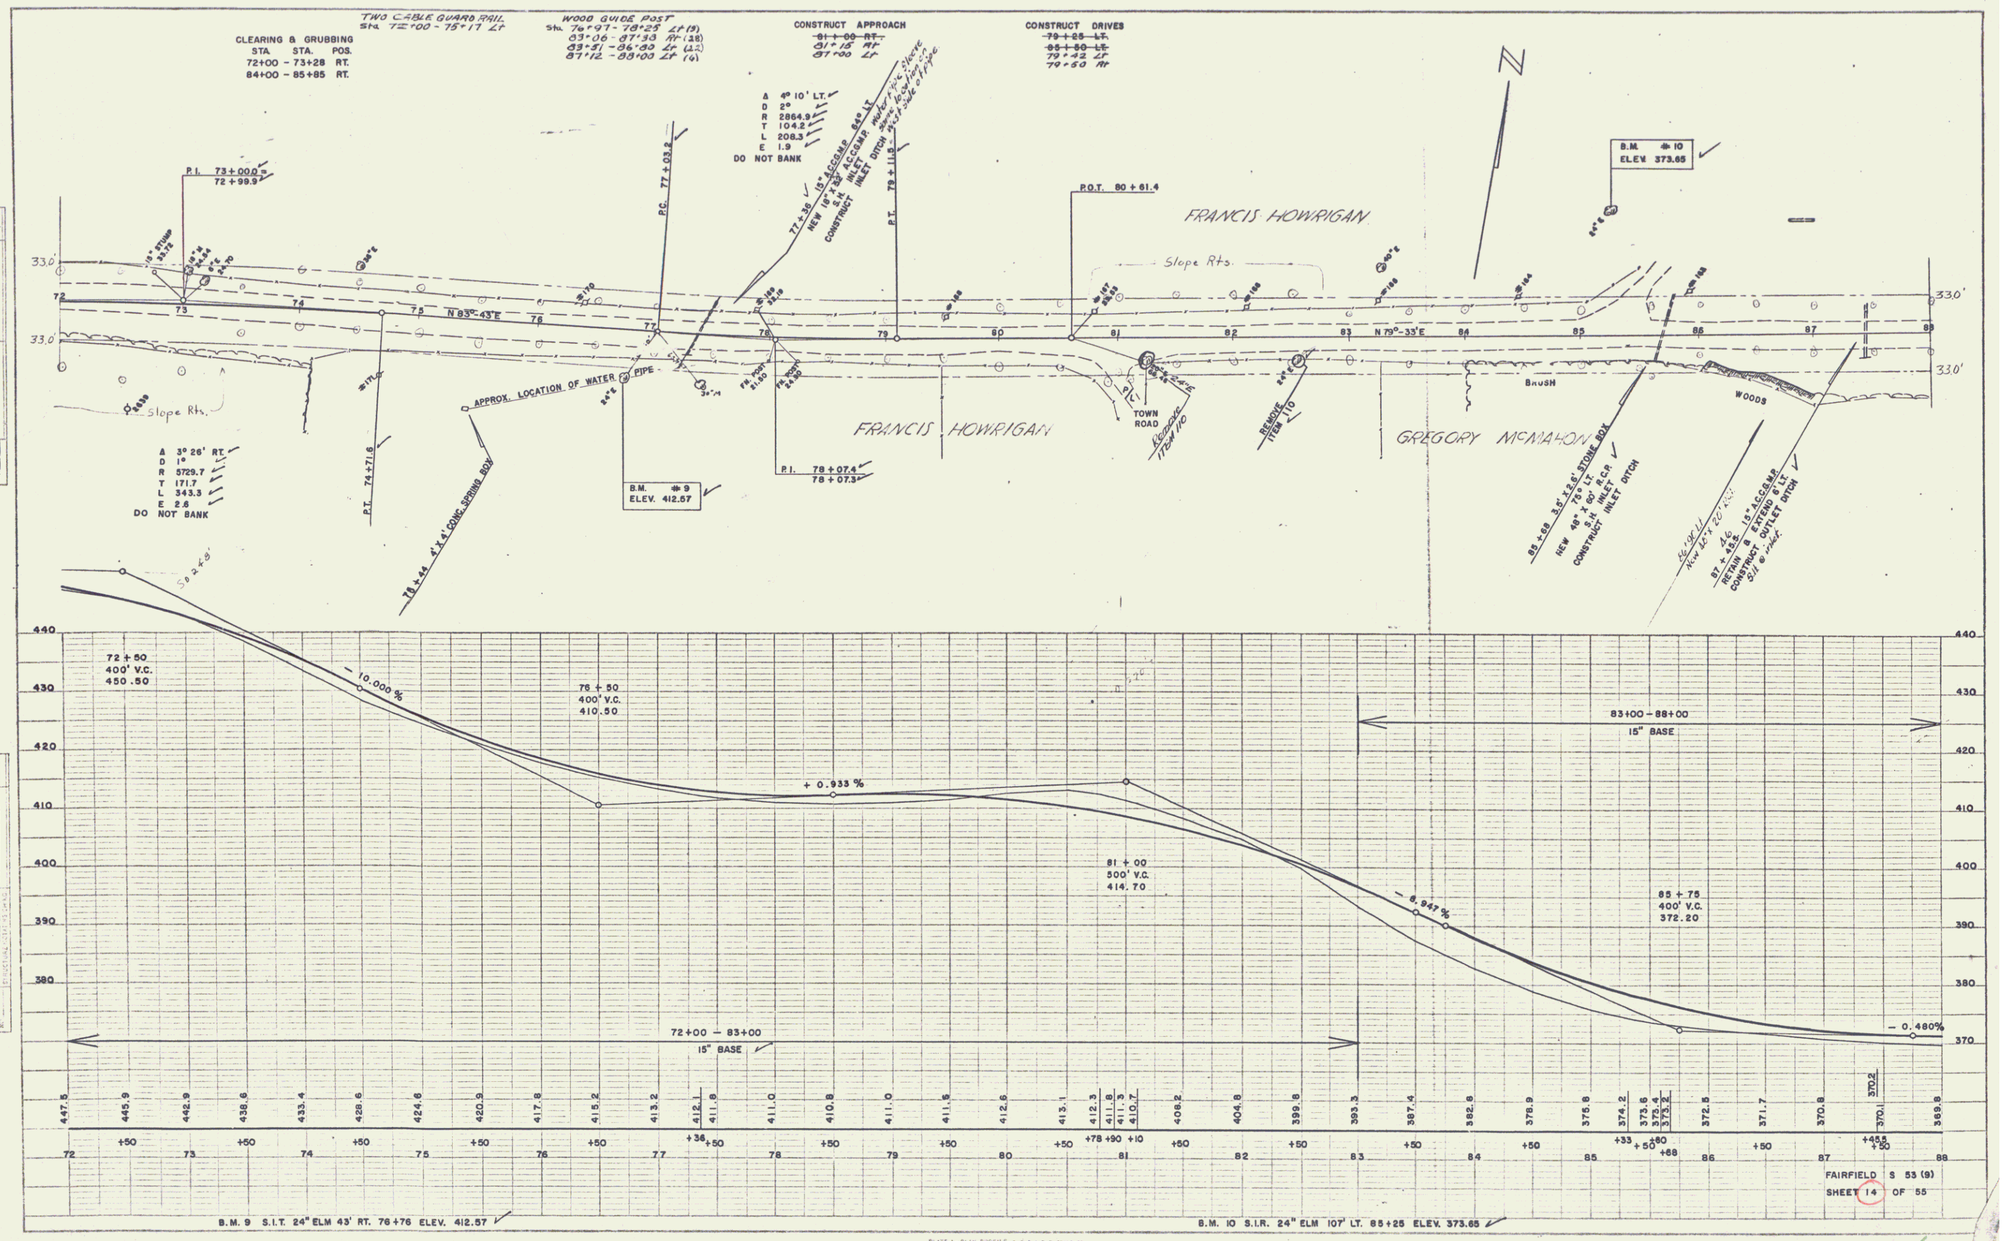

PLAN
DELANO
WEBSTER-MARTIN INC. 10-54
8-54
NOTE BOOK
NO.
COMPUTED
DRAWN
ALIGNMENT CHECKED
PLAN CHECKED
PLAN & PROFILE CHECKED

PROFILE
DELANO
WEBSTER-MARTIN INC. 10-54
8-54
NOTE BOOK
NO.
COMPUTED
DRAWN
GRADES CHECKED
PROFILE CHECKED
PLAN & PROFILE CHECKED

PLATE 1 - PLAN-PROFILE B.P.R.A.W.R.E. STANDARD
KEUFFEL & ESSER CO., NEW YORK
K & E CO. No. 348-C

6