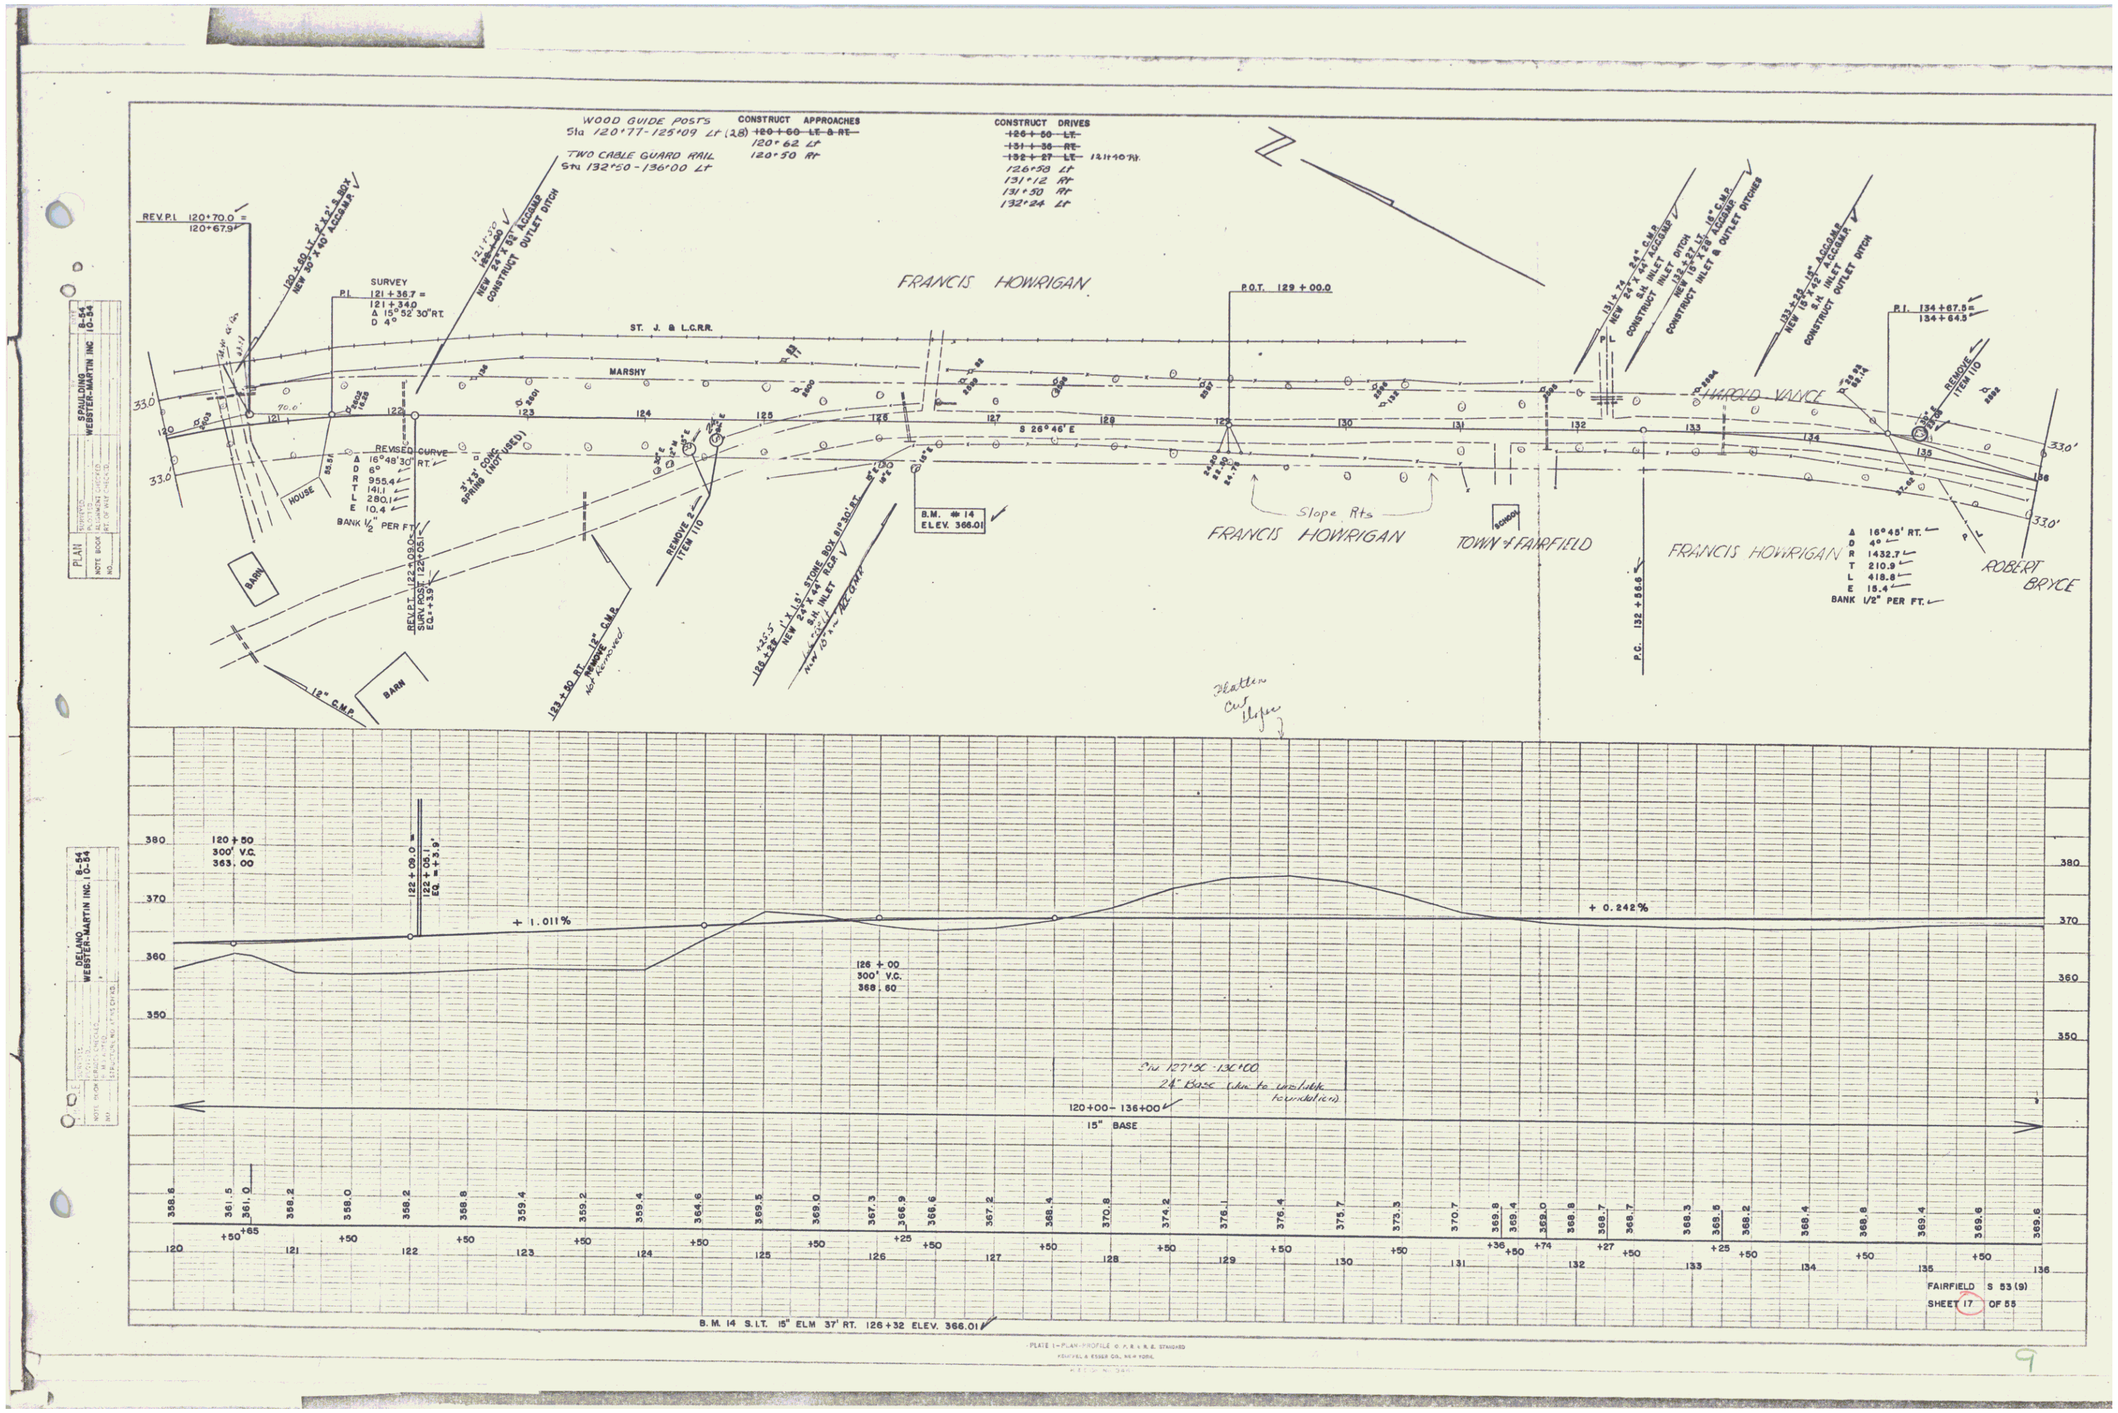

PLAN

PROFILE
DELANO WEBSTER-MARTIN INC. 10-54

PLATE 1—PLAN-PROFILE O. R. & R. R. STAGHED
KEUFFEL & ESSER CO., NEW YORK

9