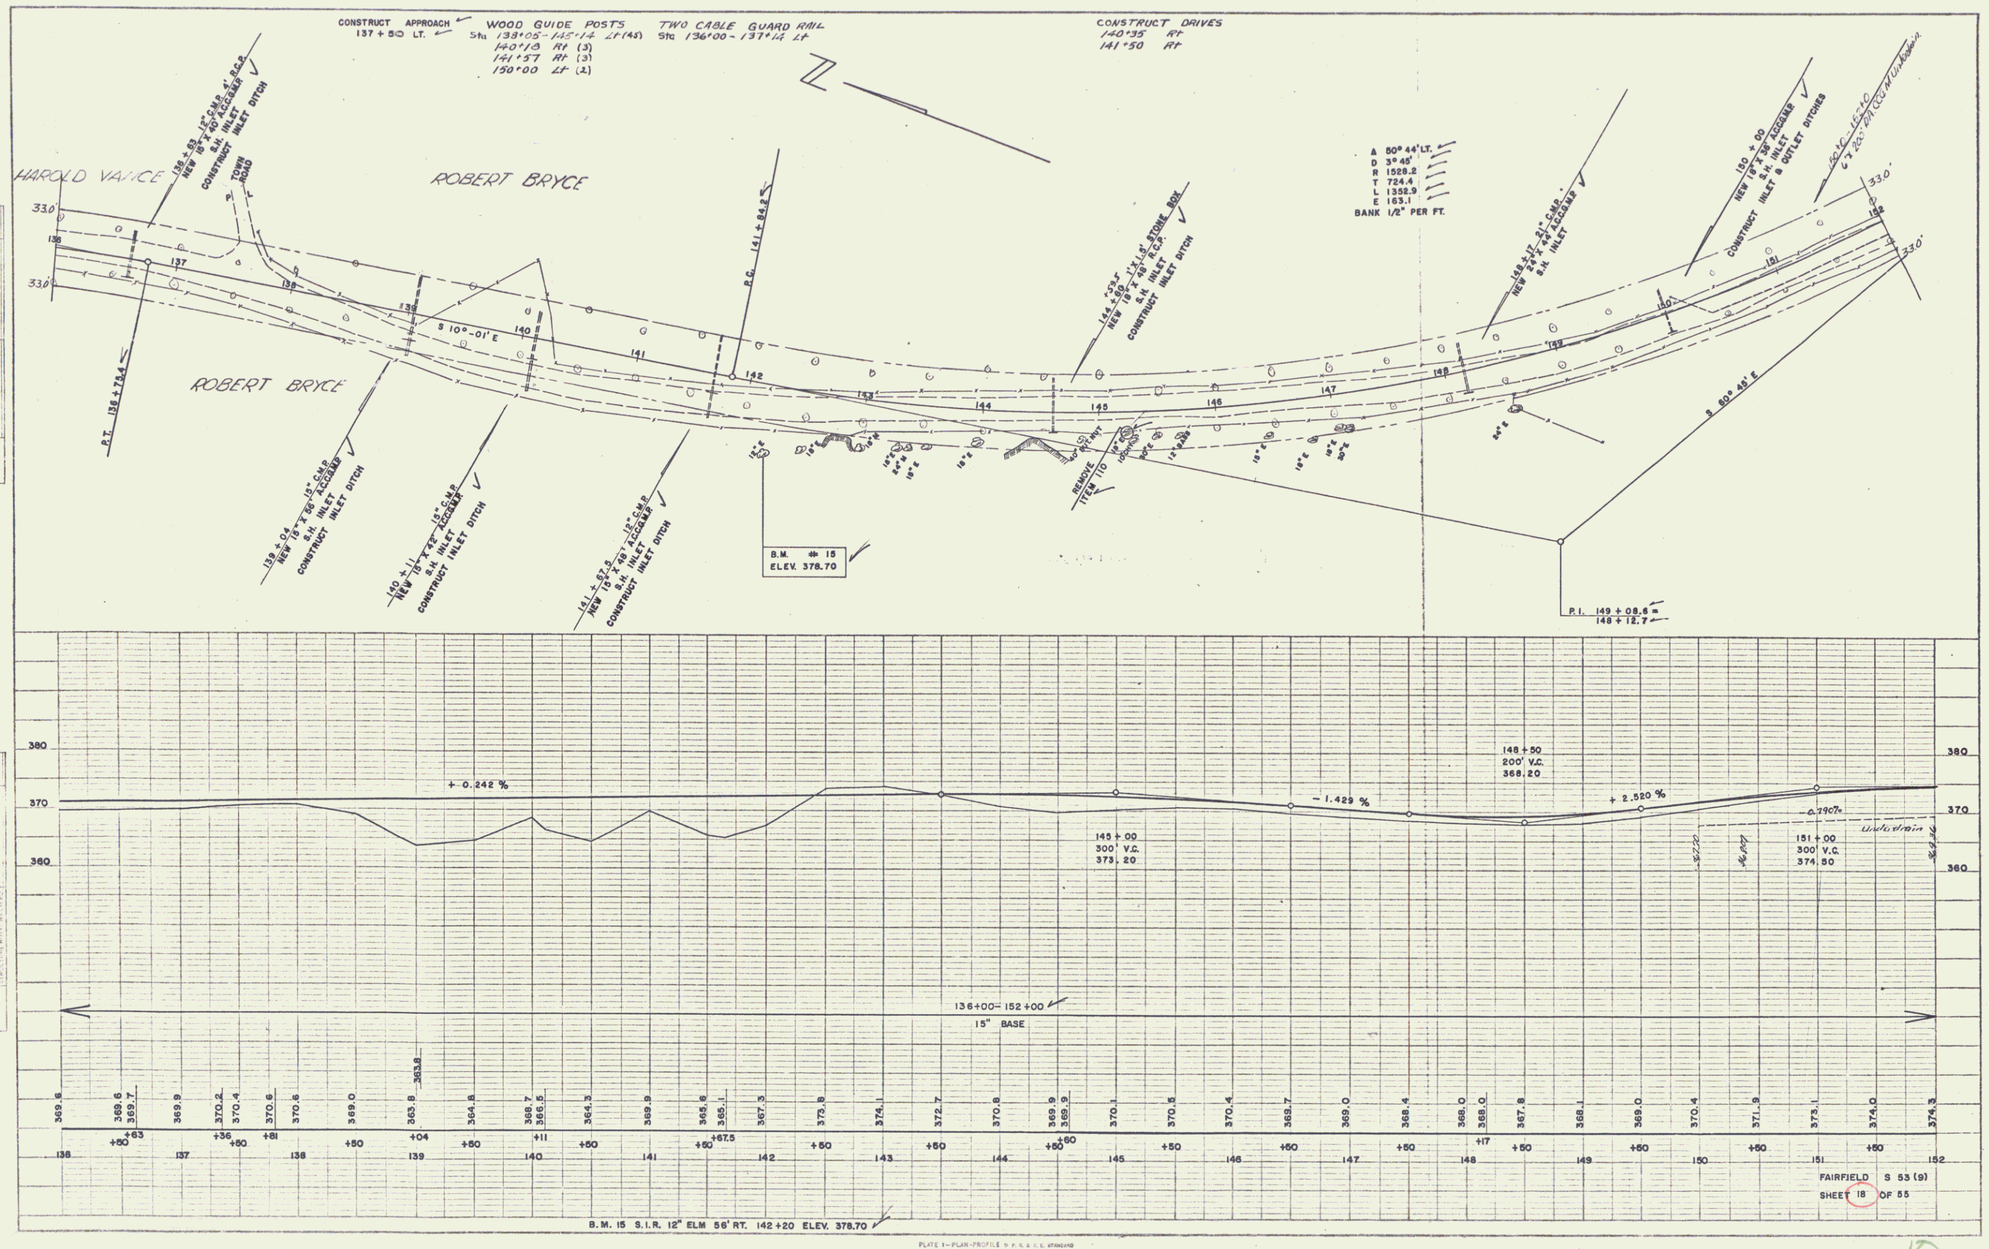

PLATE 1—PLAN-PROFILE O. P. R. & R. C. STANDARD
REUFFEL & ESSER CO., N.Y. & NEW YORK
R & E CO. No. 348-1C

PLAN — SPAULDING WEBSTER-MARTIN INC. 10-54 — 8-54

DELANO WEBSTER-MARTIN INC. 10-54 — 8-54

10