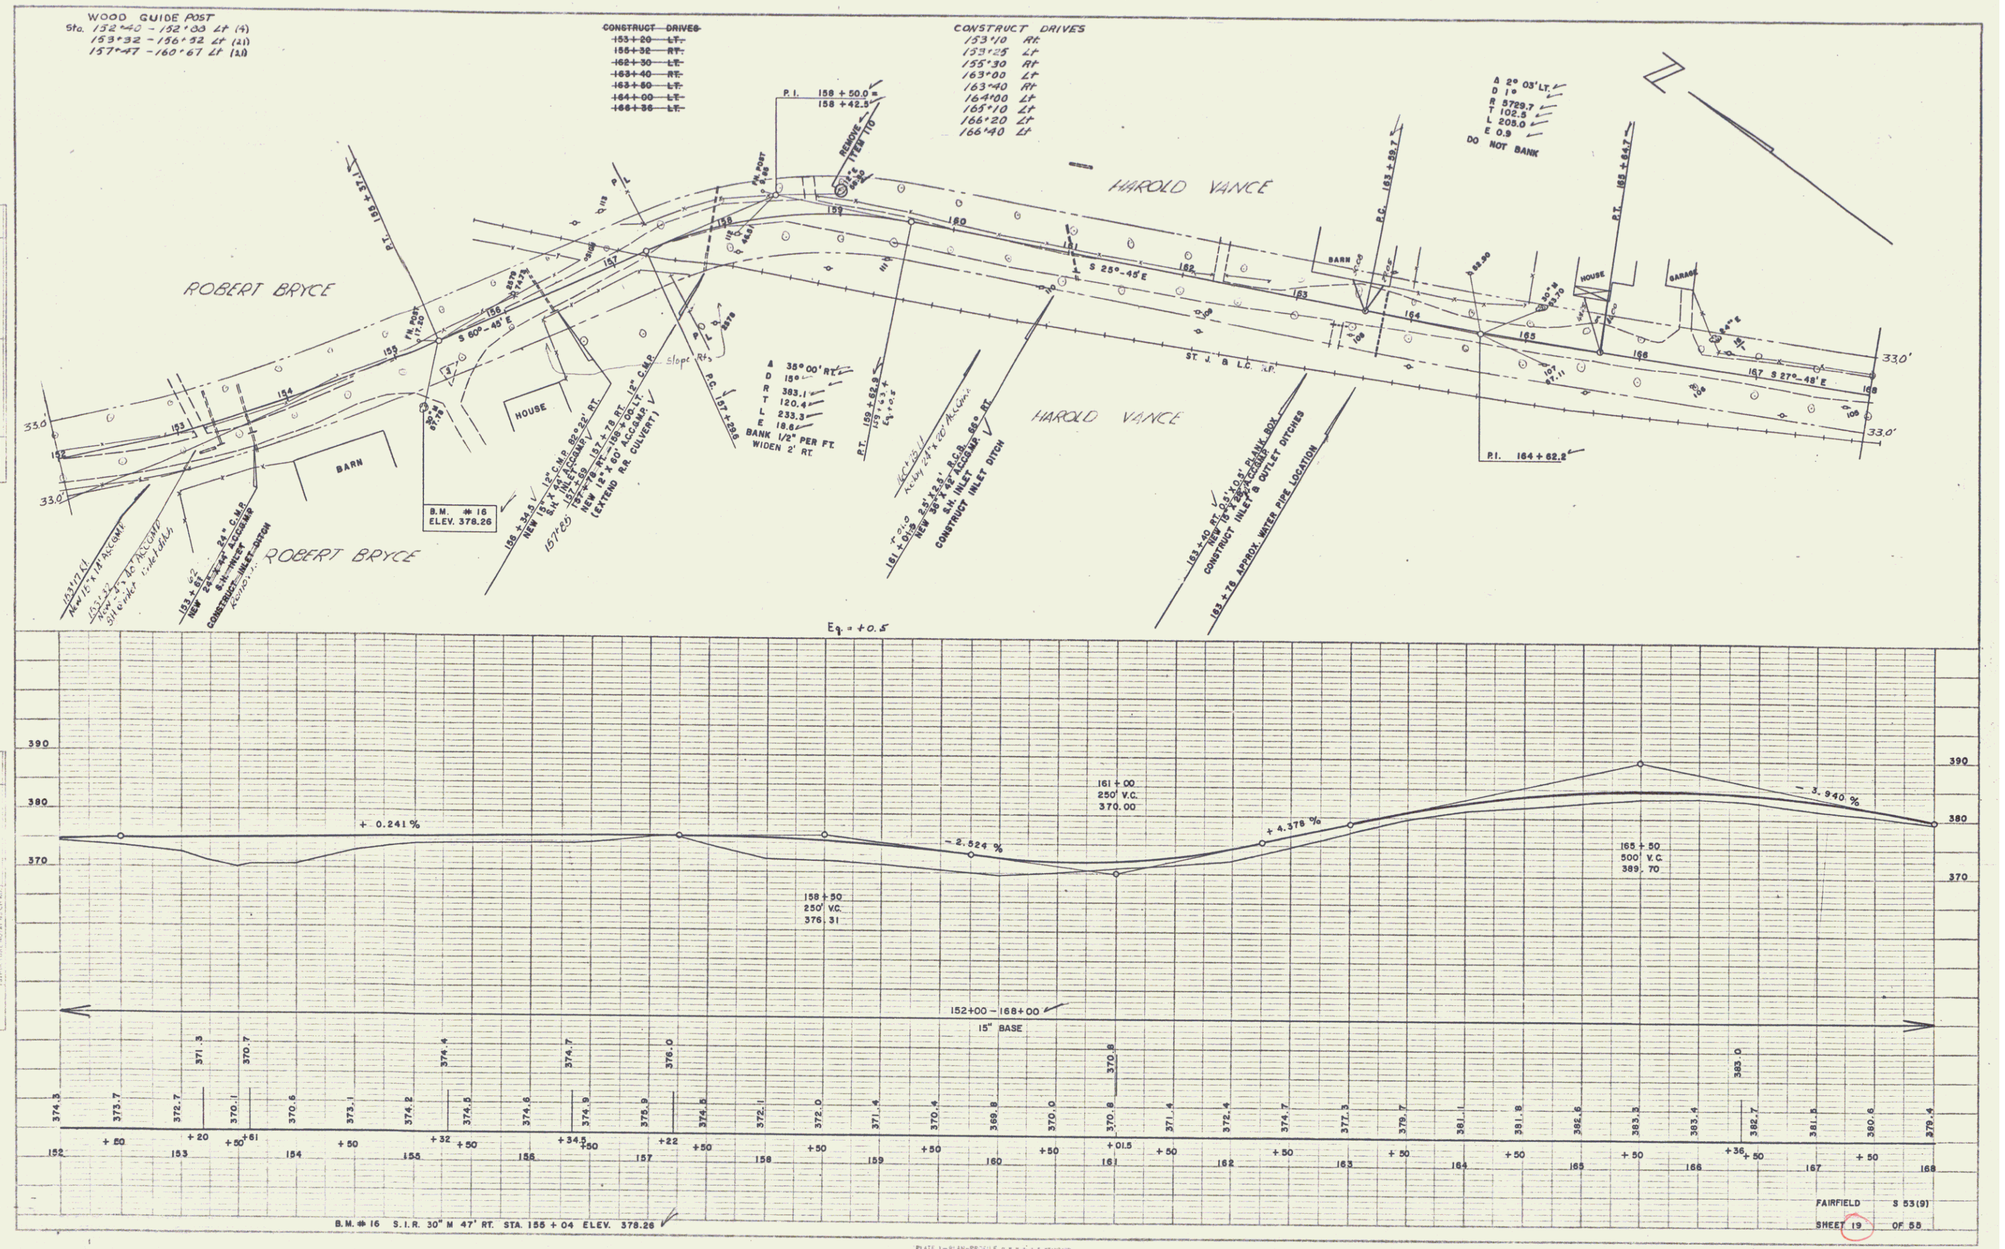

PLATE 1—PLAN-PROFILE D.P.R.& I.E. STANDARD
KEUFFEL & ESSER CO., NEW YORK
F. & E. CO. No. 24510

DELAND
WEBSTER-MARTIN INC. 10-54

PAUL DIRE
WEBSTER-MARTIN INC. 8-54