


PLAN
 DATE BOOK
 PROJECT
 SHEET NO.
 9/04

PROFILE
 DATE BOOK
 PROJECT
 SHEET NO.
 9/04

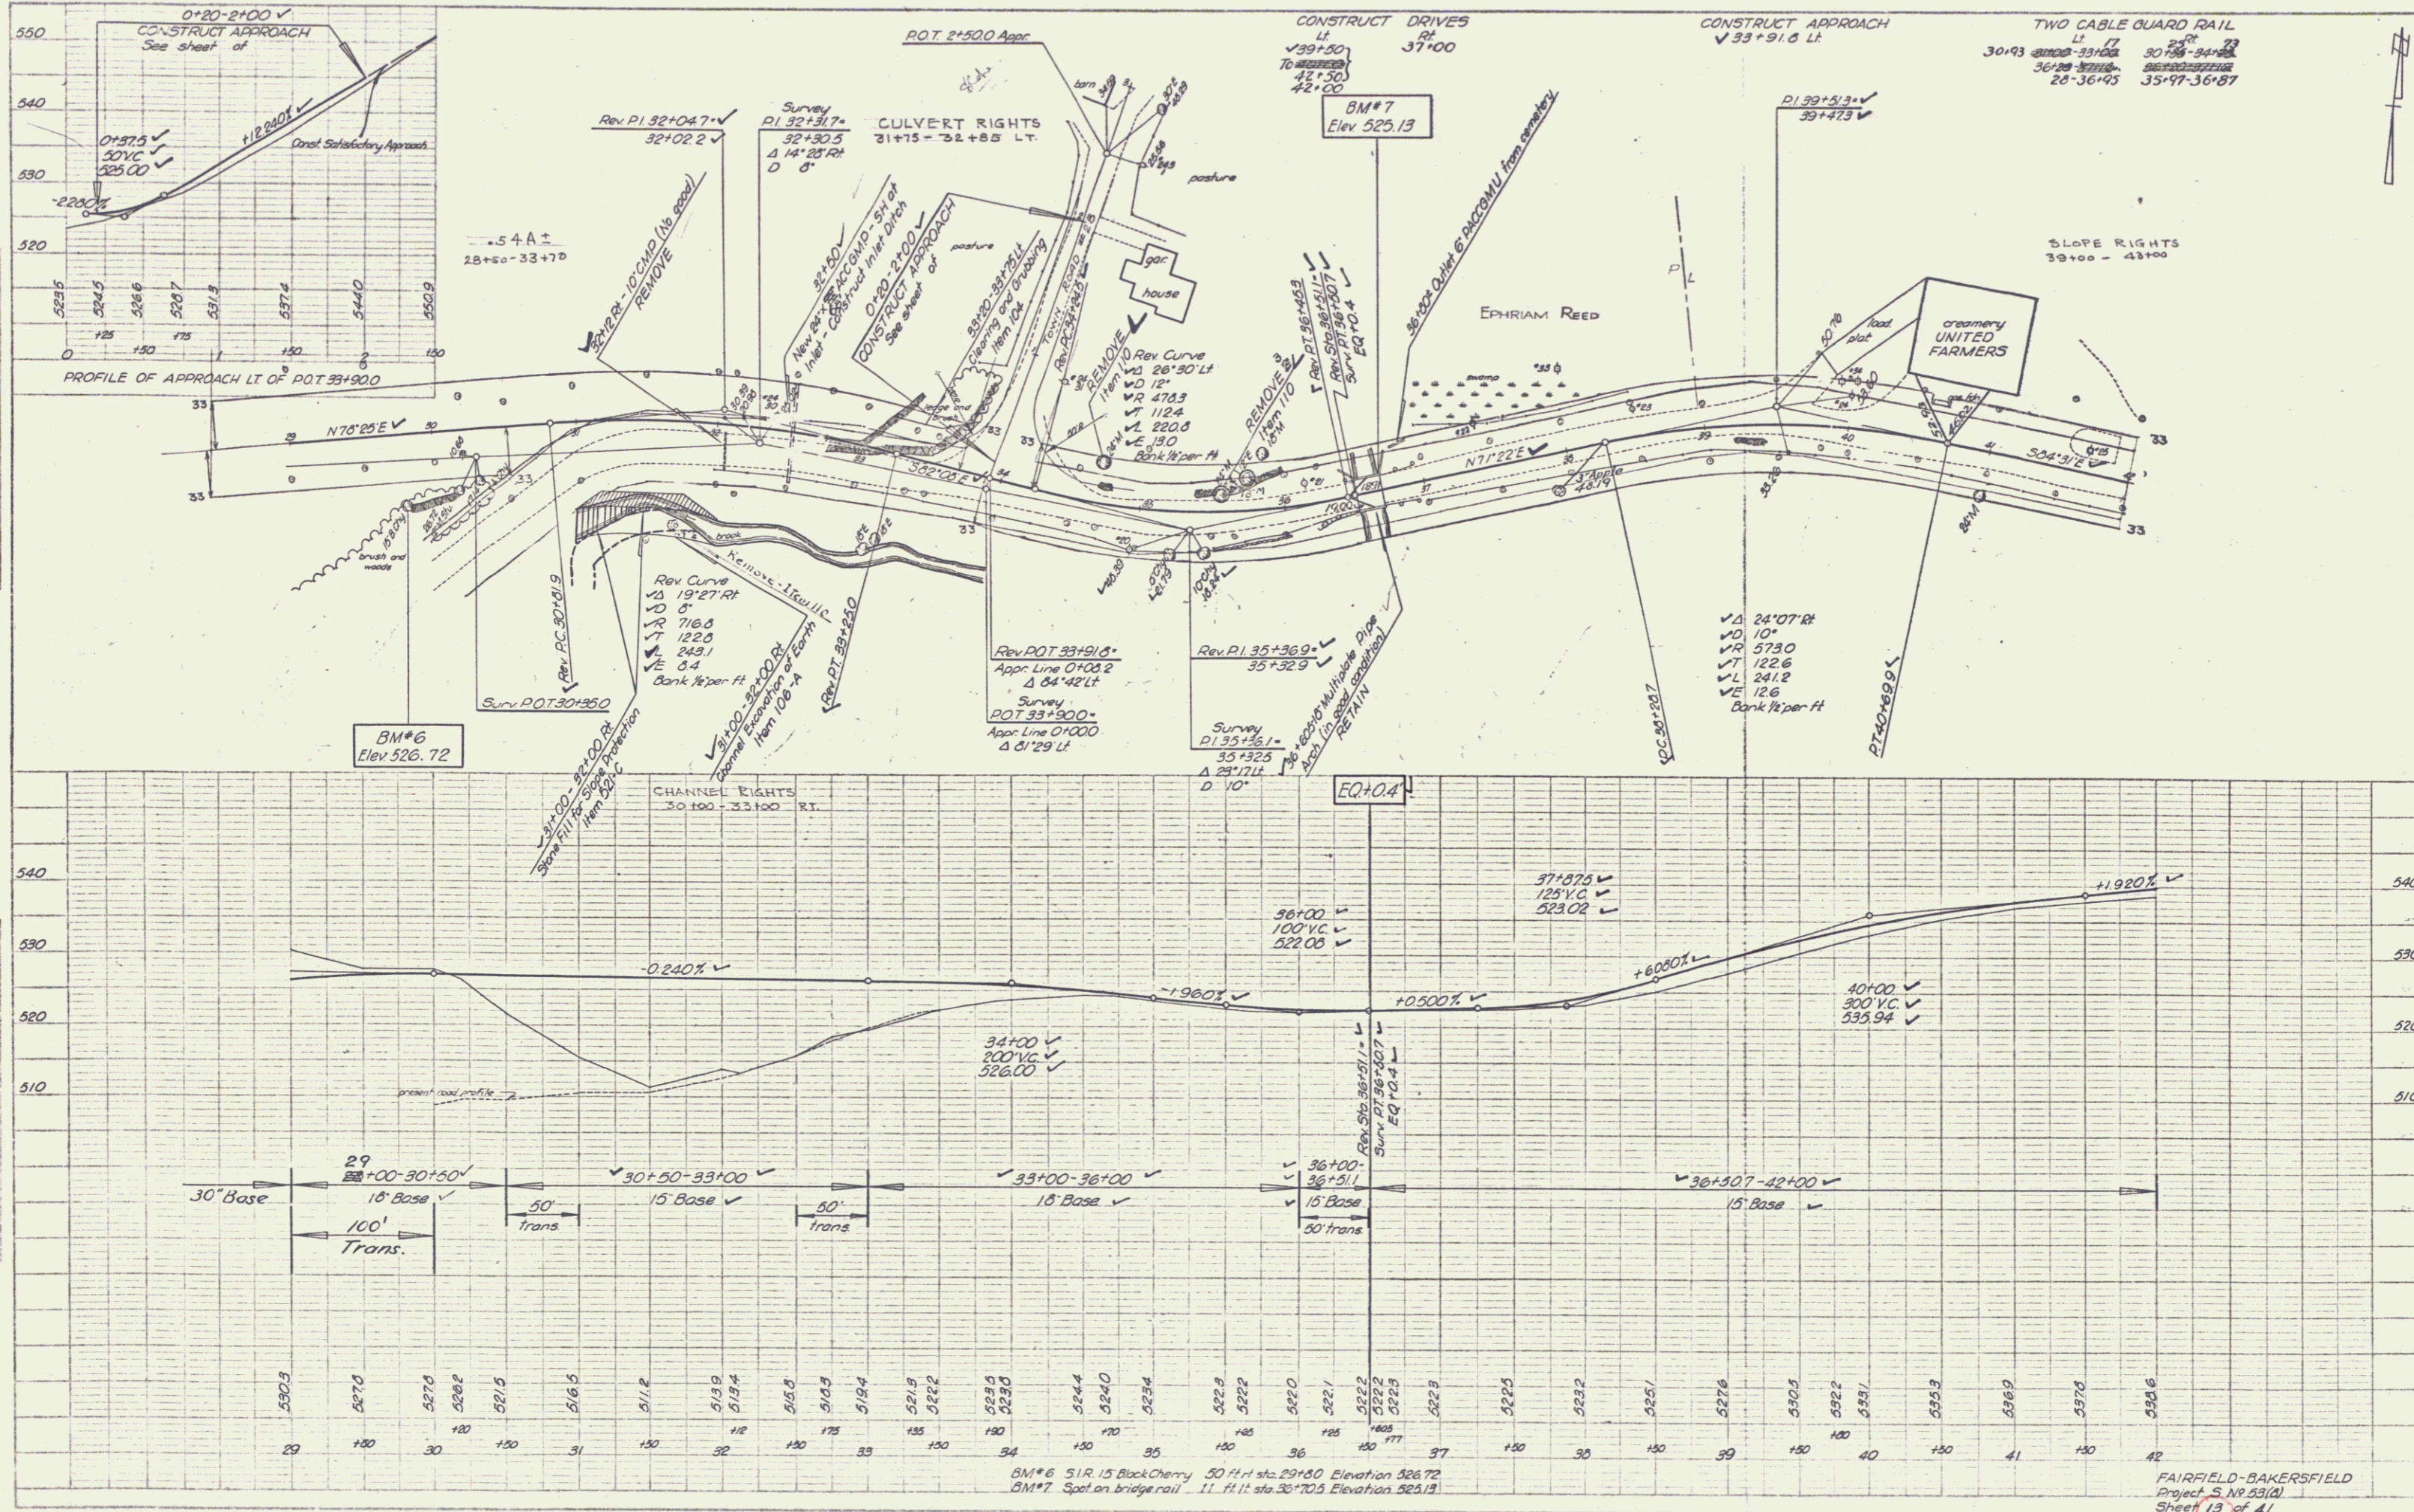

FAIRFIELD-BAKERSFIELD
 Project S, NR 53(D)
 Sheet 13 of 41