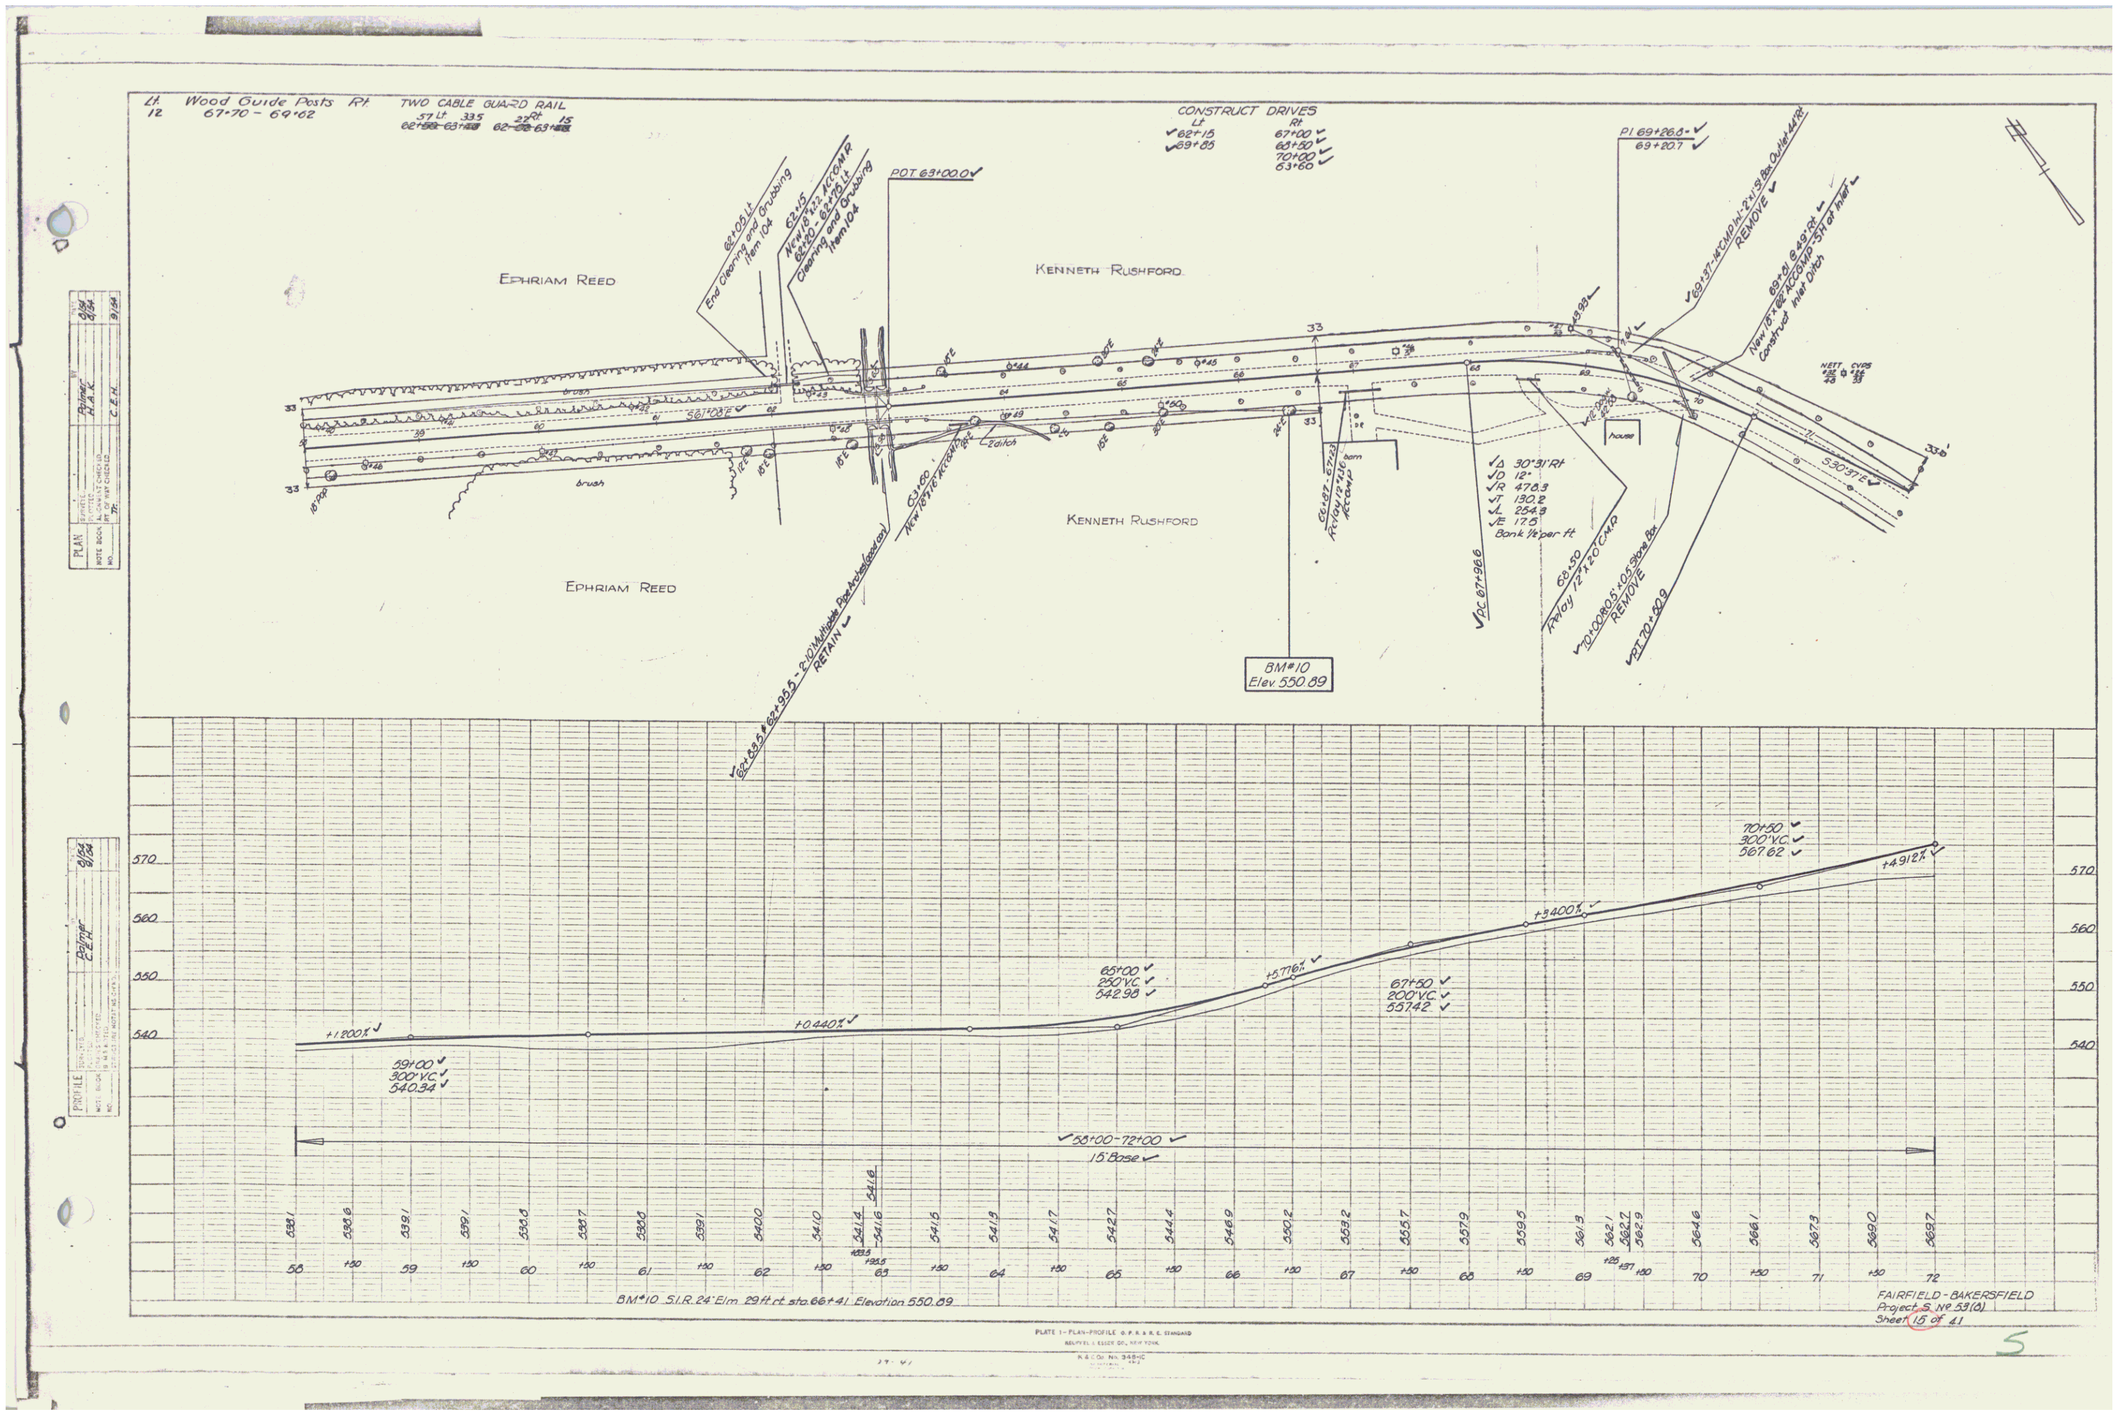

PLATE 1 - PLAN-PROFILE O.P.R.R.R.E. STANDARD
RELIVEL & ESSEX CO., NEW YORK
K & C Cat. No. 348-HC

5