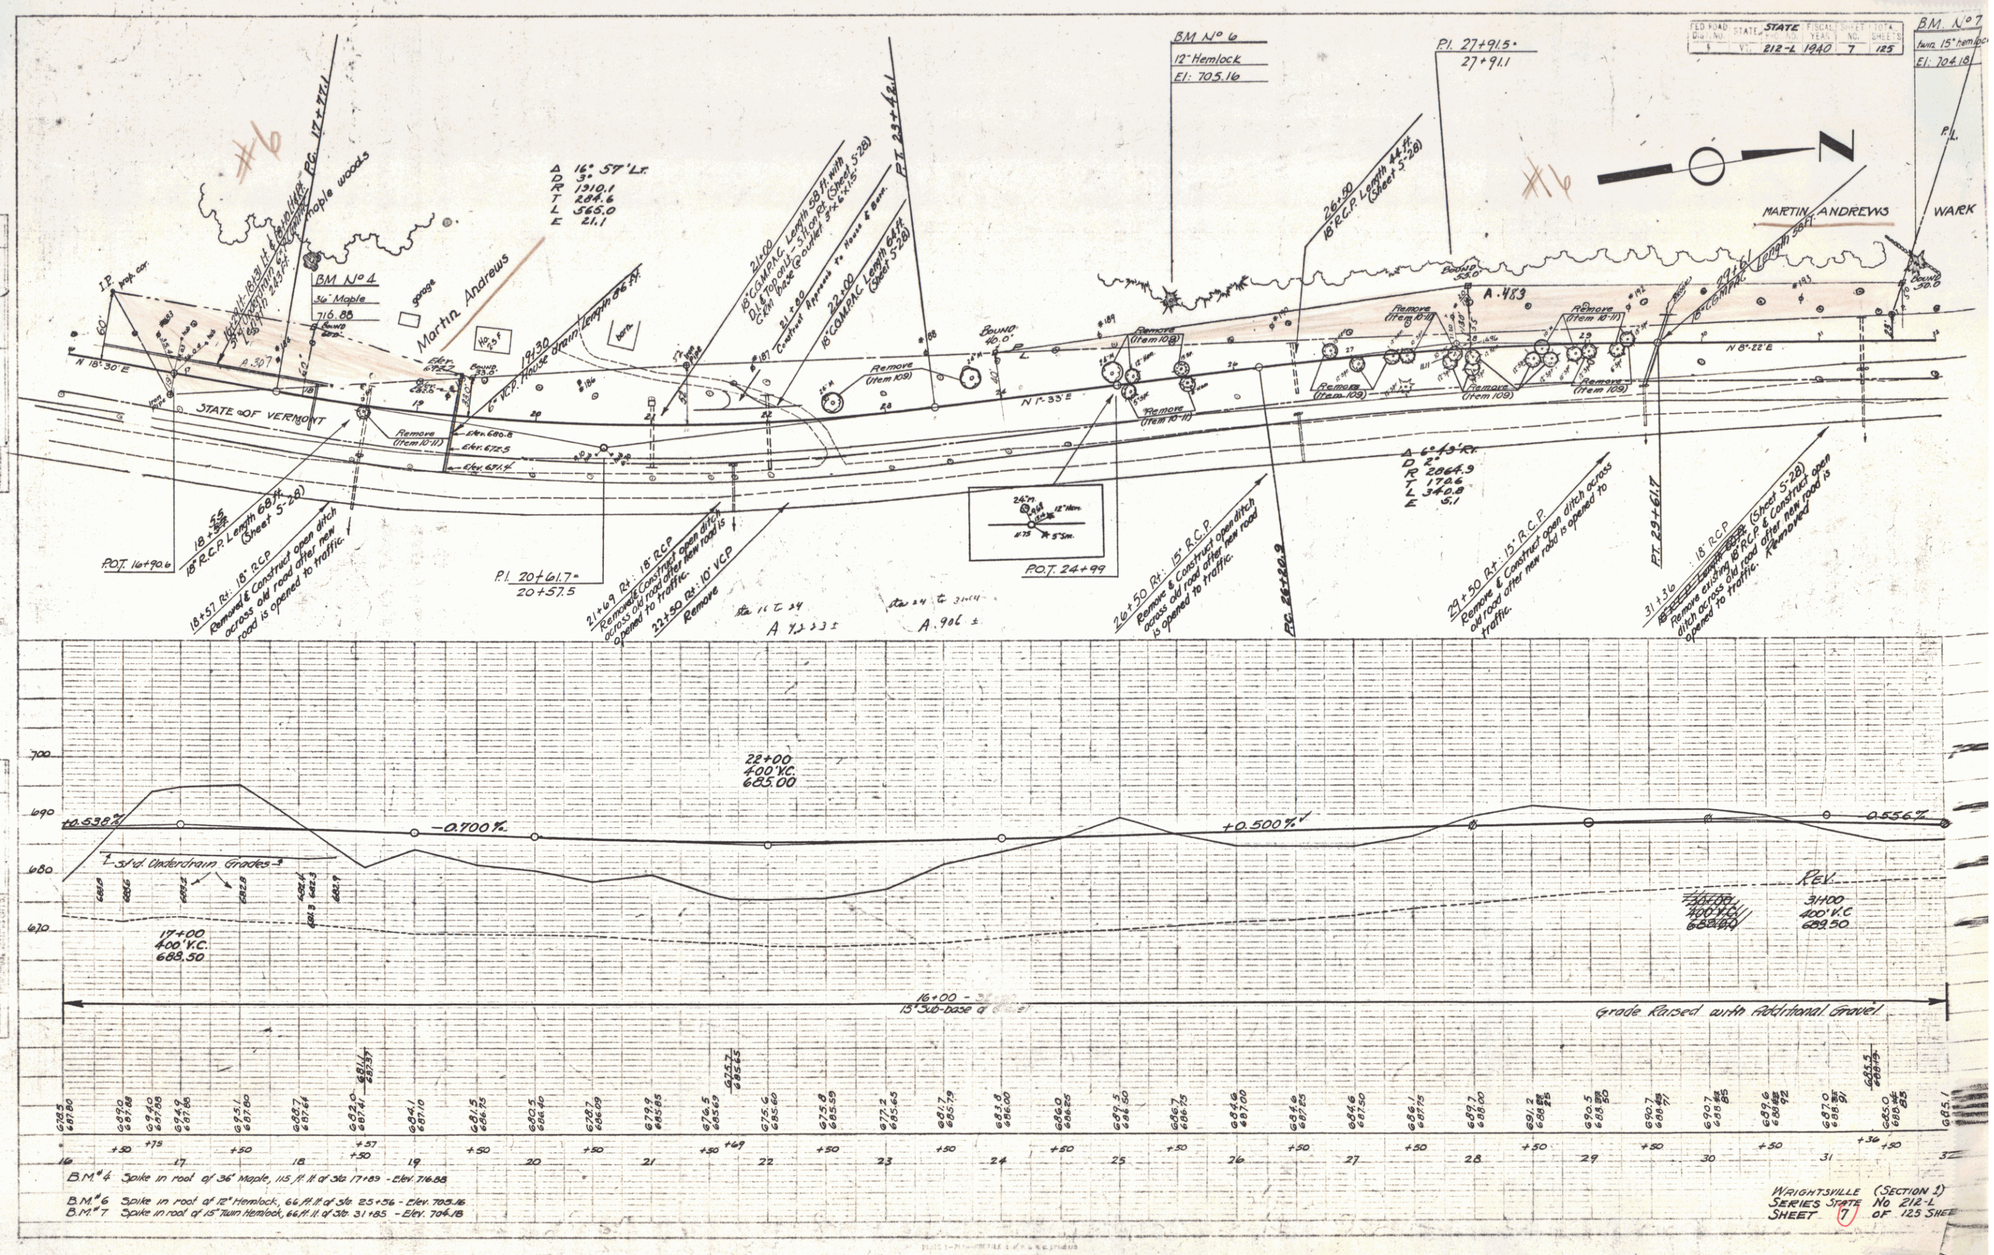
FED. ROAD DIV. NO. | STATE | STATE FISCAL YEAR | SHEET NO. | TOTAL SHEETS
212-L 1940 7 125
BM No 6
12" Hemlock
El: 705.16
BM No 7
twin 15" hemlock
El: 704.18
BM No 4
36" Maple
716.88
Martin Andrews
MARTIN ANDREWS
WARK
STATE OF VERMONT
N 18°30' E
N 8°22' E
N 1°33' E
Δ 16° 57' Lt.
D 3°
R 1910.1
T 284.6
L 565.0
E 21.1
Δ 6°43' Rt.
D 2°
R 2864.9
T 172.6
L 340.0
E 5.1
P.O.T. 16+90.6
P.I. 20+61.7 = 20+57.5
P.O.T. 24+99
P.I. 27+91.5 = 27+91.1
P.T. 23+61.7
18+57 Rt.: 18" R.C.P. Length 68 ft. (Sheet 5-28)
Removed & Construct open ditch across old road after new road is opened to traffic.
21+69 Rt.: 18" R.C.P.
Removed & Construct open ditch across old road after new road is opened to traffic.
22+50 Rt.: 10" V.C.P.
Remove
26+50 Rt.: 15" R.C.P.
Remove & Construct open ditch across old road after new road is opened to traffic.
29+50 Rt.: 15" R.C.P.
Remove & Construct open ditch across old road after new road is opened to traffic.
31+35 Lt.: 18" R.C.P. (Sheet 5-28)
Remove existing 18" R.C.P. & Construct open ditch across old road after new road is opened to traffic. Removed
Remove (Item 10-11)
Remove (Item 109)
Remove (Item 10-11)
Remove (Item 10-11)
Remove (Item 109)
Remove (Item 109)
Remove (Item 109