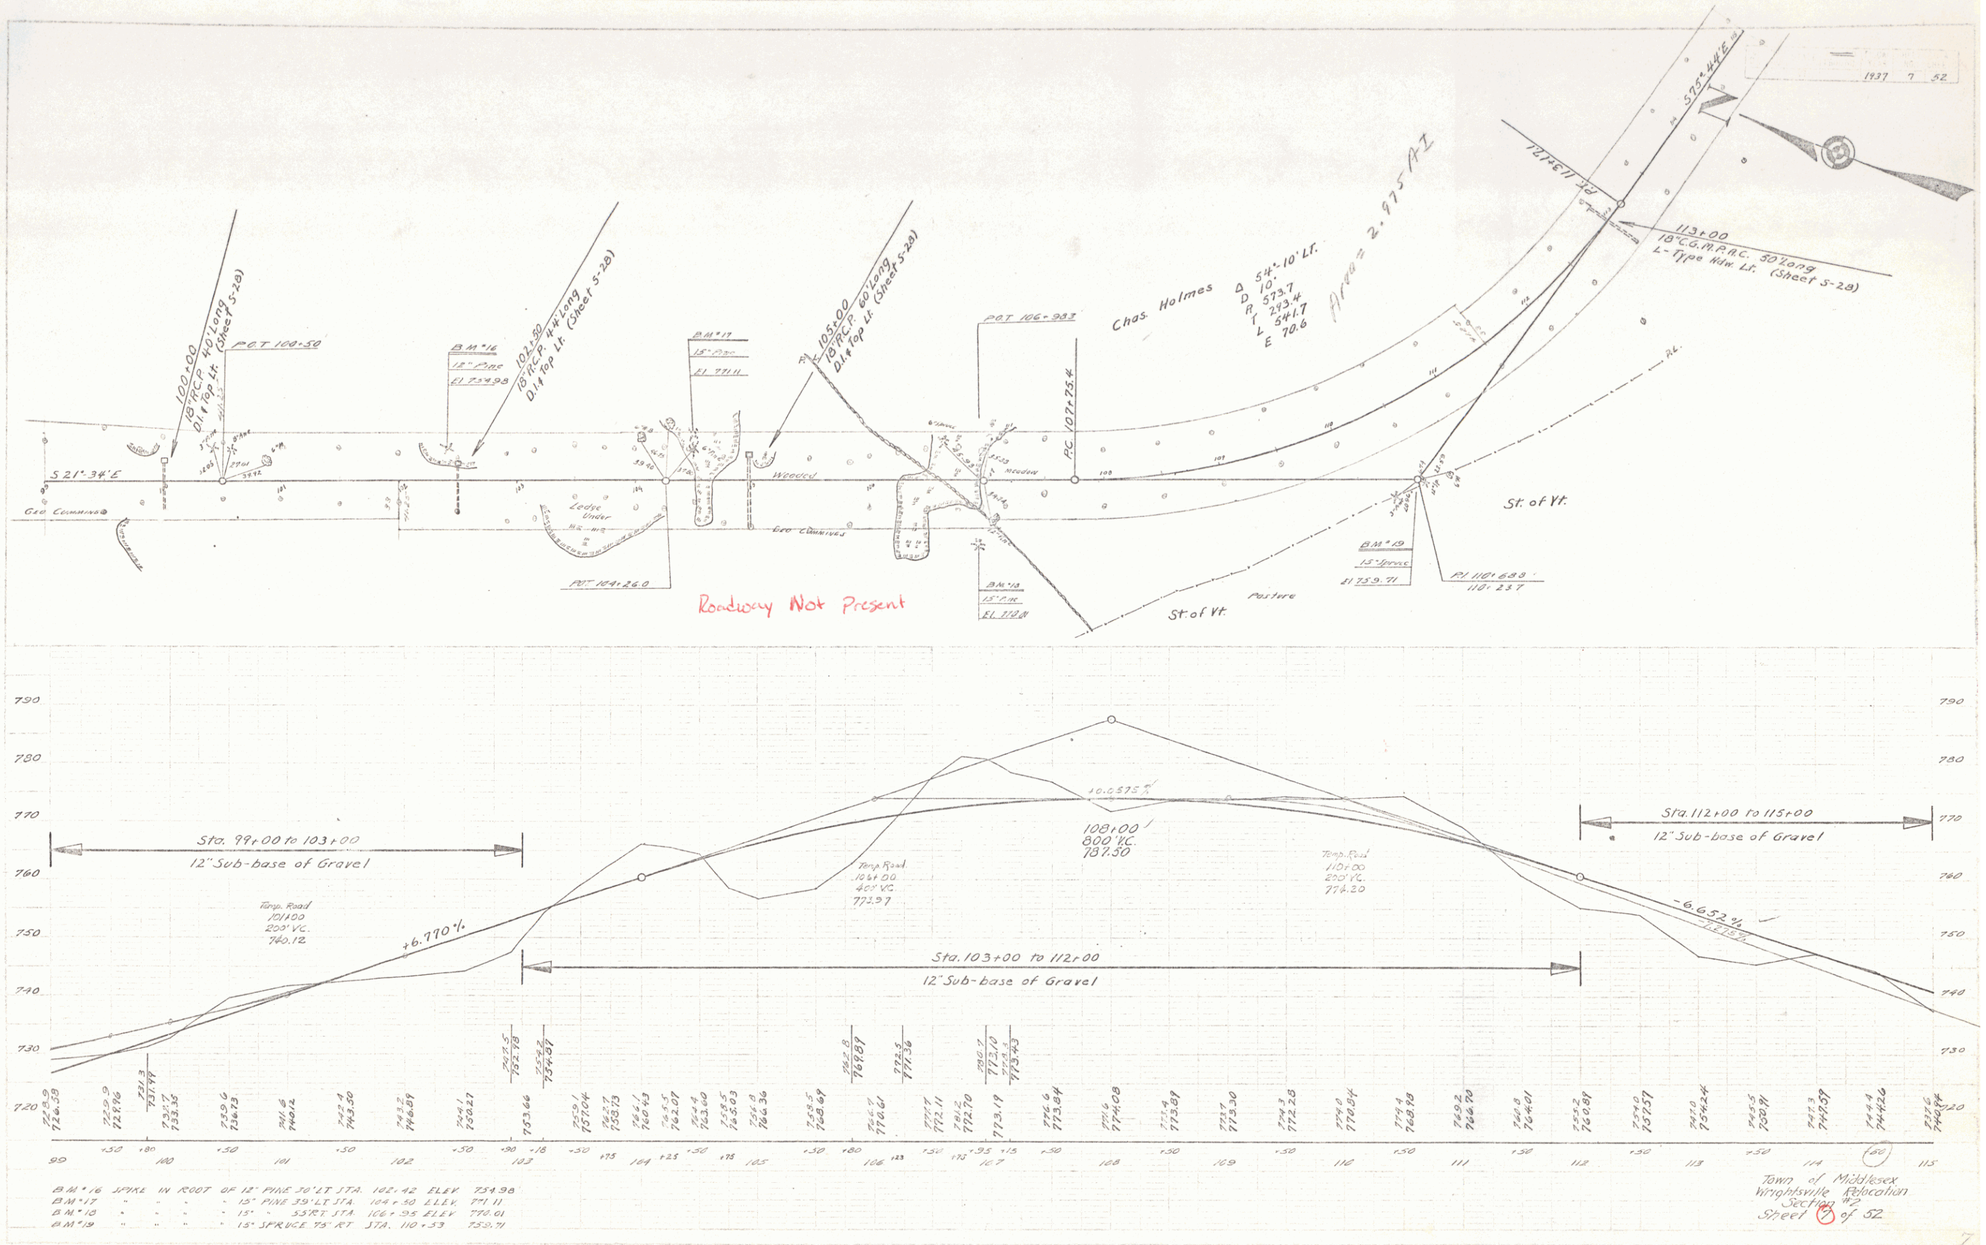
100+00
18" R.C.P. 40' Long
D.1.4 Top Lt. (Sheet S-28)
POT 100+50
S 21°-34'-E
Geo Cummings
BM #16
18" Pine
El 759.98
102+00
18" R.C.P. 44' Long
D.1.4 Top Lt. (Sheet S-28)
Lodge Under Hill
POT 104+26.0
BM #17
18" Pine
El 771.11
105+00
18" R.C.P. 60' Long
D.1.4 Top Lt. (Sheet S-28)
Weeded
Geo Cummings
POT 106+98.3
Weeded
PC 107+75.4
Chas. Holmes
Δ 54°-10' Lt.
D 10°
R 573.7
T 293.4
L 541.7
E 70.6
Area = 2.975 Ac.
BM #18
18" Pine
El 770.01
Roadway Not Present
St. of Vt.
Pasture
BM #19
15" Spruce
El 759.71
PI 110+68.0
110°-23'-T
PT 113+17.2
113+00
18" C.G.M.P.A.C. 30' Long
L-Type Hdw. Lt. (Sheet S-28)
S72°-44'-E
1937 7 52
Sta. 99+00 to 103+00
12" Sub-base of Gravel
Temp. Road
101+00
203' V.C.
760.12
+6.770 %
Temp. Road
104+00
400' V.C.
772.97
108+00
800' V.C.
787.50
+0.0575 %
Temp. Road
110+00
200' V.C.
774.20
Sta. 112+00 to 115+00
12" Sub-base of Gravel
-6.652 %
Sta. 103+00 to 112+00
12" Sub-base of Gravel
BM #16 SPIKE IN ROOT OF 12" PINE 30' LT STA. 102.42 ELEV. 759.98
BM #17 " " " " 15" PINE 39' LT STA. 104+50 ELEV. 771.11
BM #18 " " " " 15" " 55' RT STA. 106+95 ELEV. 770.01
BM #19 " " " " 15" SPRUCE 75' RT STA. 110+33 759.71
Town of Middlesex
Wrightsville Relocation
Section 142
