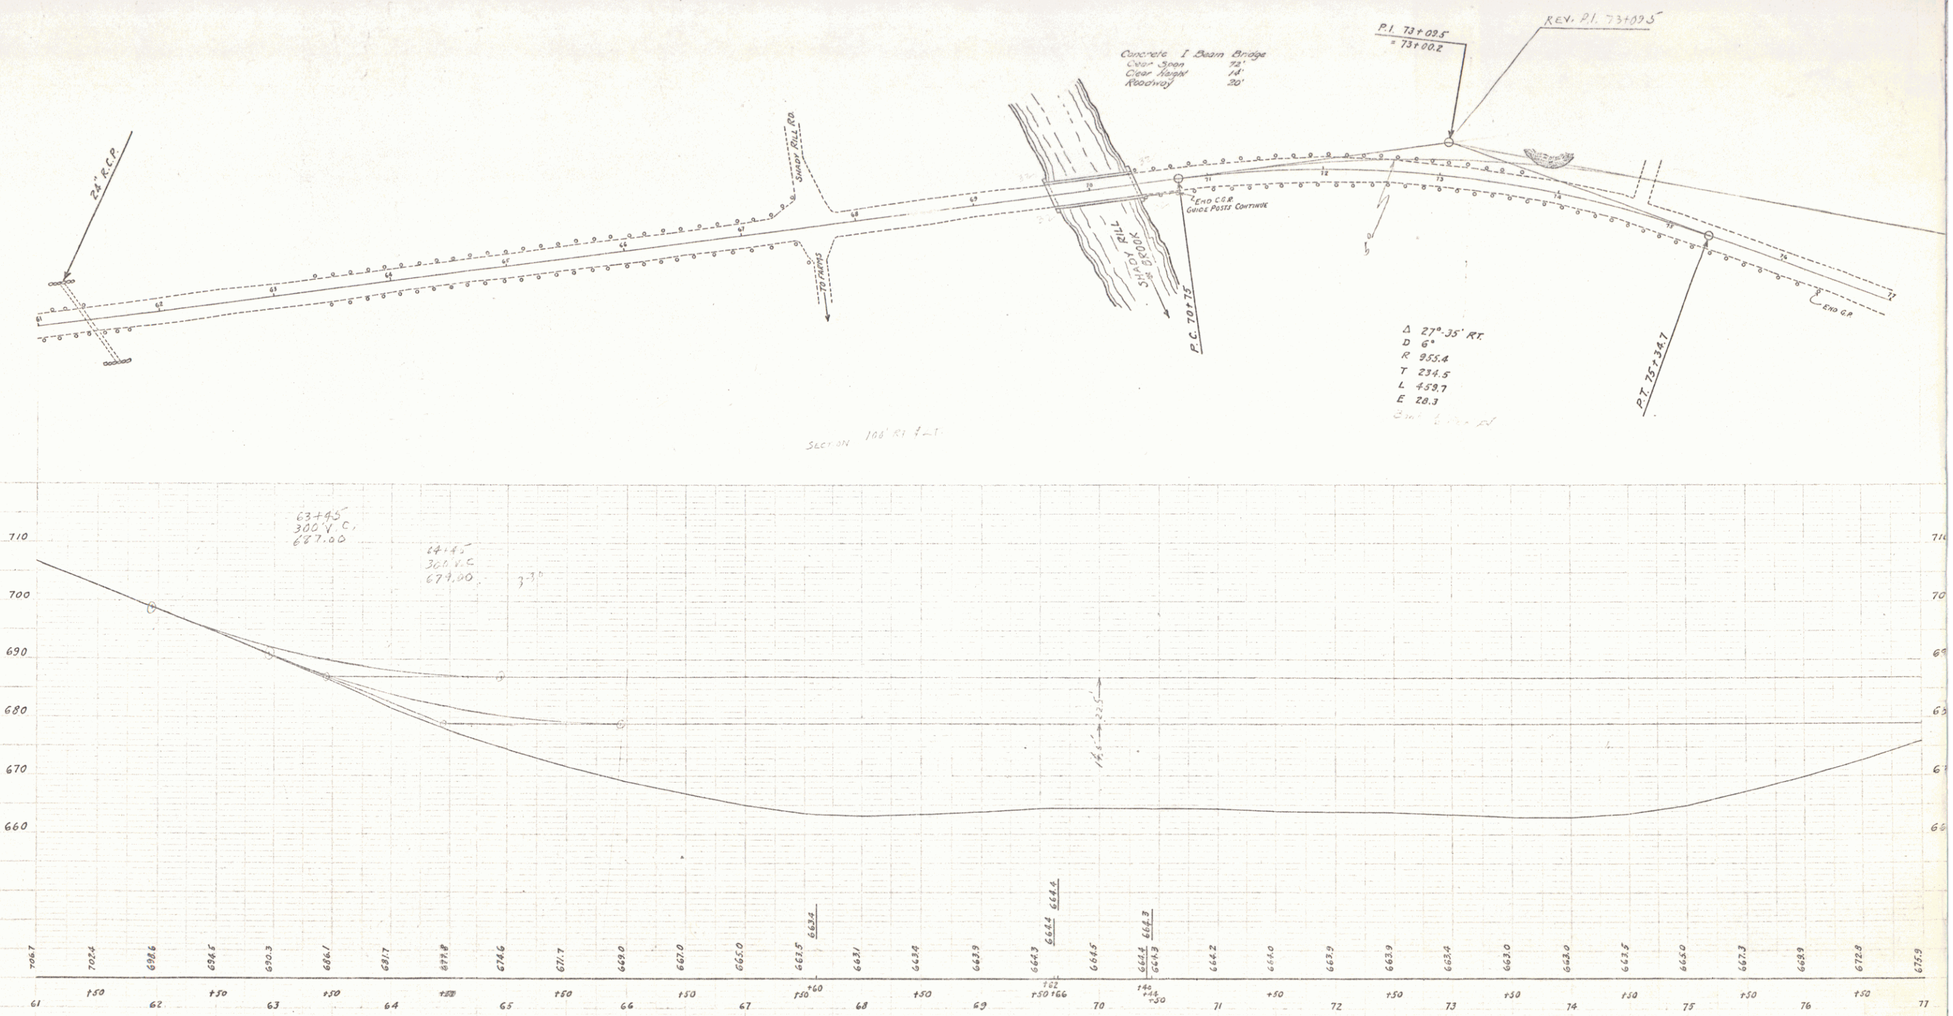
24" R.C.P.
Concrete I Beam Bridge
Clear Span 72'
Clear Height 14'
Roadway 30'
P.I. 73+09.5
= 73+00.2
REV. P.I. 73+09.5
END C&G
GUIDE POSTS CONTINUE
P.C. 70+75
P.T. 75+34.7
END G.R.
Δ 27°-35' RT.
D 6°
R 955.4
T 234.5
L 459.7
E 28.3
63+45
300' V.C.
687.00
64+45
300' V.C.
679.00
710
700
690
680
670
660
706.7
702.4
698.6
696.5
690.3
686.1
681.7
679.8
674.6
671.7
669.0
667.0
665.0
663.5
663.1
663.4
663.9
664.3
664.4
664.5
664.4
664.3
664.2
664.0
663.9
663.9
663.4
663.0
662.0
662.5
663.0
667.3
669.9
672.8
675.9
61
62
63
64
65
66
67
68
69
70
71
72
73
74
75
76
77
TOWN OF MIDDLESEX
WRIGHTSVILLE RELOCATION
TRAVERSE LINE
SHEET 3 OF SHEETS

35