


DATE
 DRAWN BY
 CHECKED BY
 SCALE
 SHEET NO.

DATE
 DRAWN BY
 CHECKED BY
 SCALE
 SHEET NO.

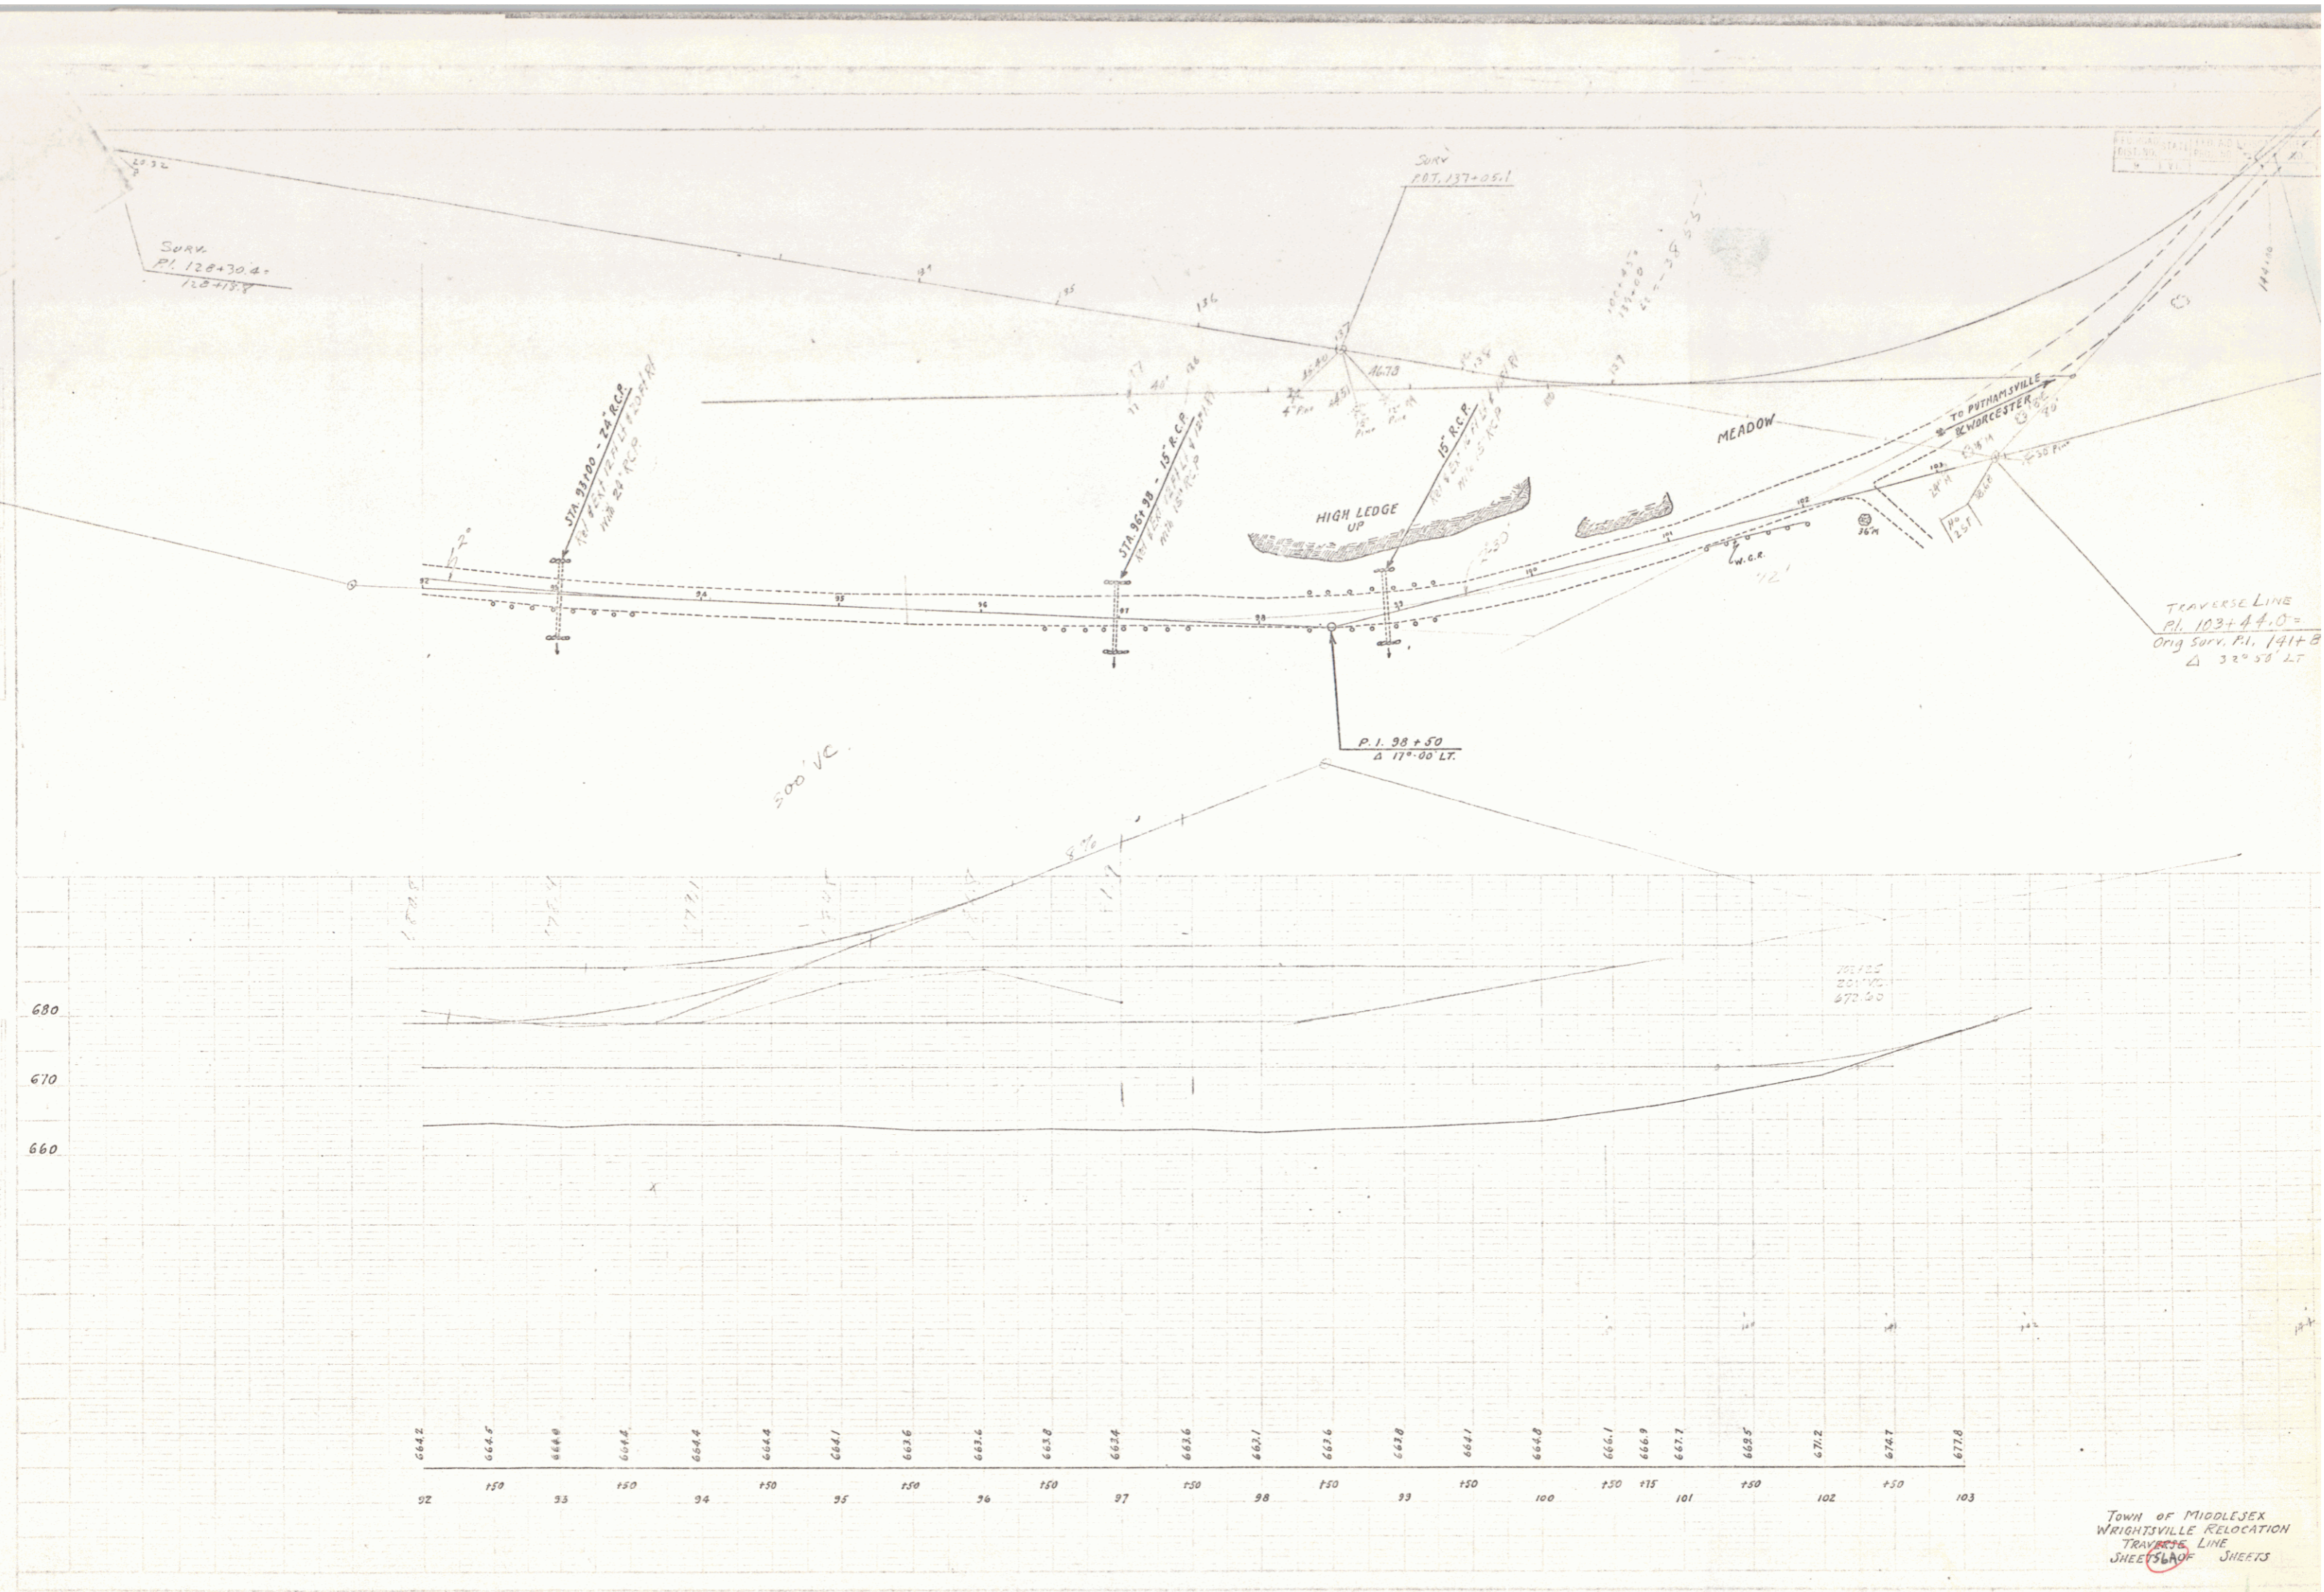

TOWN OF MIDDLESEX
 WRIGHTSVILLE RELOCATION
 TRAVERSE LINE
 SHEETS 38 SHEETS 39