FED. NO.	STATE	PROJ. NO.	SHEET NO.	TOTAL SHEETS
5	VT		1937 5	26

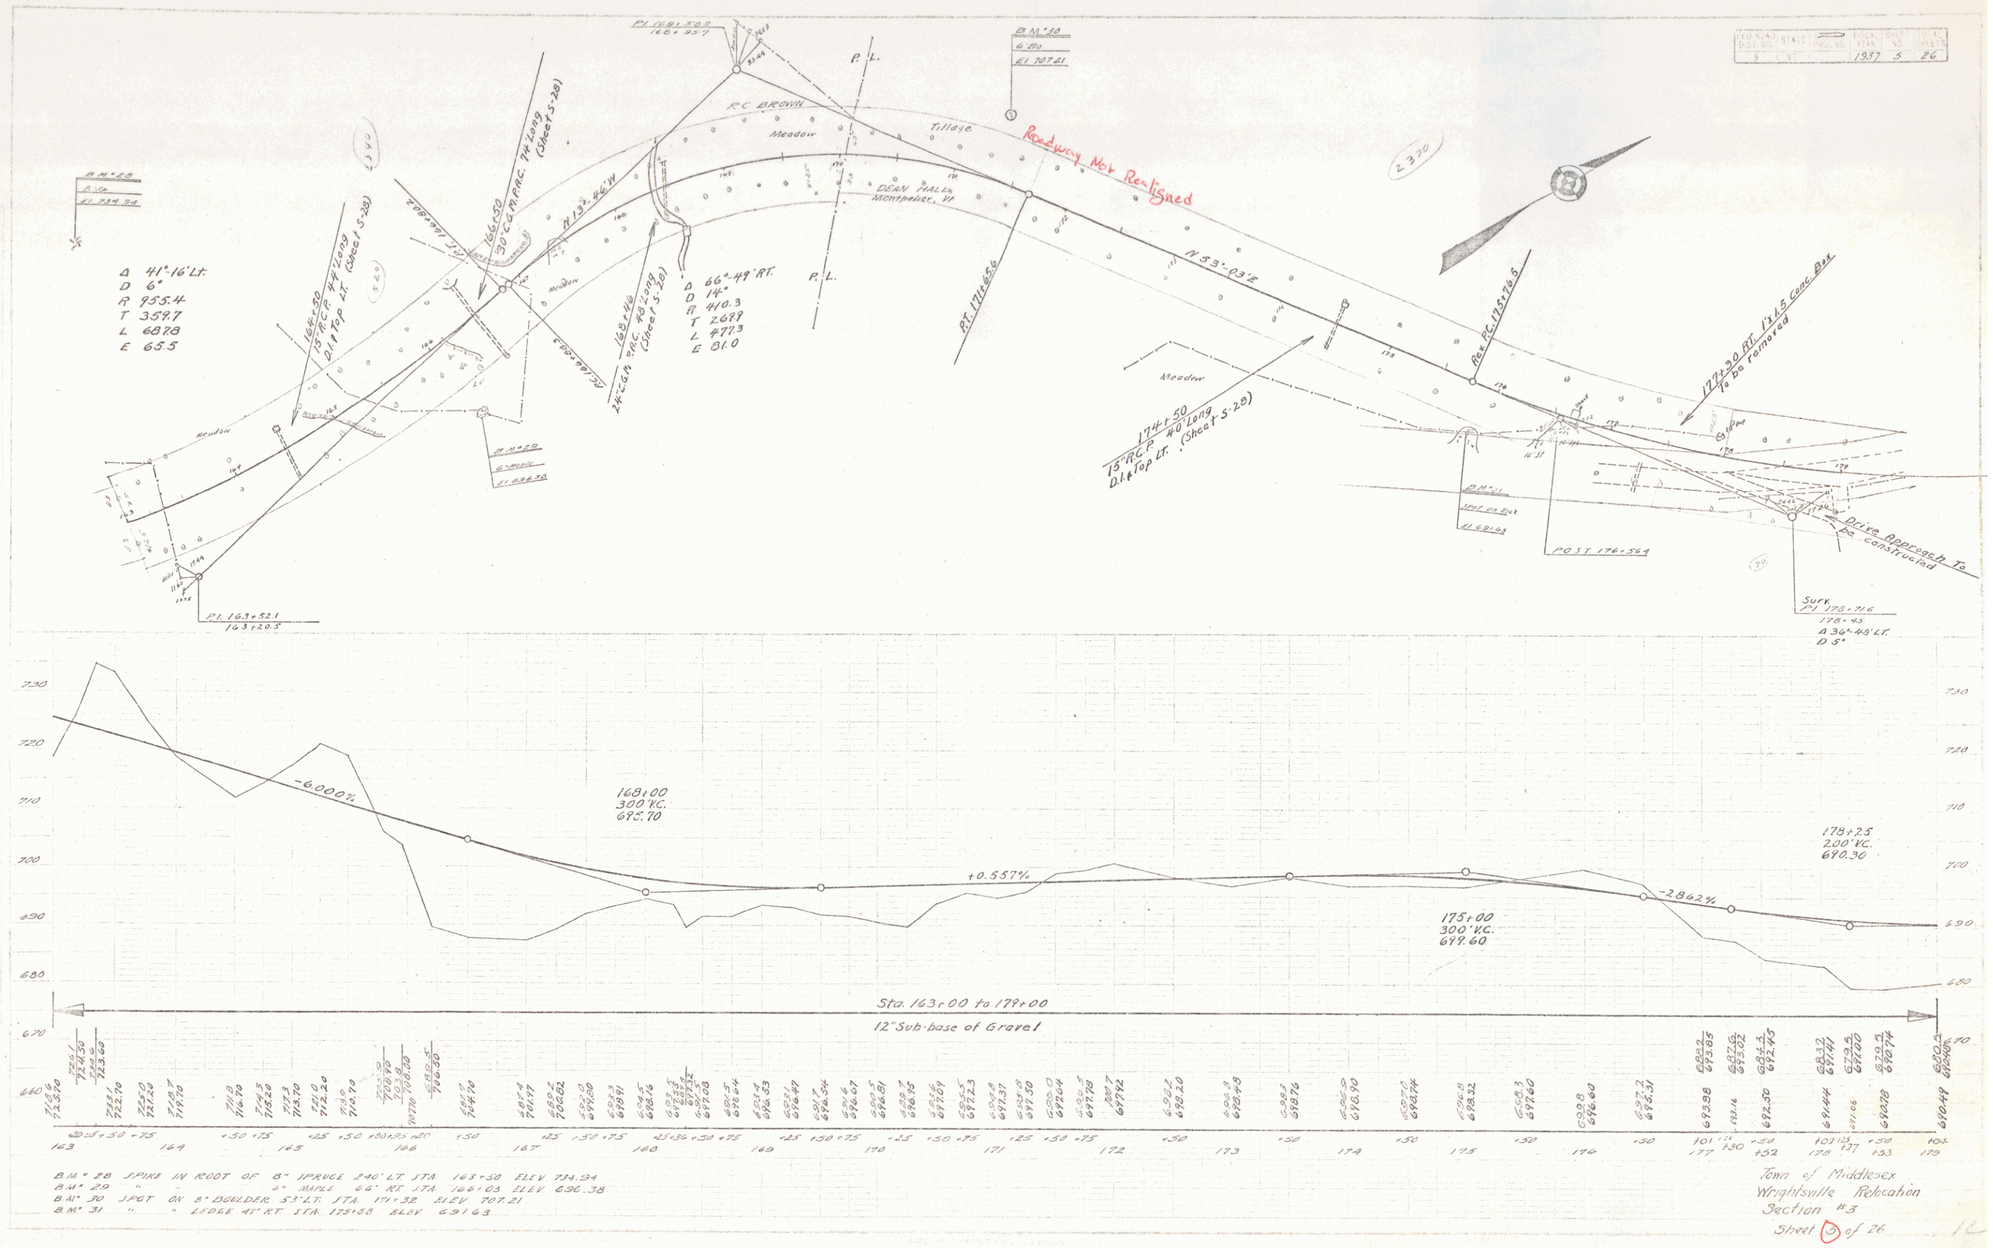

B.M. 28 SPIKE IN ROOT OF 8" SPRUCE 240' LT. STA. 163+50 ELEV. 734.94
B.M. 29 " " 6" MAPLE 66' RT. STA. 166+03 ELEV. 696.38
B.M. 30 SPOT ON 8" BOULDER 53' LT. STA. 171+32 ELEV. 707.21
B.M. 31 " " LEDGE 47' RT. STA. 173+38 ELEV. 691.63

Town of Middlesex
Wrightsville Relocation
Section #3
Sheet 5 of 26