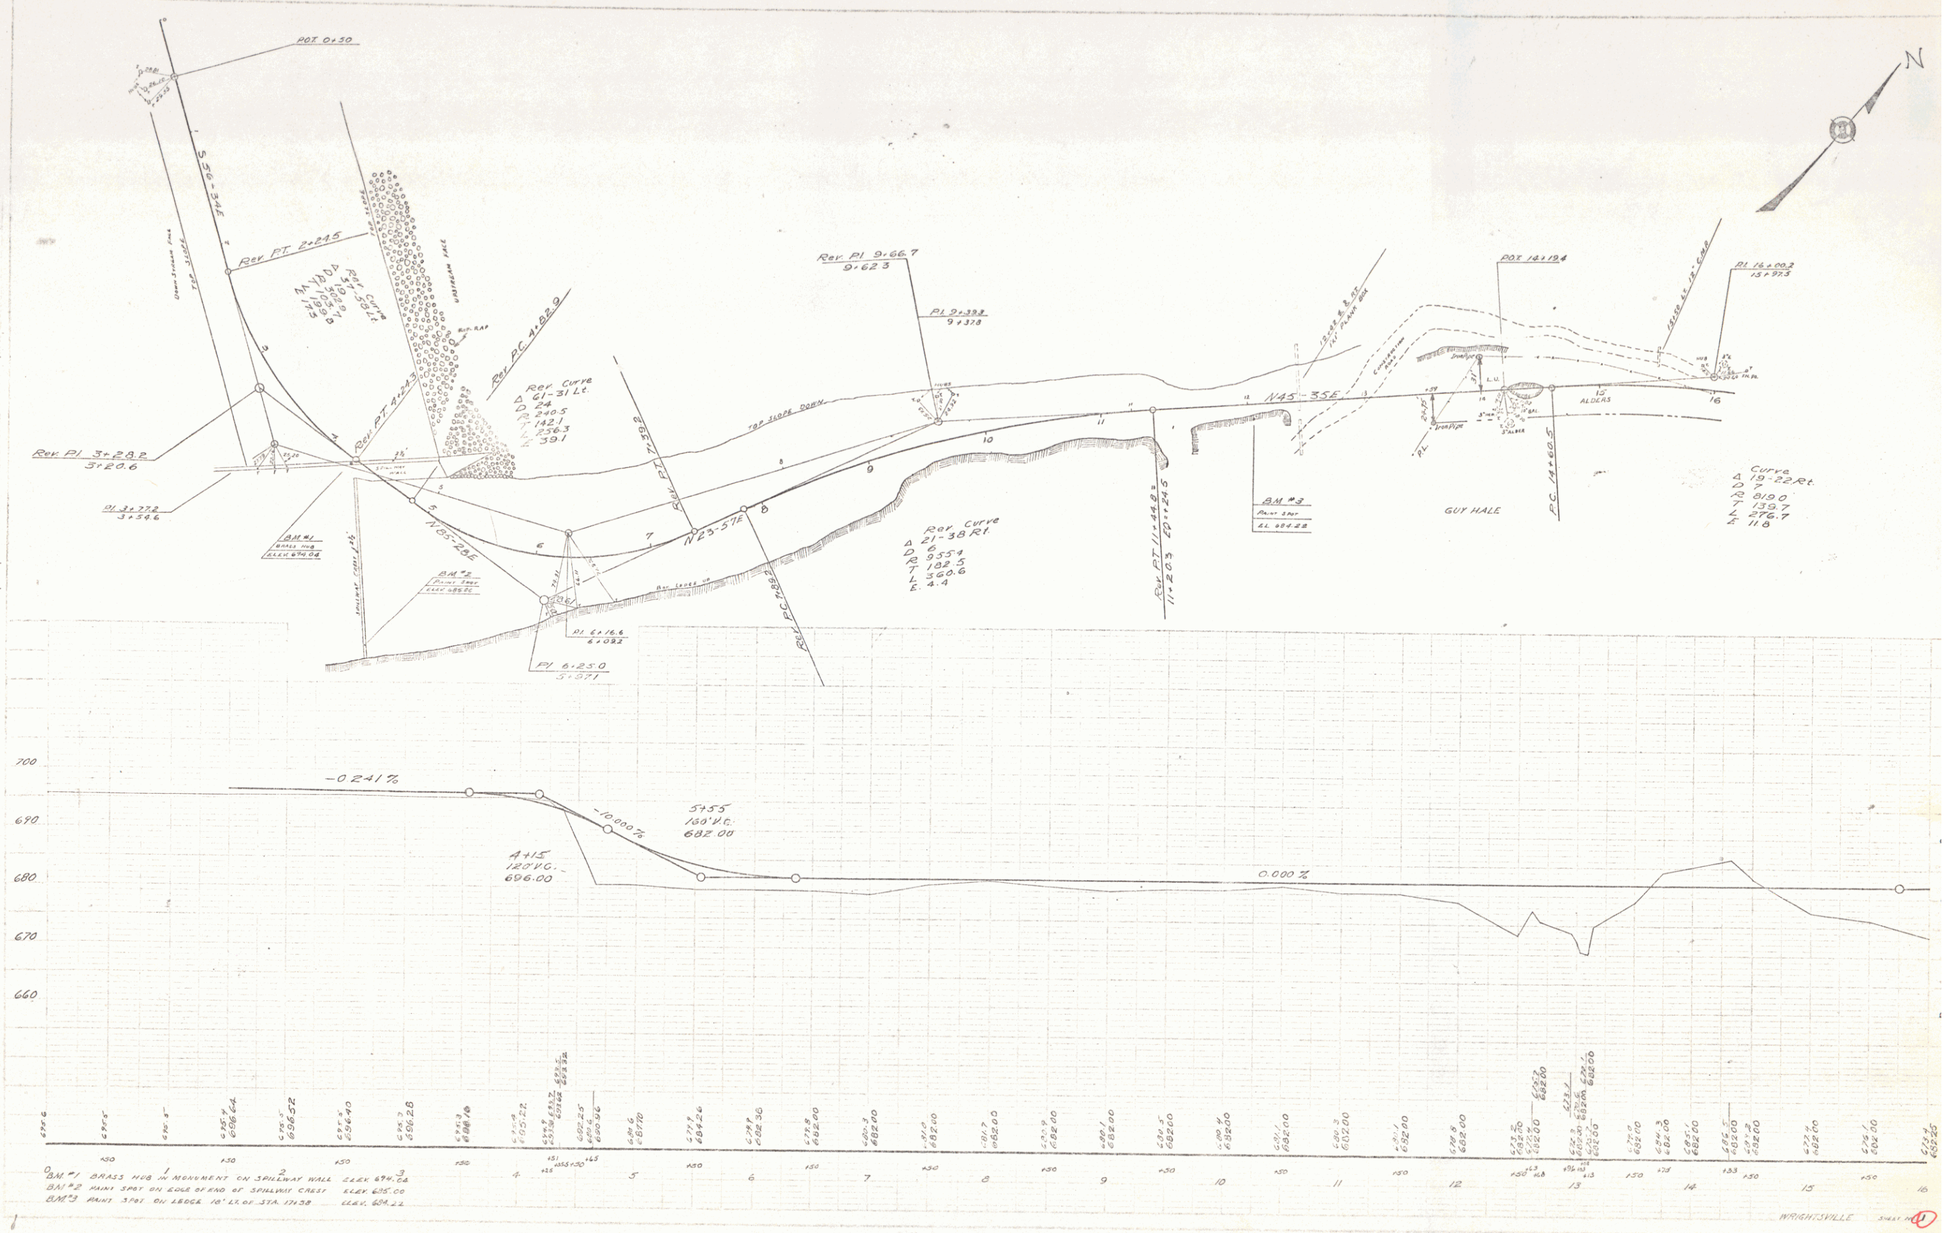
POT 0+30
S 56-34E
Rev PT 2+24.5
Rev PC 4+82.9
Rev Curve
Δ 61-31 Lt.
D 24
R 240.5
T 142.1
L 256.3
E 39.1
Rev PI 3+28.2
3+20.6
PI 3+77.2
3+56.6
BM #1
BRASS HUB
ELEV 694.08
BM #2
PAINT SPOT
ELEV 685.00
N 85-28E
Rev PT 4+29.8
Rev PC 4+82.2
N 23-37E
PI 6+16.6
6+03.2
PI 6+25.0
5+97.1
Rev PI 9+66.7
9+62.3
PI 9+39.2
9+37.8
POT SLOPE DOWN
Rev Curve
Δ 21-38 Rt.
D 6
R 955.4
T 102.5
L 360.6
E 4.4
Rev PT 11+48.8
11+29.5
N 45-35E
BM #3
PAINT SPOT
EL 684.22
GUY HALE
PC 14+60.5
POT 14+194
ALDERS
PI 16+00.2
15+97.5
Curve
Δ 19-22 Rt.
D 7
R 819.0
T 139.7
L 276.7
E 11.6
N

700
690
680
670
660
-0.241 %
-10.000 %
0.000 %
A+15
120' V.C.
696.00
5+55
160' V.C.
682.00
BM #1 BRASS HUB IN MONUMENT ON SPILLWAY WALL ELEV. 694.08
BM #2 PAINT SPOT ON EDGE OF END OF SPILLWAY CREST ELEV. 685.00
BM #3 PAINT SPOT ON LEDGE 18' LT. OF STA. 17+58 ELEV. 684.22
WRIGHTSVILLE

51