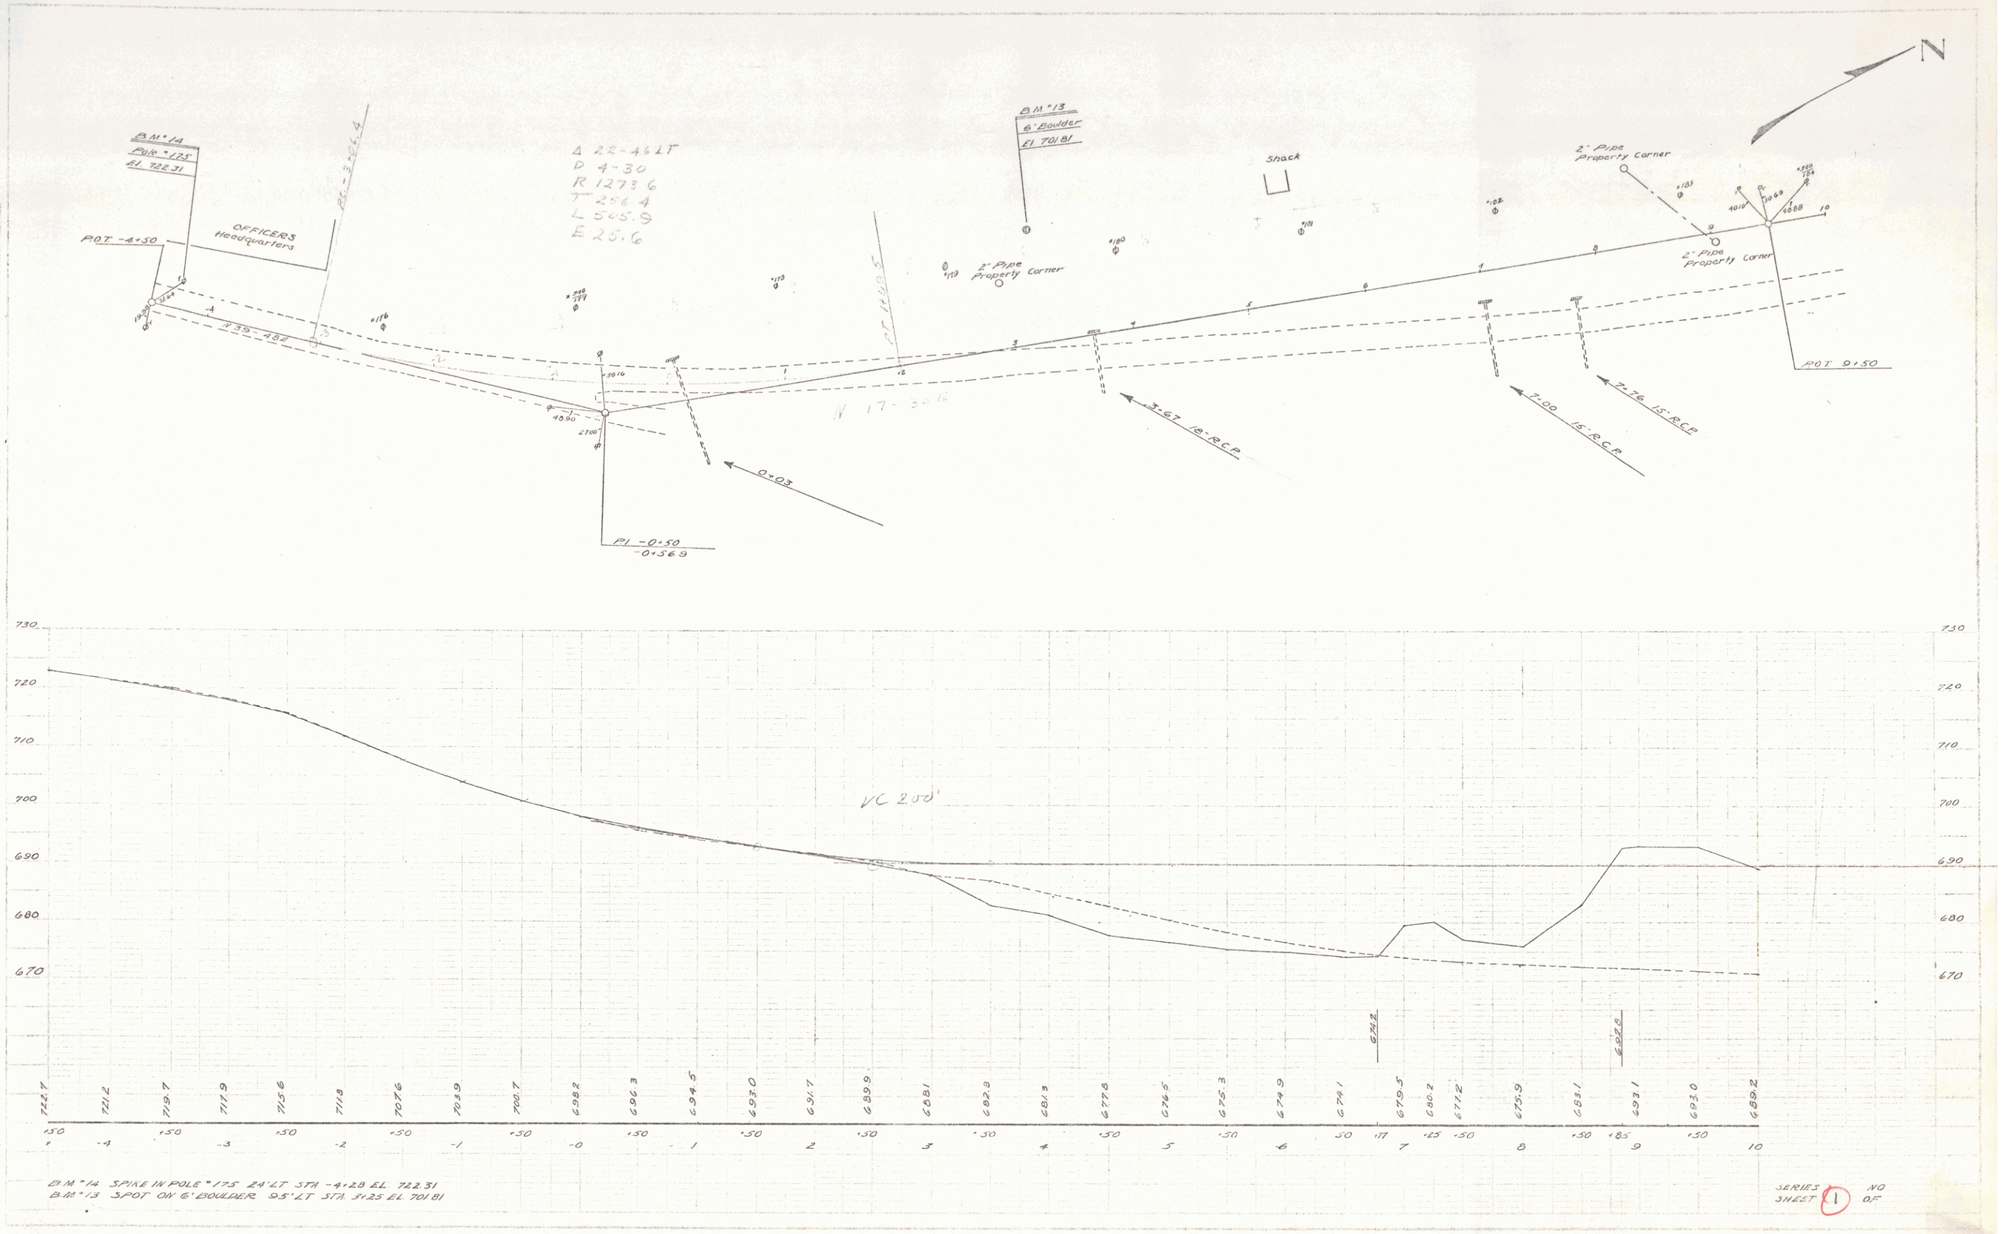
BM #14
Pole #175
El. 722.31
POT -4+30
OFFICERS
Headquarters
Δ 22-46 LT
D 4-30
R 1273.6
T 256.4
L 505.9
E 25.6
BM #13
6' Boulder
El. 701.81
2" Pipe
Property Corner
Shack
2" Pipe
Property Corner
2" Pipe
Property Corner
POT 0+50
PI -0+50
-0+56.9
0+03
3+67 18" RCP
7+00 15" RCP
7+76 15" RCP
730
720
710
700
690
680
670
VC 200'
722.7
721.2
719.7
717.9
715.6
713.3
707.6
703.9
700.7
698.2
696.3
694.5
693.0
691.7
689.9
688.1
686.3
684.3
677.8
676.5
675.3
674.9
674.1
679.5
680.2
677.2
675.9
683.1
693.1
693.0
689.2
-4
-3
-2
-1
-0
1
2
3
4
5
6
7
8
9
10
BM #14 SPIKE IN POLE #175 24' LT STA -4+28 EL 722.31
BM #13 SPOT ON 6' BOULDER 9.5' LT STA 3+25 EL 701.81
SERIES 1 NO
SHEET OF
63