1935 9 93

Reinforced Concrete Pipe

Station	Diameter	Length	C.R.M.
78 + 30	15"	36'	1.9
90 + 23	15"	36'	1.9

Corr. Galv. Metal Pipe (Asp. Ctd.)

Station	Diameter	Length	Conc. A	Steel.
85 + 23	48"	50'	80 cy.	90 lbs.

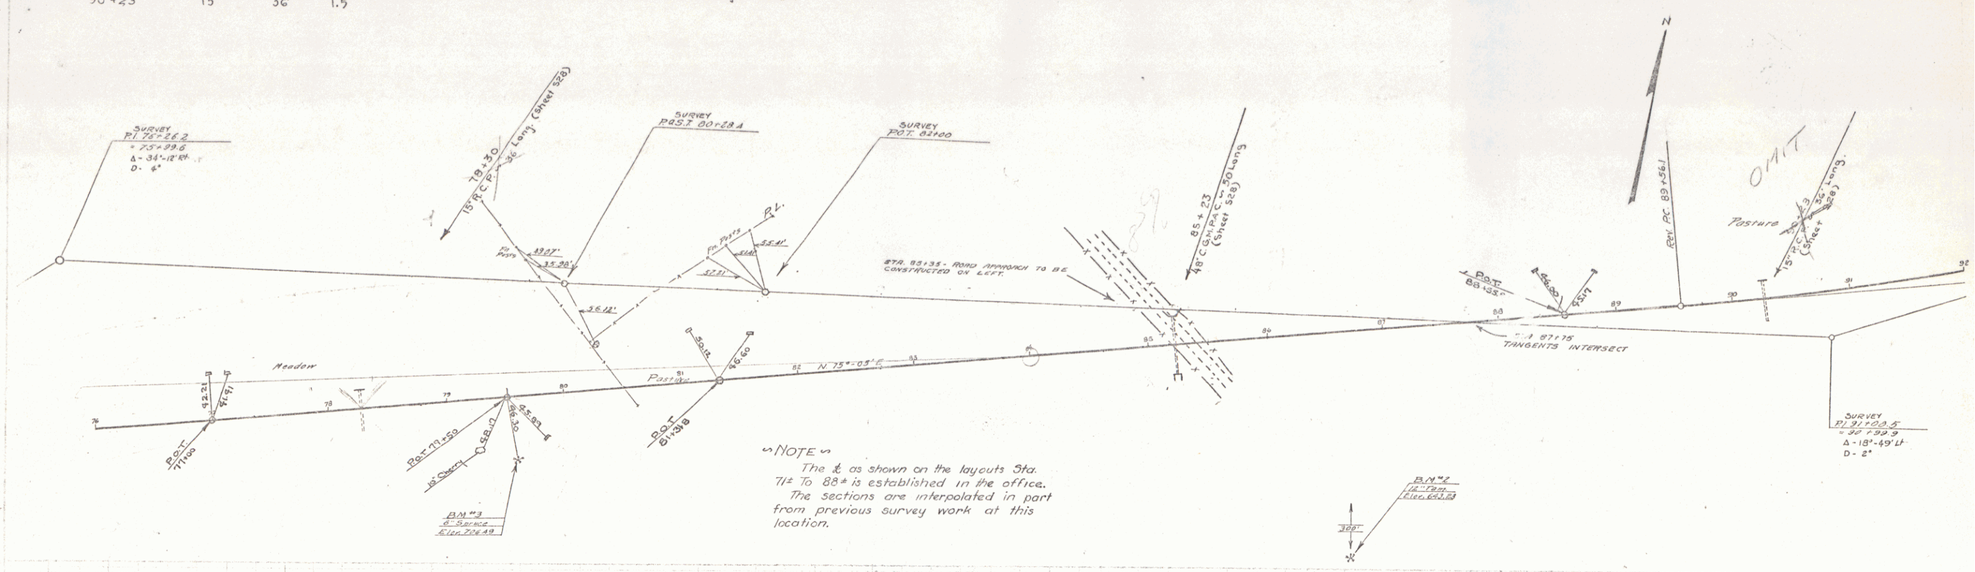

NOTE

The ℄ as shown on the layouts Sta. 71+ To 88+ is established in the office. The sections are interpolated in part from previous survey work at this location.

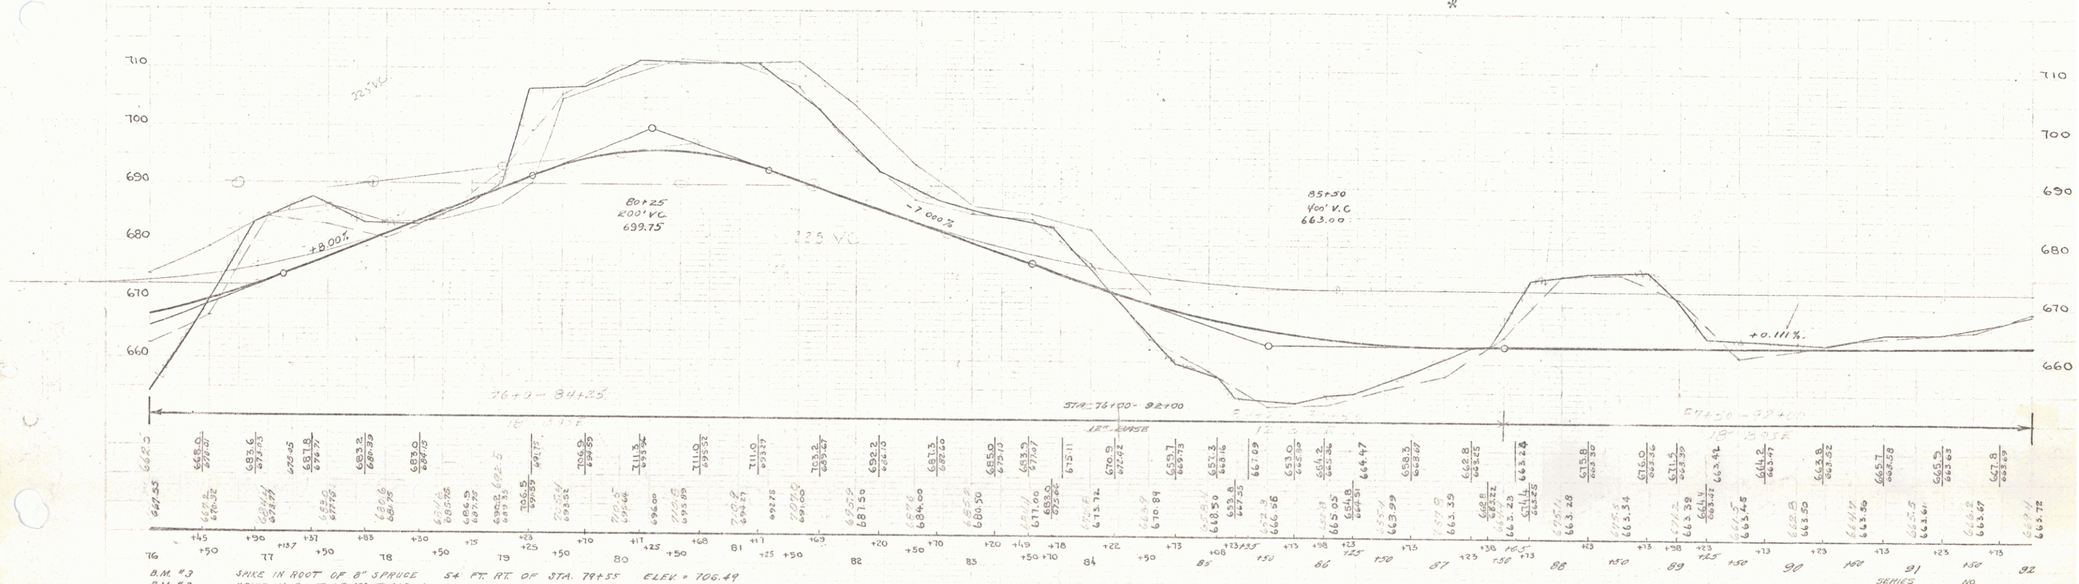

Series No. 9
Sheet of 93

71