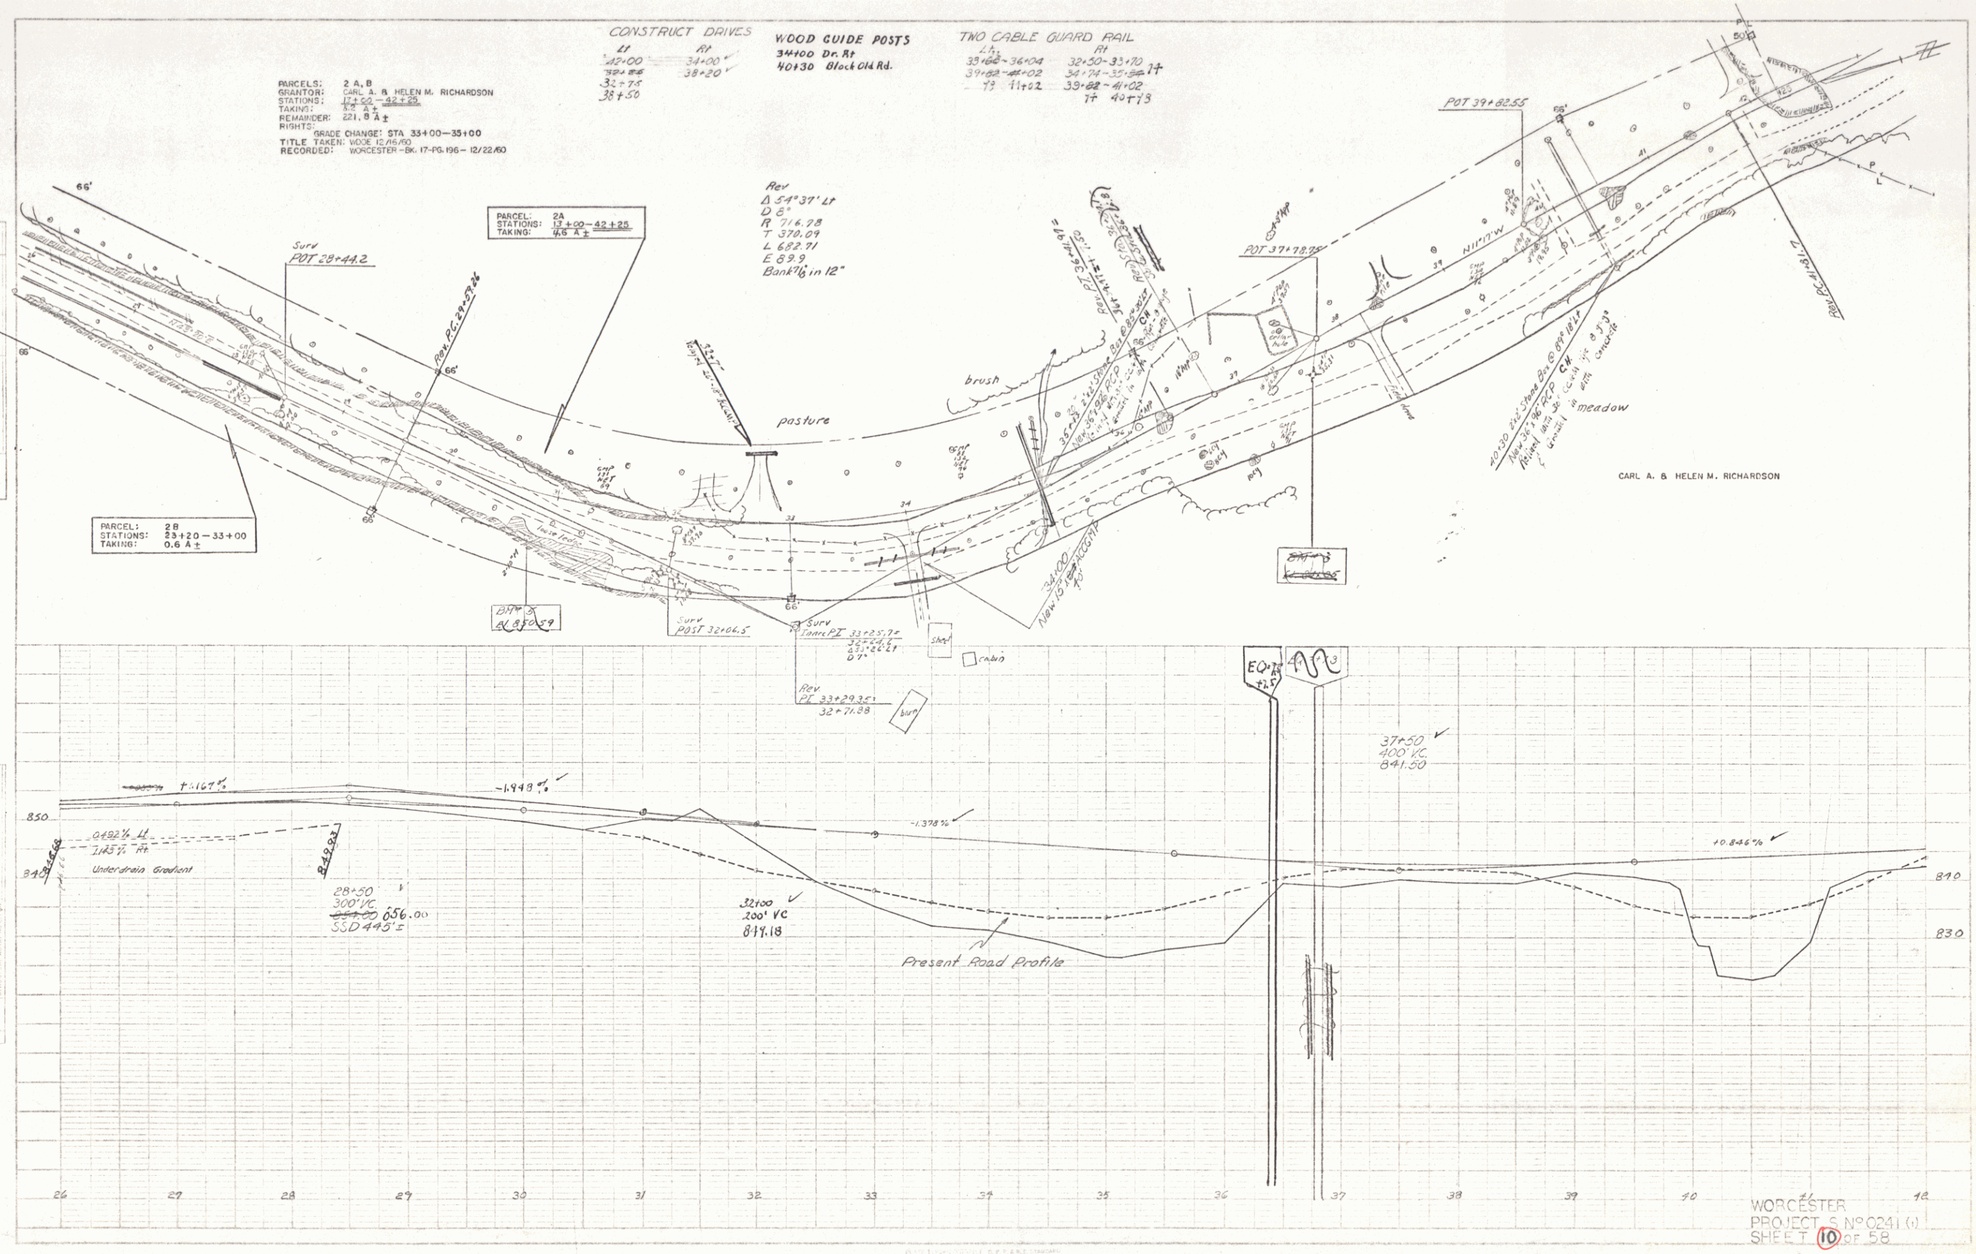
CONSTRUCT DRIVES
Lt Rt
42+00 34+00
38+20
32+75
38+50
WOOD GUIDE POSTS
34+00 Dr. Rt
40+30 Block Old Rd.
TWO CABLE GUARD RAIL
Lt. Rt
33+68 - 36+04 32+50 - 33+70
39+68 - 41+02 34+74 - 35+
73 71+02 39+68 - 41+02
71 40+73
PARCELS: 2 A, B
GRANTOR: CARL A. & HELEN M. RICHARDSON
STATIONS: 13+00 - 42+25
TAKING: 4.6 A ±
REMAINDER: 221.8 A ±
RIGHTS:
GRADE CHANGE: STA 33+00—35+00
TITLE TAKEN: MODE 12/15/60
RECORDED: WORCESTER - BK. 17-PG. 196 - 12/22/60
PARCEL: 2A
STATIONS: 13+00 - 42+25
TAKING: 4.6 A ±
PARCEL: 2B
STATIONS: 33+20 - 33+00
TAKING: 0.6 A ±
Rev
Δ 54°37' Lt
D 8°
R 716.78
T 370.09
L 682.71
E 89.9
Bank 1% in 12"
POT 28+44.2
POT 39+82.55
POT 39+78.75
pasture
brush
meadow
CARL A. & HELEN M. RICHARDSON
POST 32+04.5
Shed
cabin
37+50
400' VC
841.50
+1.167%
-1.948%
-1.378%
+0.846%
Underdrain Gradient
28+50
300' VC
656.00
SSD 445' ±
32+00
200' VC
844.18
Present Road Profile
850
840
830
26
27
28
29
30
31
32
33
34
35
36
37
38
39
40
41
42
WORCESTER
PROJECT S N° 0241 (1)
SHEET 10 of 58
3