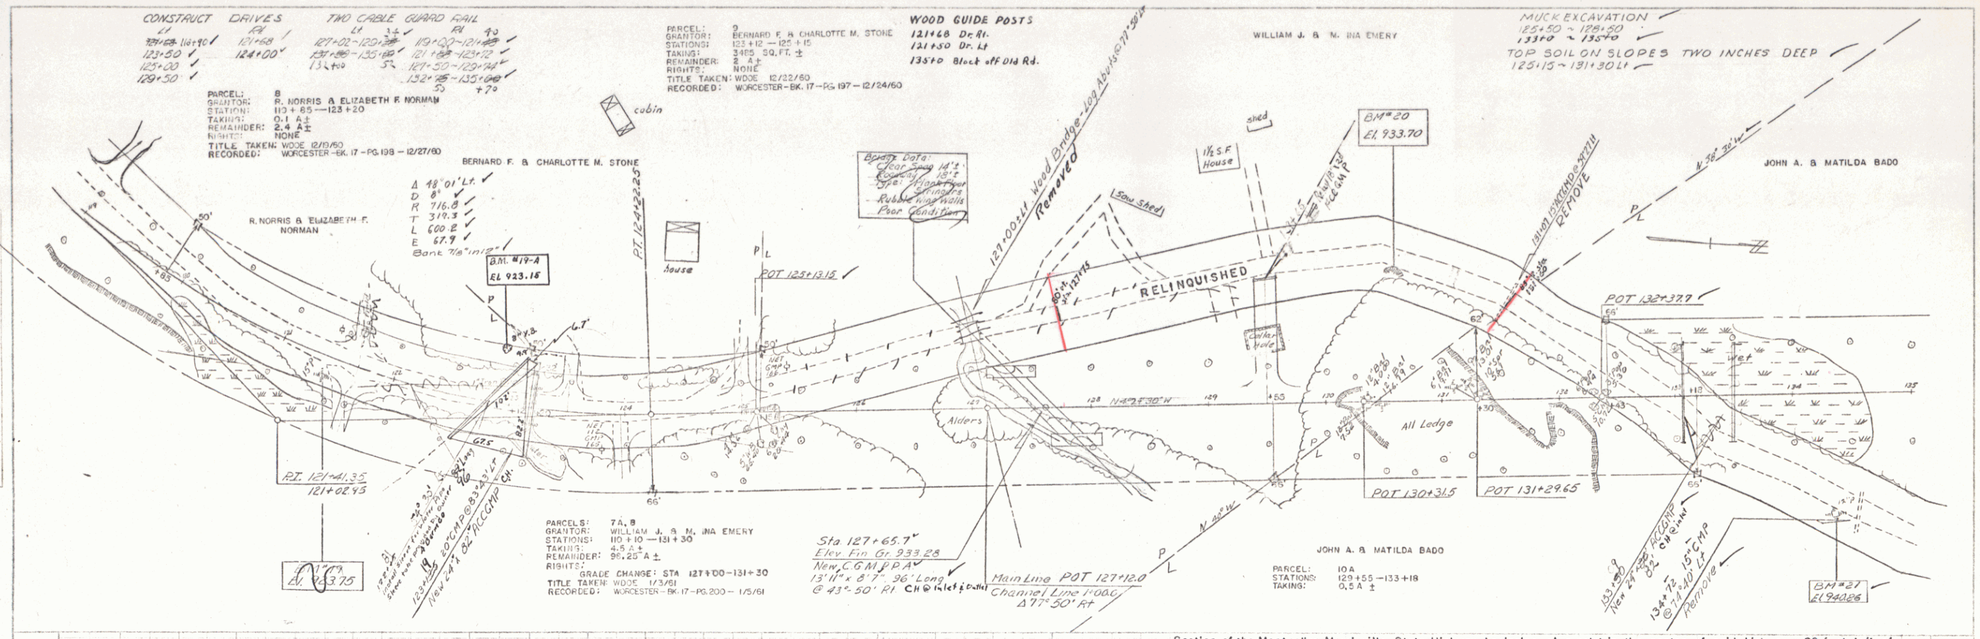

Section of the Montpelier-Morrisville State Highway, beginning at a point in the center of said highway, ± 80 feet left of survey sta. 127+75 of Highway Project, Worcester S 0241(1), and continuing ±400 feet northerly in said former highway to a point, ±85 feet left of sta. 131+60 of said project, is hereby relinquished and returned to the Town of Worcester and recorded in Book, 15, Page, 528, of Land Records of the Town of Worcester, December 12, 1963.

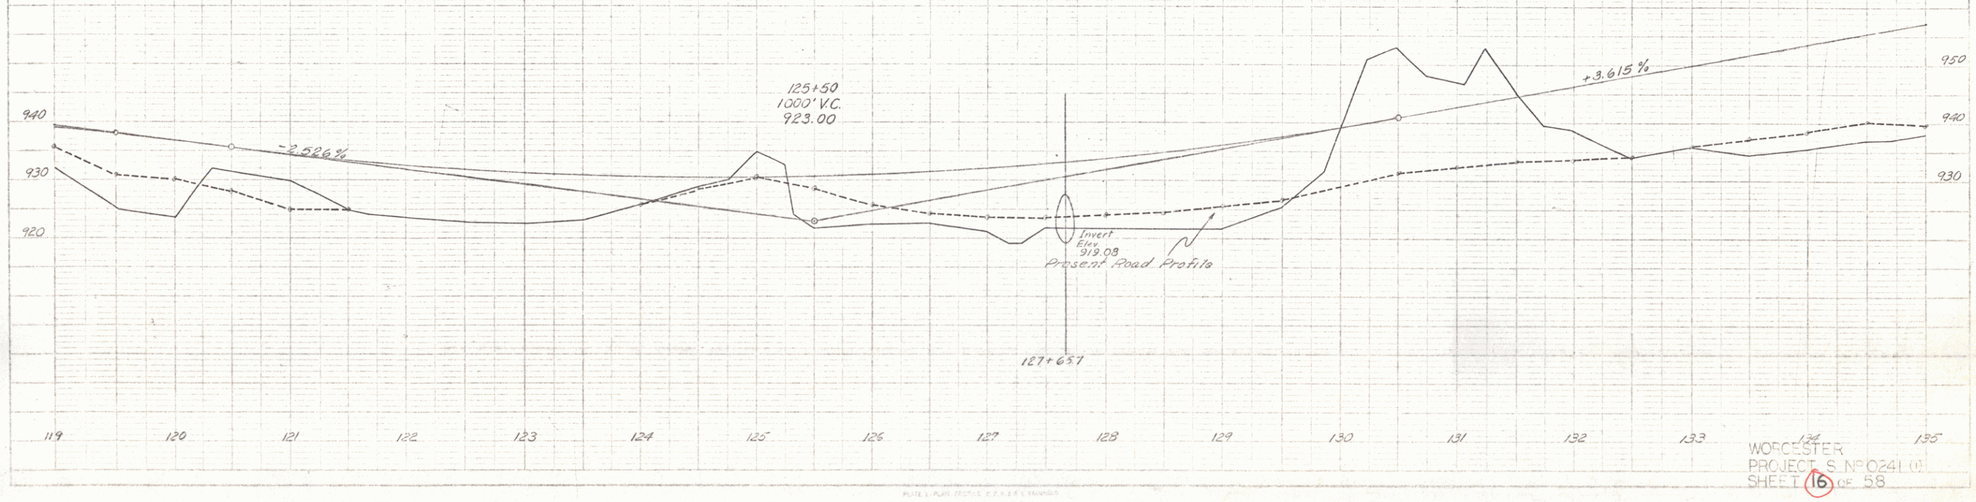

WORCESTER
PROJECT S. Nº 0241 (1)
SHEET 16 OF 58

10