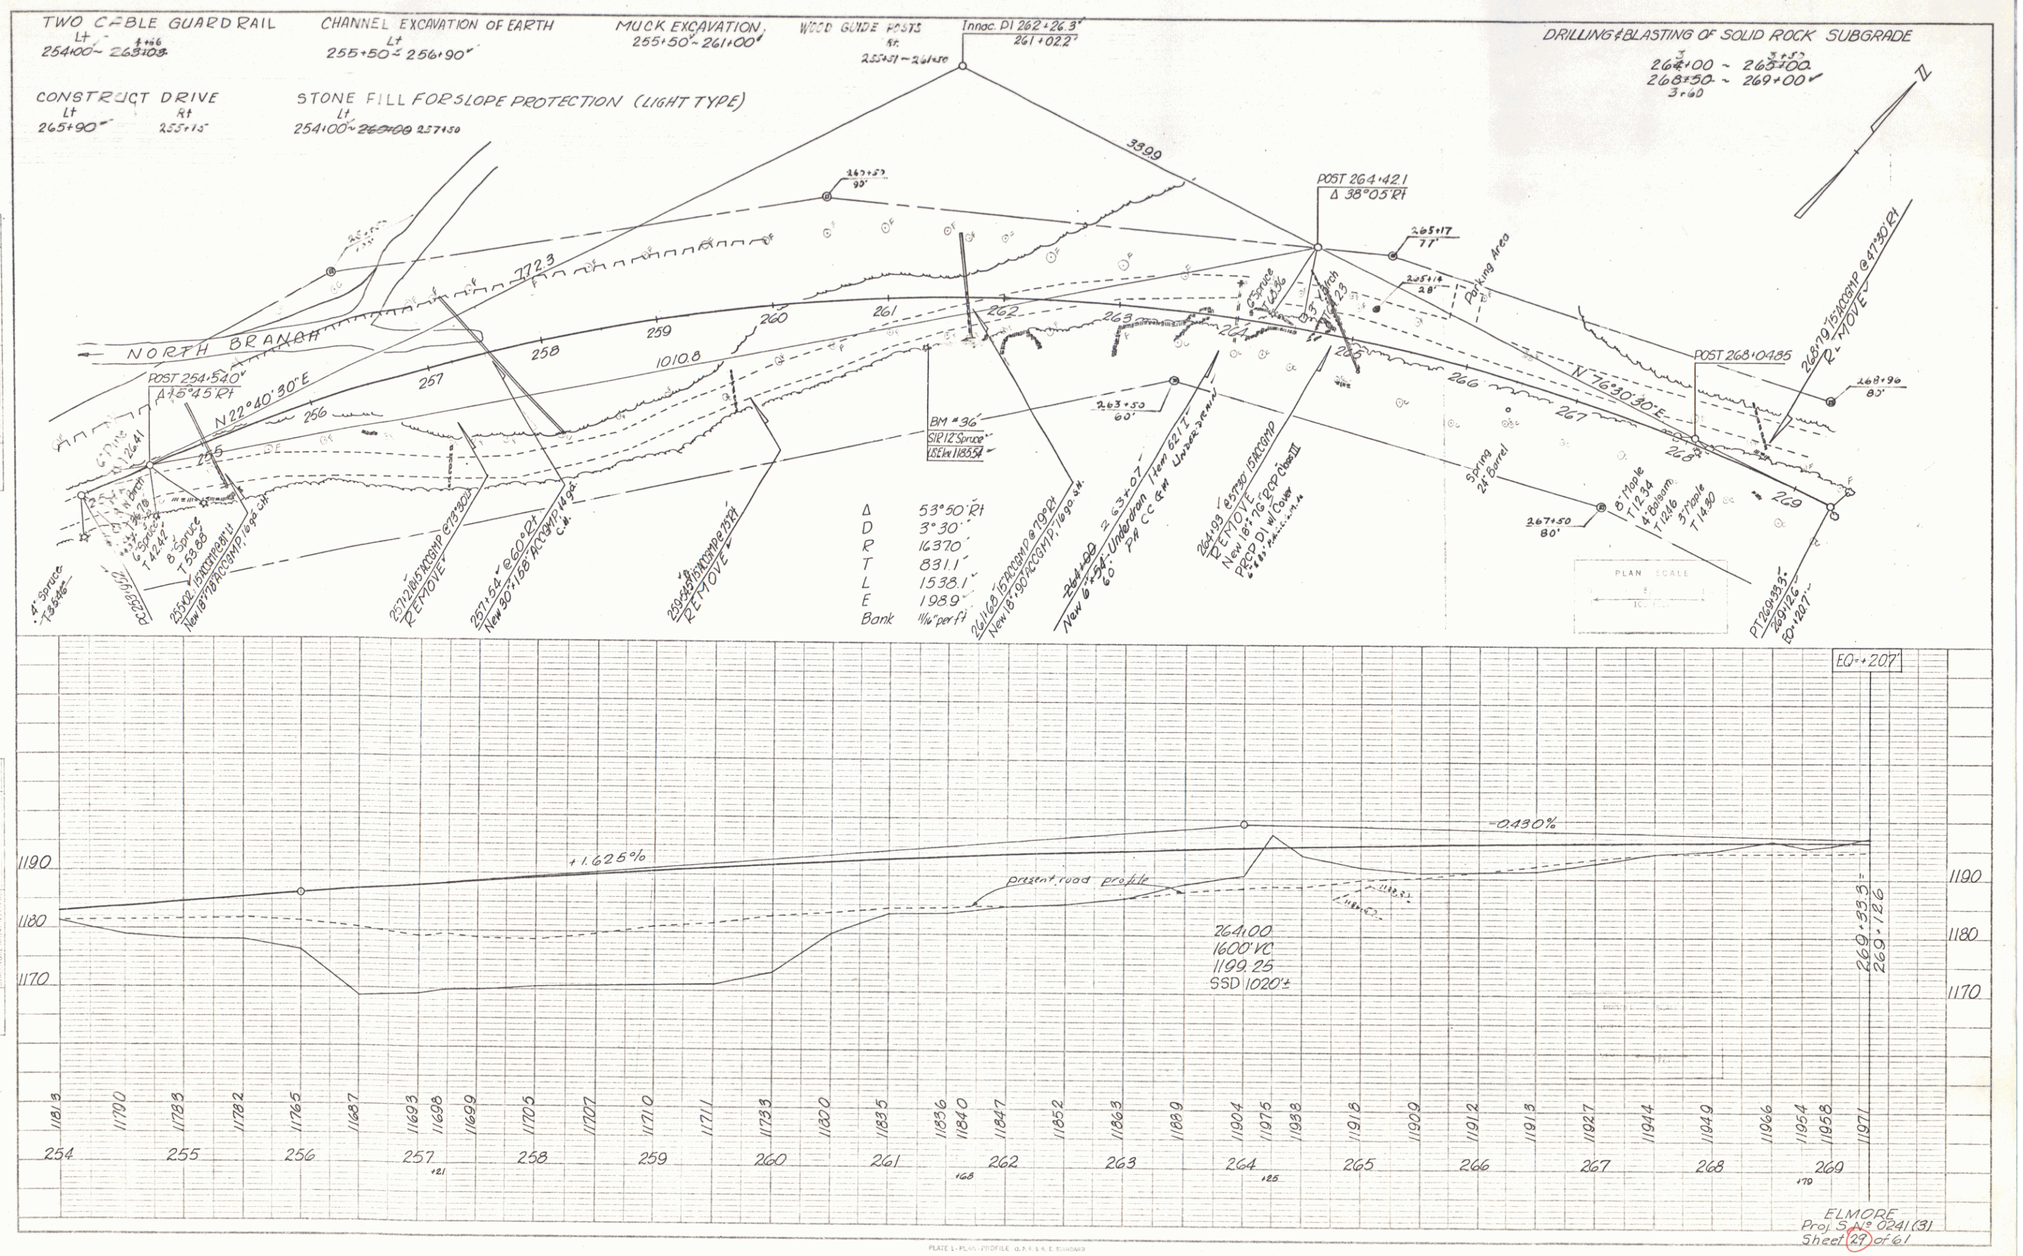

PLATE 1 - PLAN - PROFILE O.P.R.&R.E. STANDARD
REGIFIL & CISLER CO., NEW YORK

3