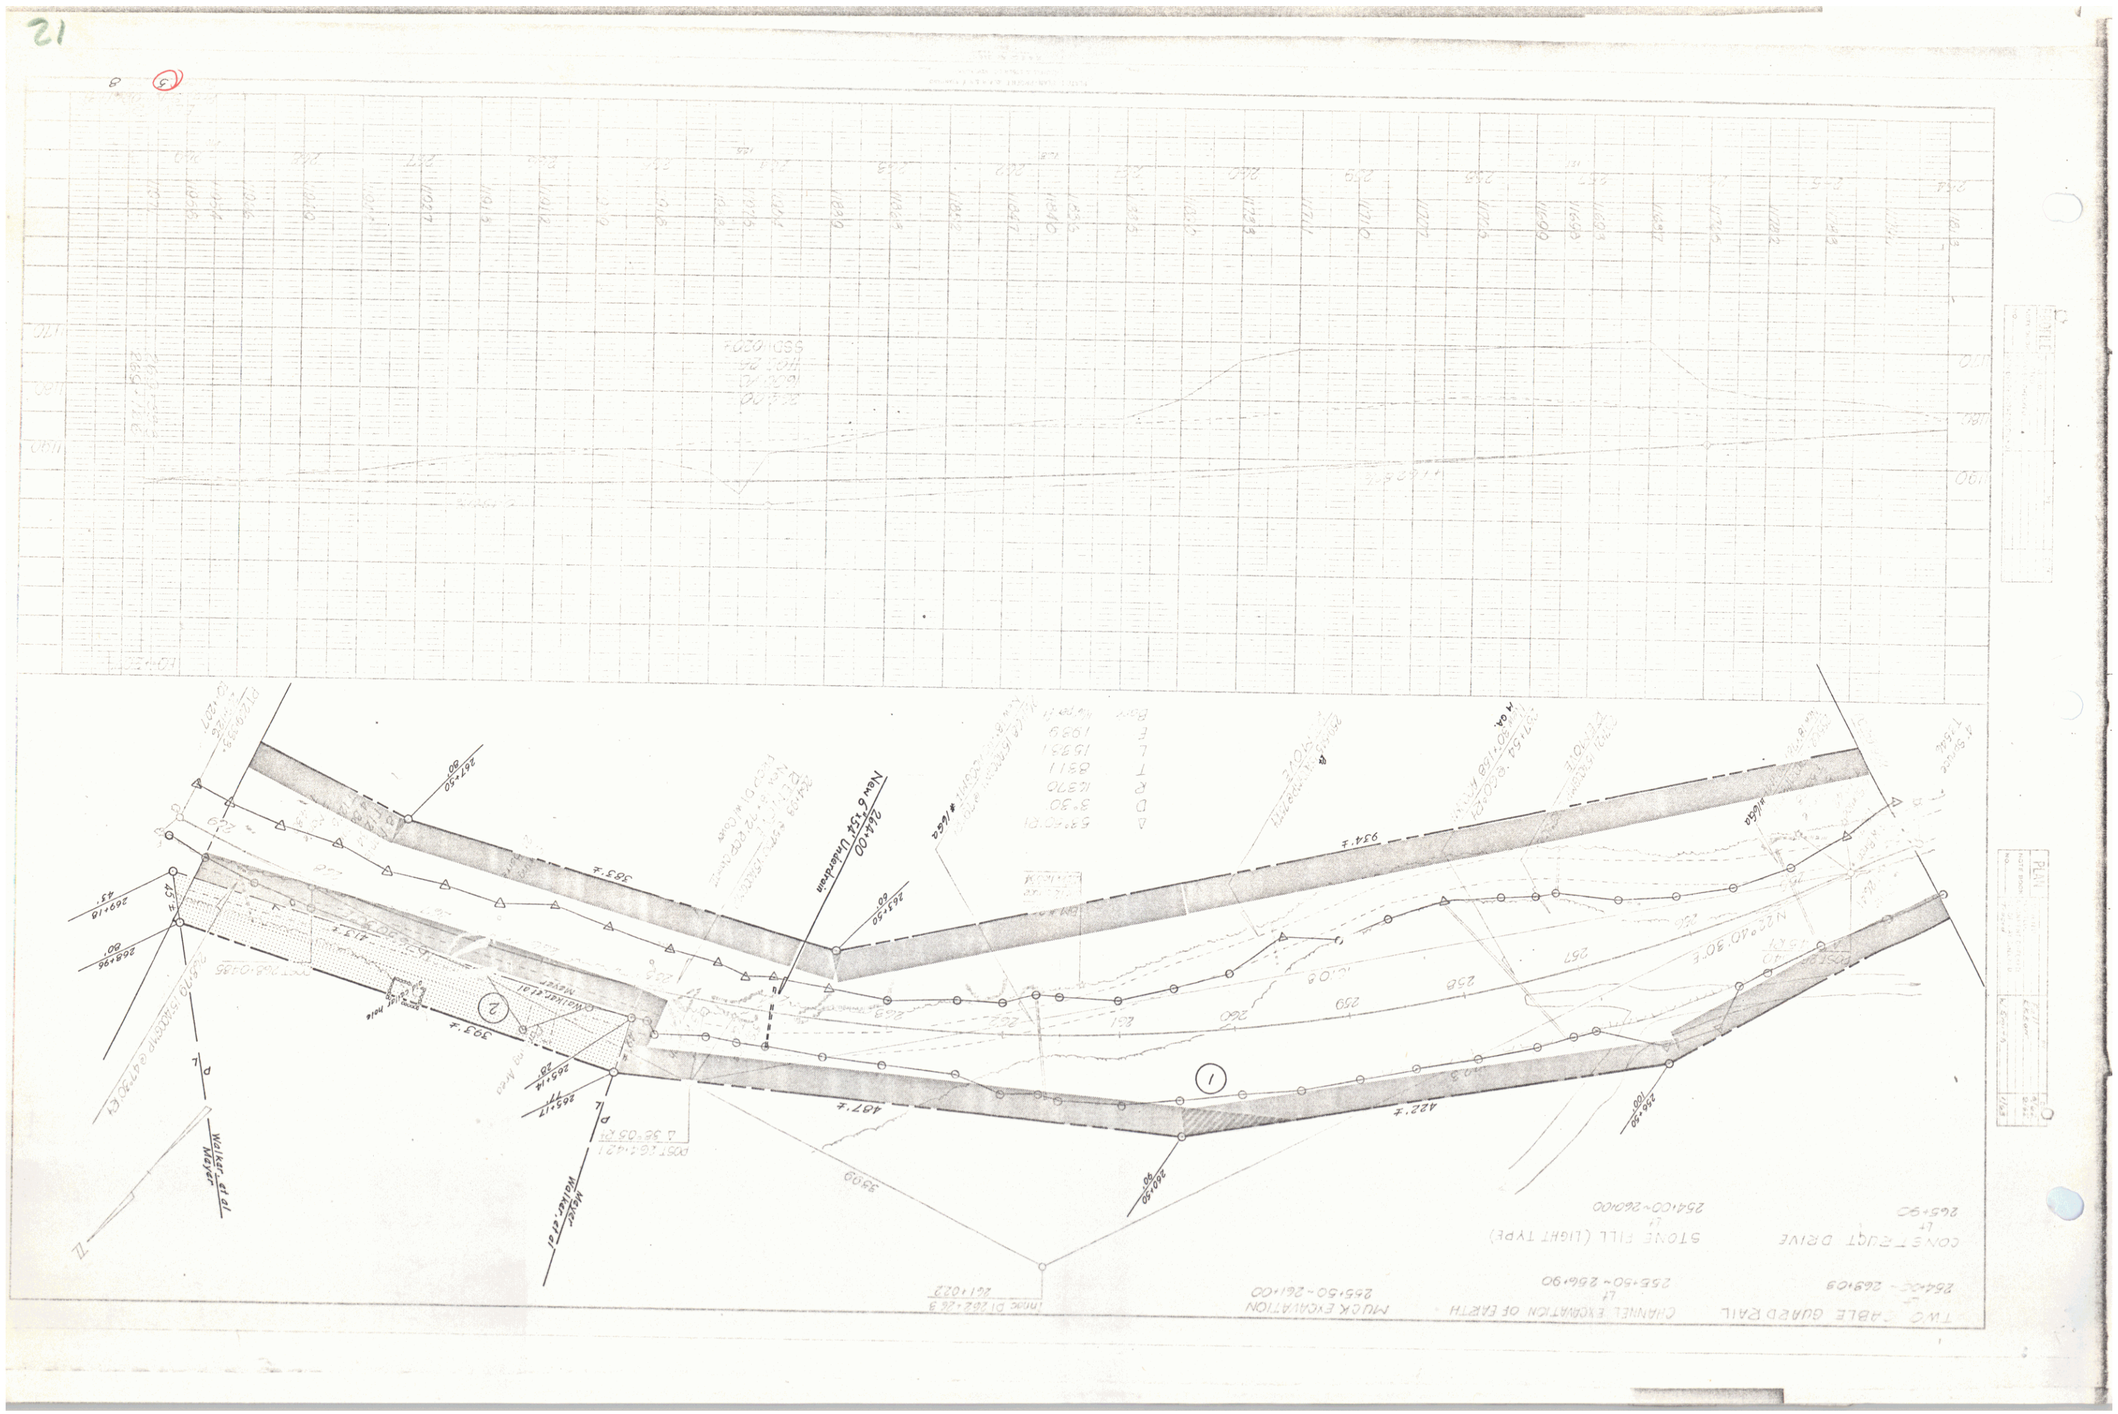
TWO CABLE GUARD RAIL
CHANNEL EXCAVATION OF EARTH
MUCK EXCAVATION
CONE TRUCK DRIVE
STONE FILL (LIGHT TYPE)
Now 6 1/2# Underdrain
Meter
Water
