




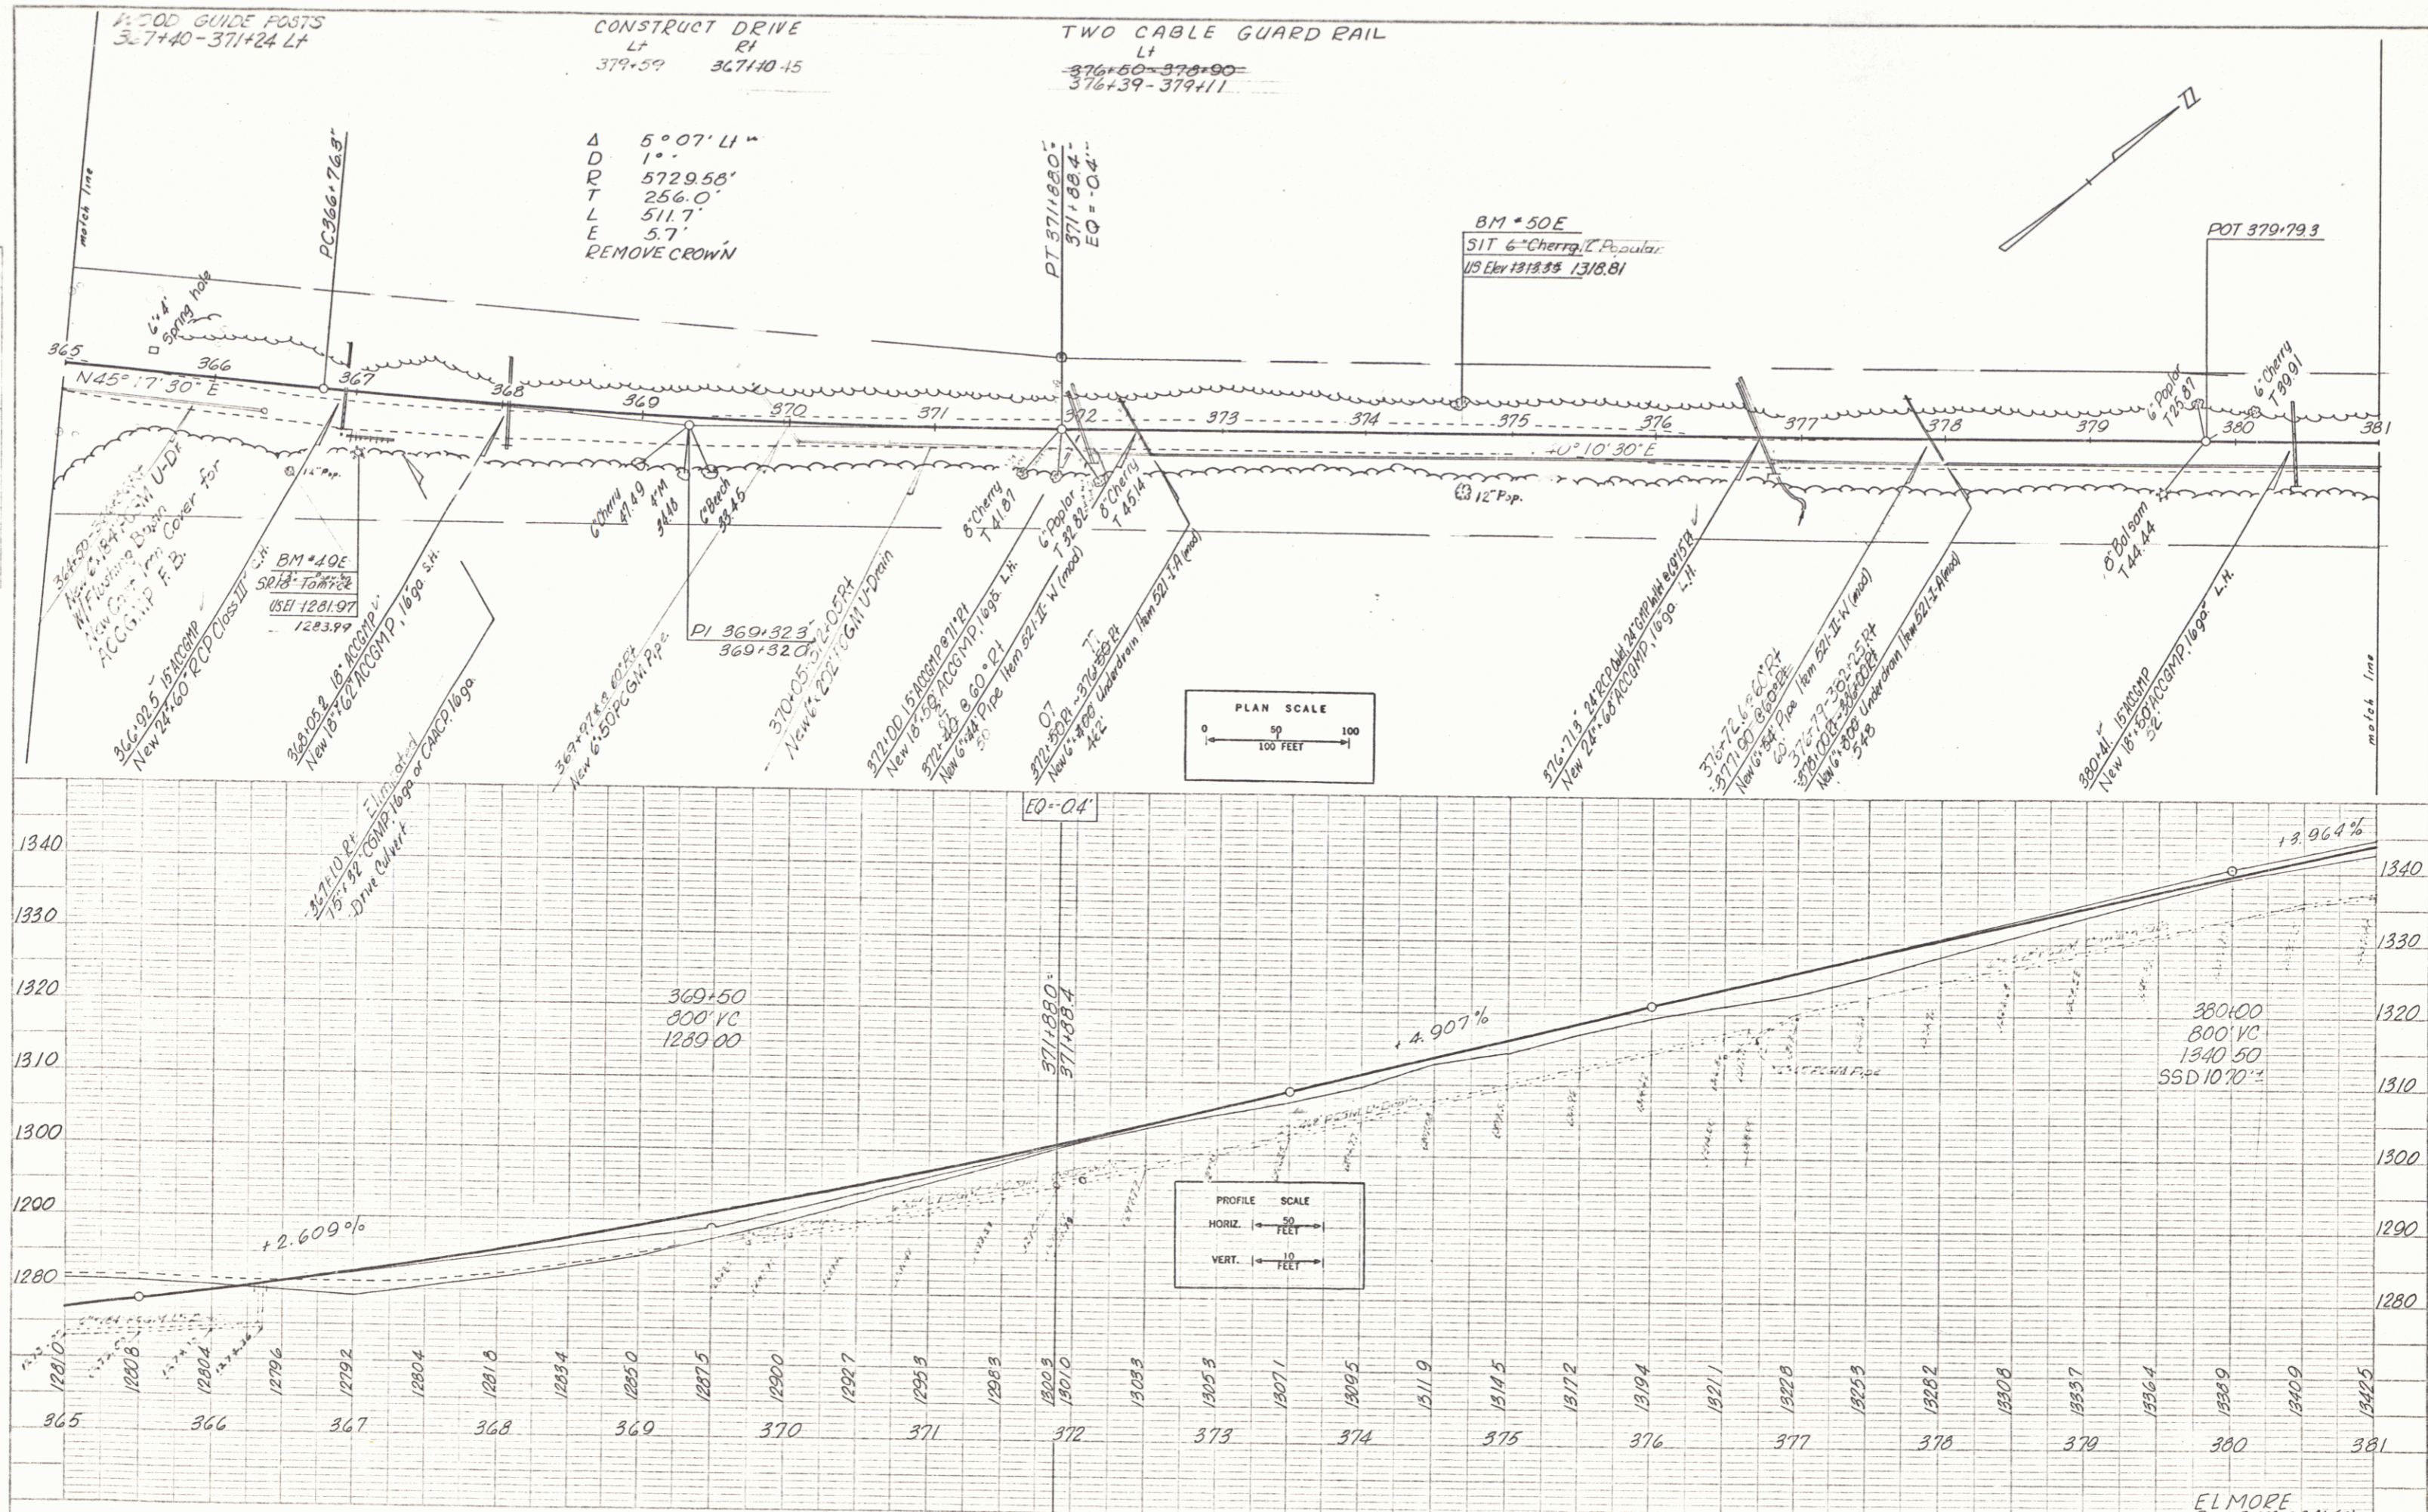

4  
 R  
 O  
 U  
 T  
 L  
 E  
 5° 07' LI =  
 1.0  
 5729.58'  
 256.0'  
 511.7'  
 5.7'  
 REMOVE CROWN

PLAN SCALE  
 0 50 100  
 FEET

PROFILE SCALE  
 VERT. 1" = 10 FEET

FL MOPE  
 Proj. 511-0241(4)  
 Sheet 43 of 97