




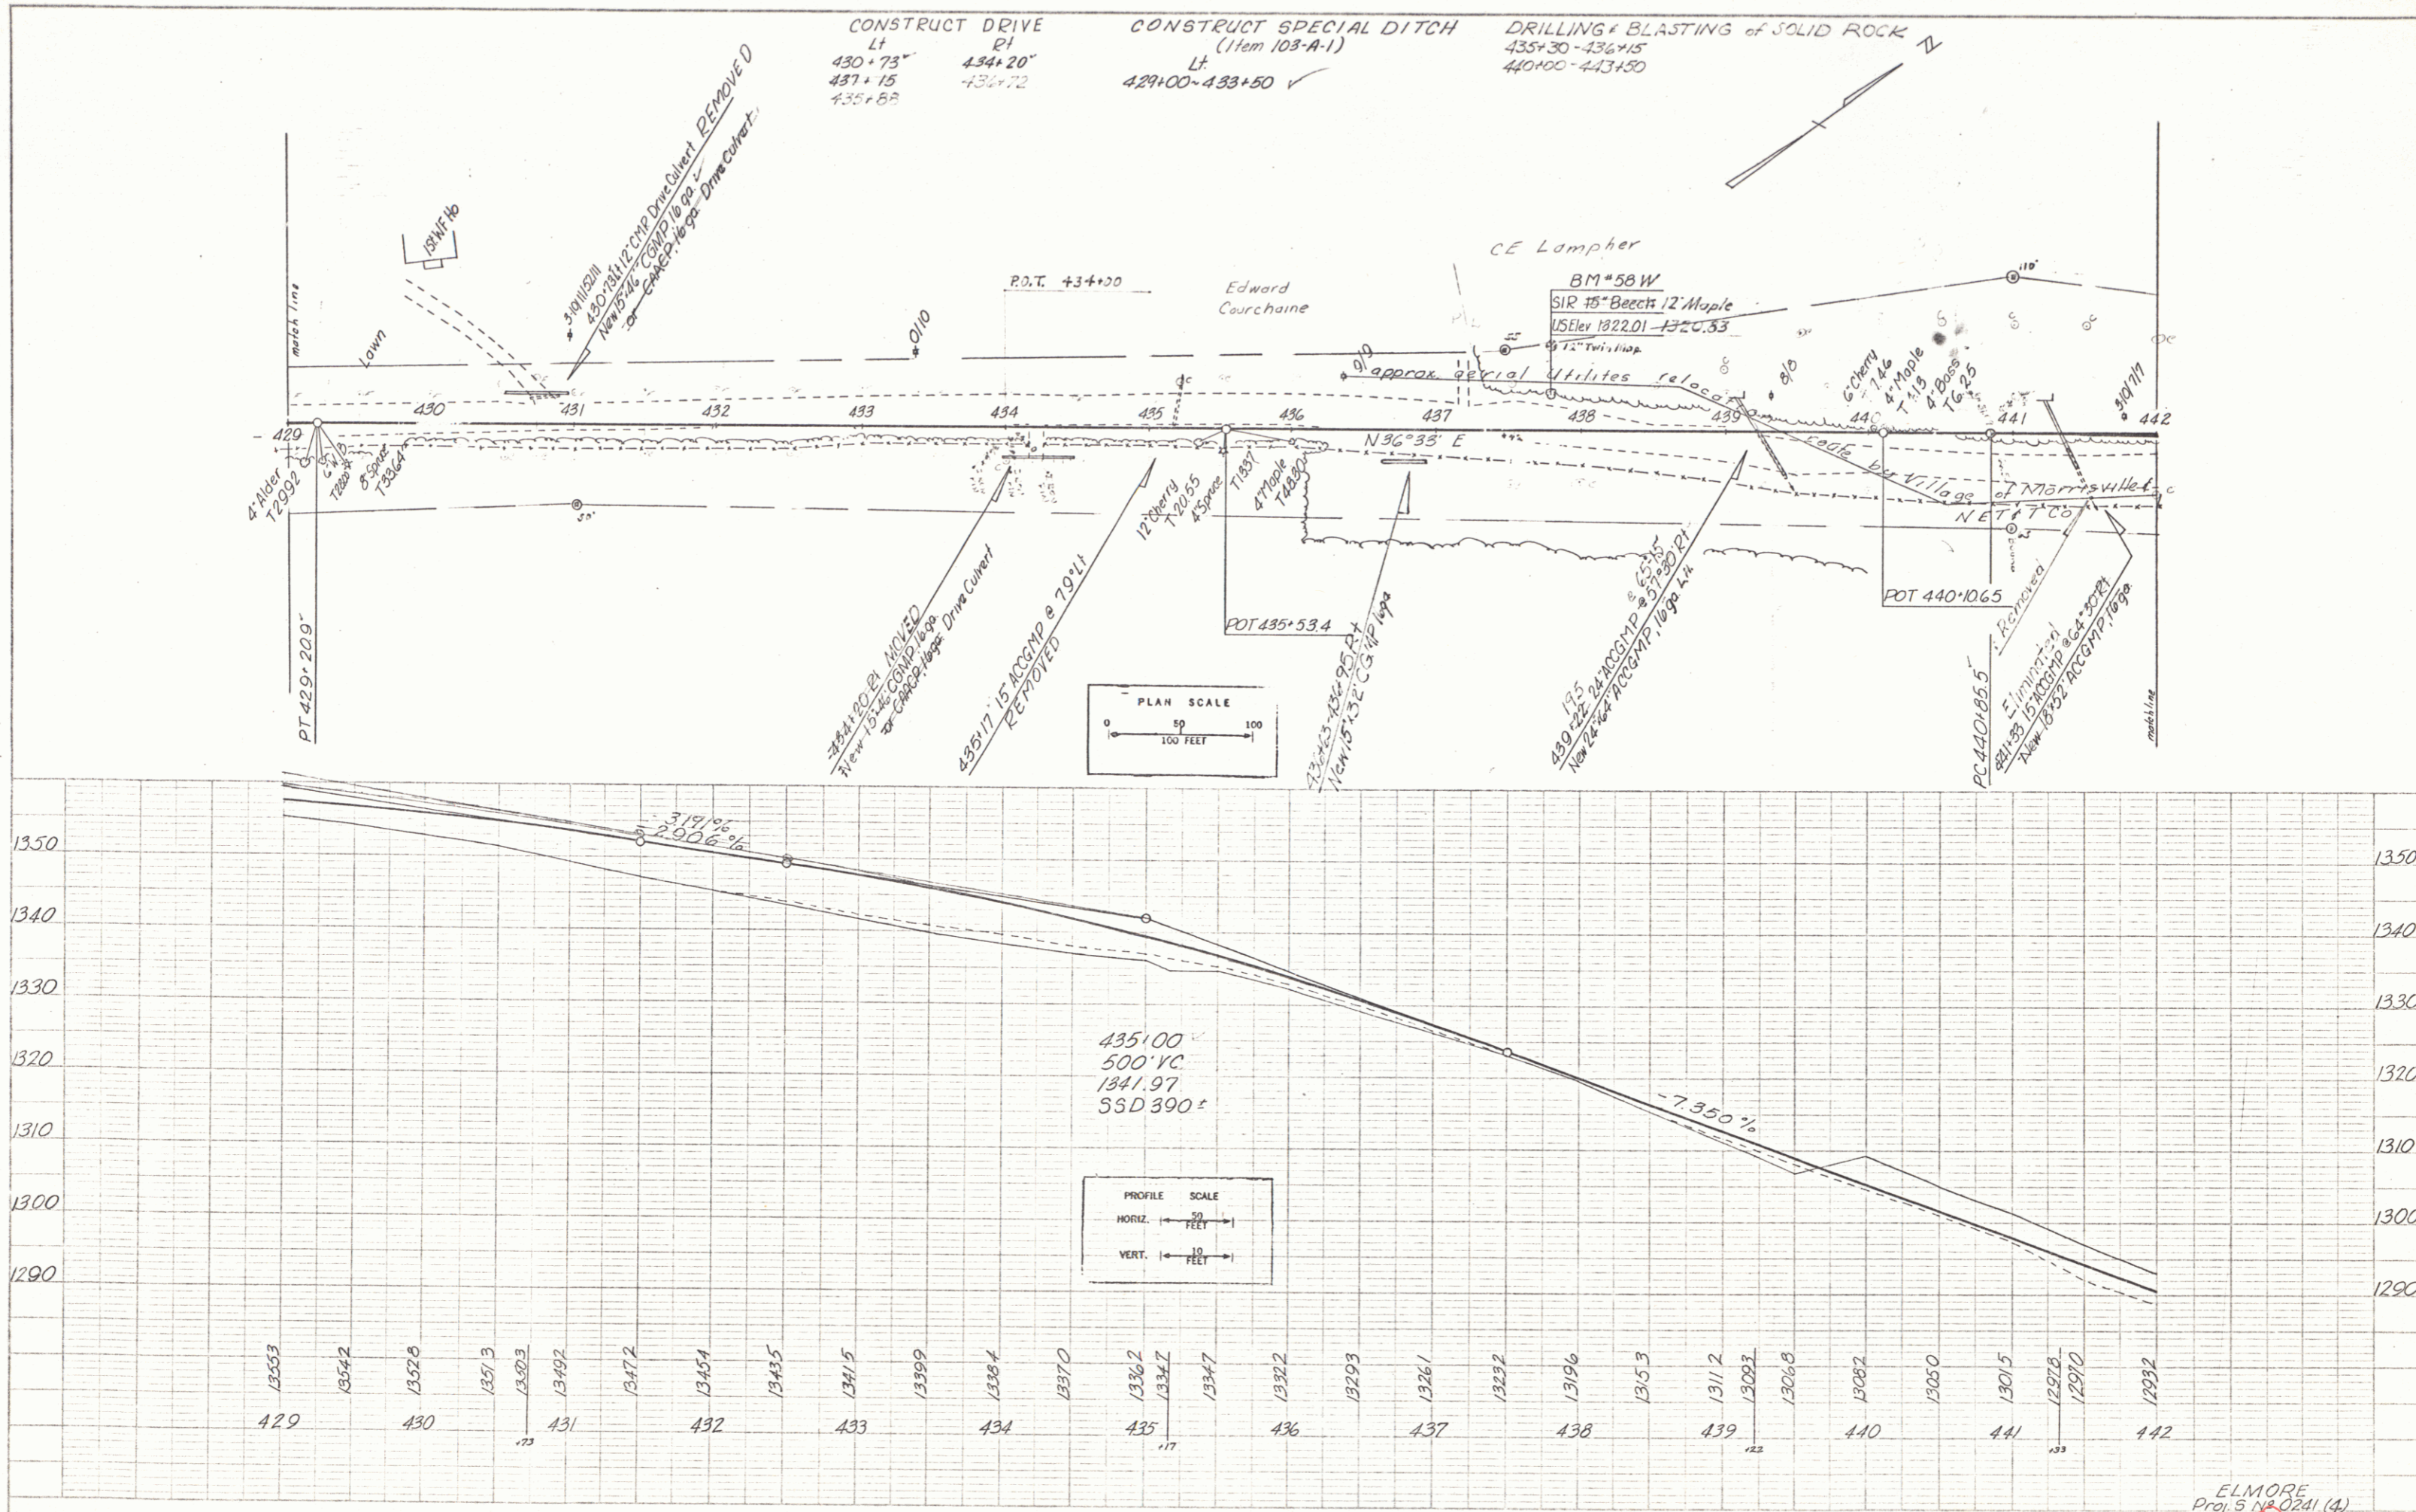

ELMORE
 Proj 5-11-0241 (4)
