TOPSOIL SEEDING
49+89 — 50+84 LT.
51+04 — 52+00 LT.
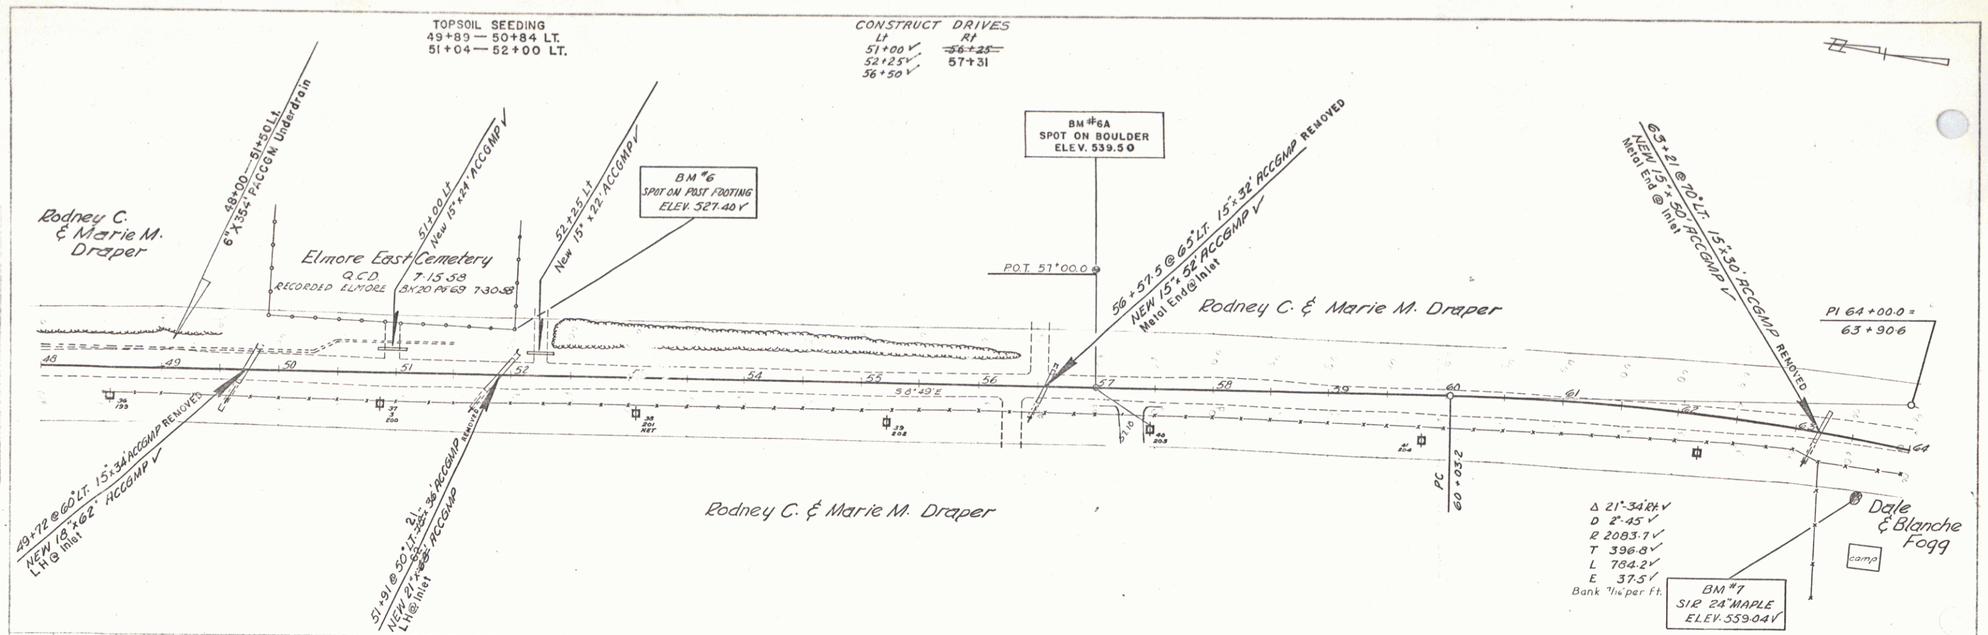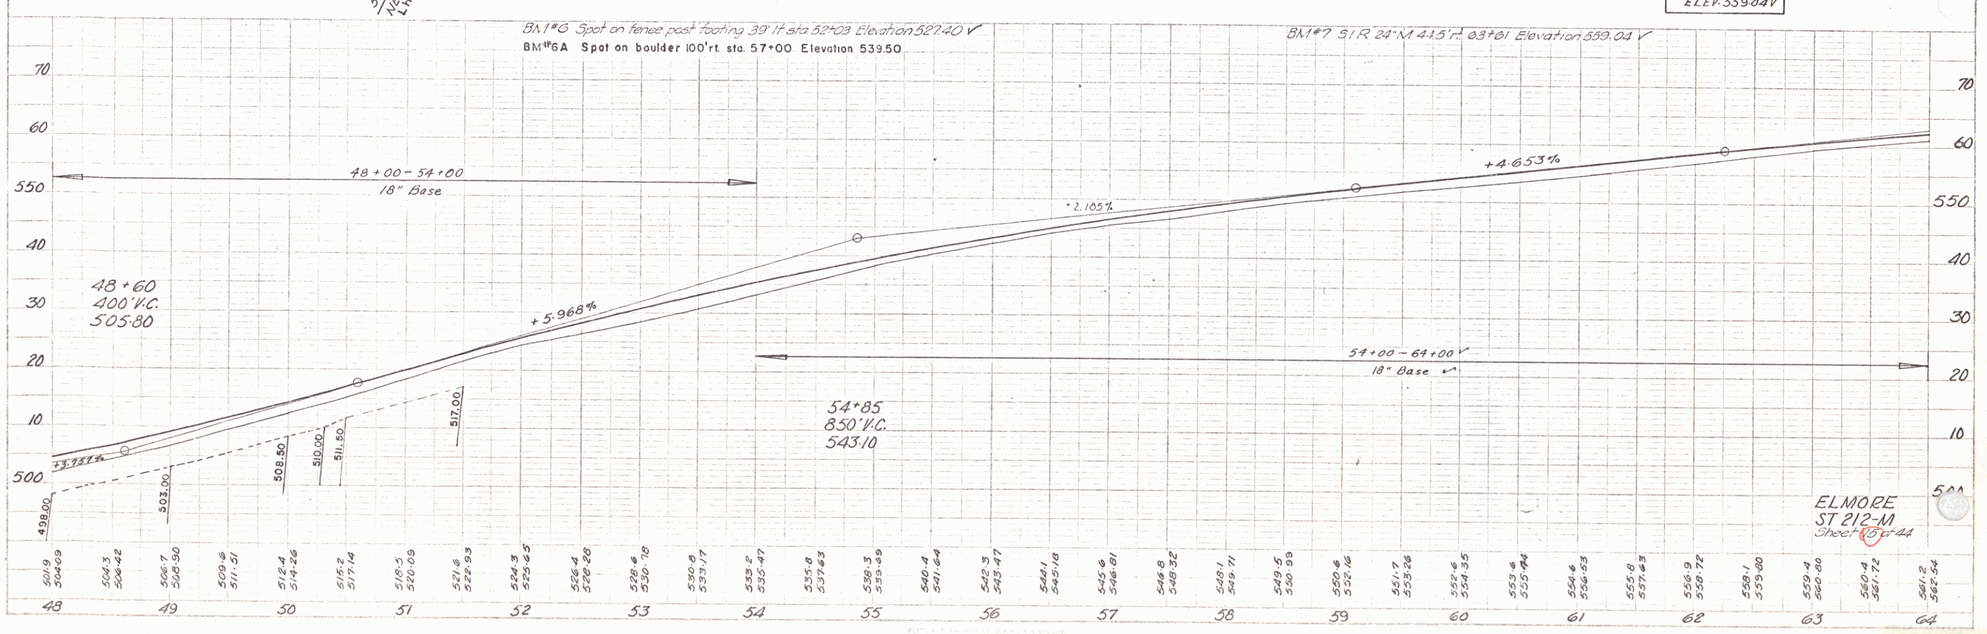
CONSTRUCT DRIVES
Lt: 51+00 ✓, 52+25 ✓, 56+50 ✓
Rt: ~~56+25~~, 57+31