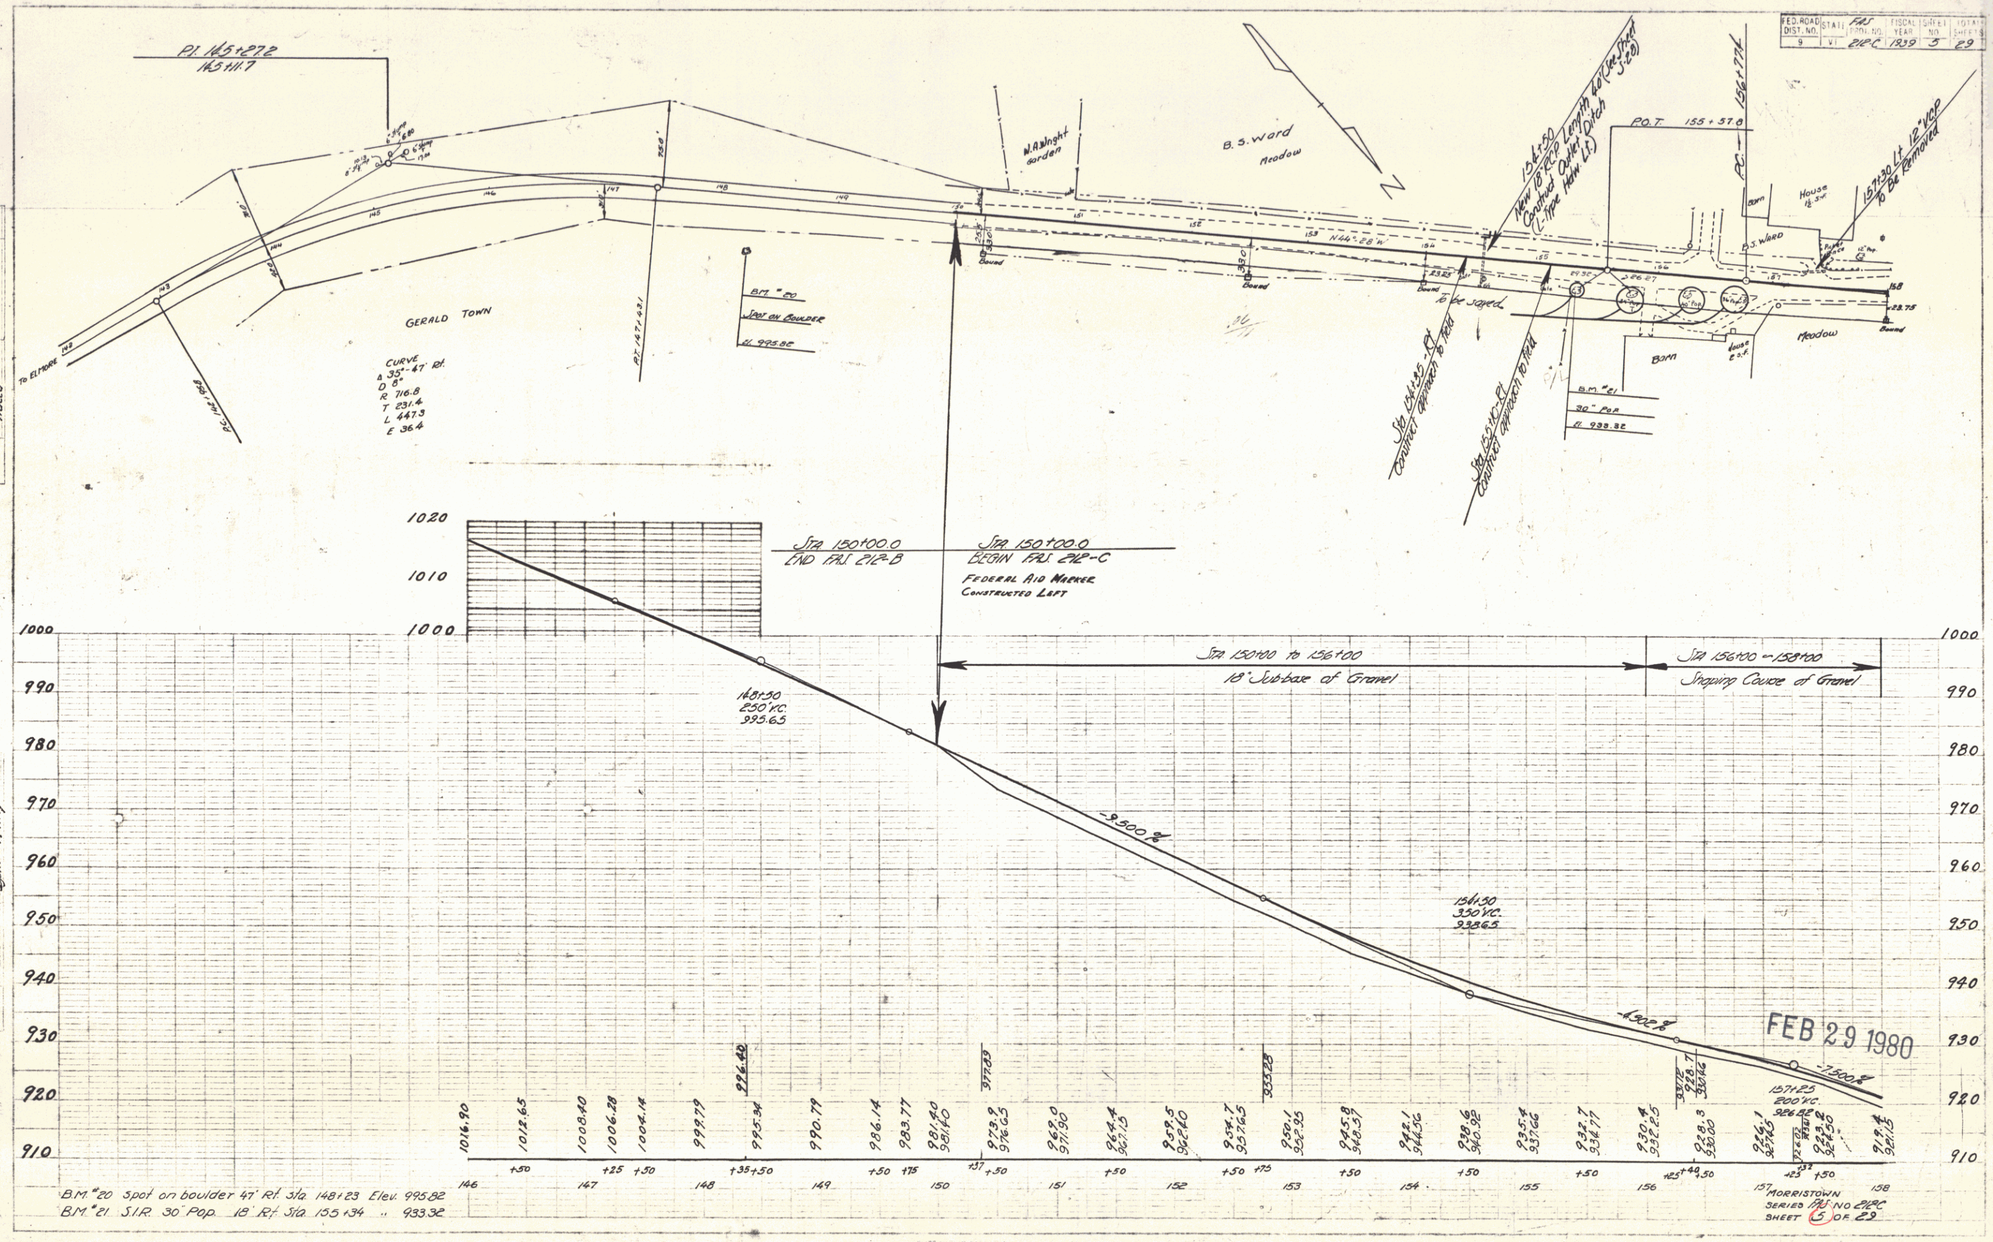FED. ROAD DIST. NO.	STATE	FAS PROJ. NO.	FISCAL YEAR	SHEET NO.	TOTAL SHEETS
9	VT	212C	1939	5	29