Parcel	Kind of Instrument	Date of Instrument	Grantor	Grantee	Recorded Rot. Book	Page	Date	Remarks
1-B-C-10-E	Q.C.D.	8-30-33	J.P. & Dora T. Ladd	St. of Vt	22	474	10-14-33	
1-B	Q.C.D.	8-30-33	Orza Boyce	"	24	65	10-14-33	

FAP 78G

Wood Guard Rail			
Sta.	Sta.	Rt.	Lt.
790+92	793+60	188	

FAP 78G

Wood Guide Posts		
Sta.	Rt.	Lt.
791+08		1
805+36	1	1
788+75	4	

Fed. Road Inst. No.	State	Fed. Aid Proj. No.	Sheet No.	Total Sheets
	Vt.	78G	19	22

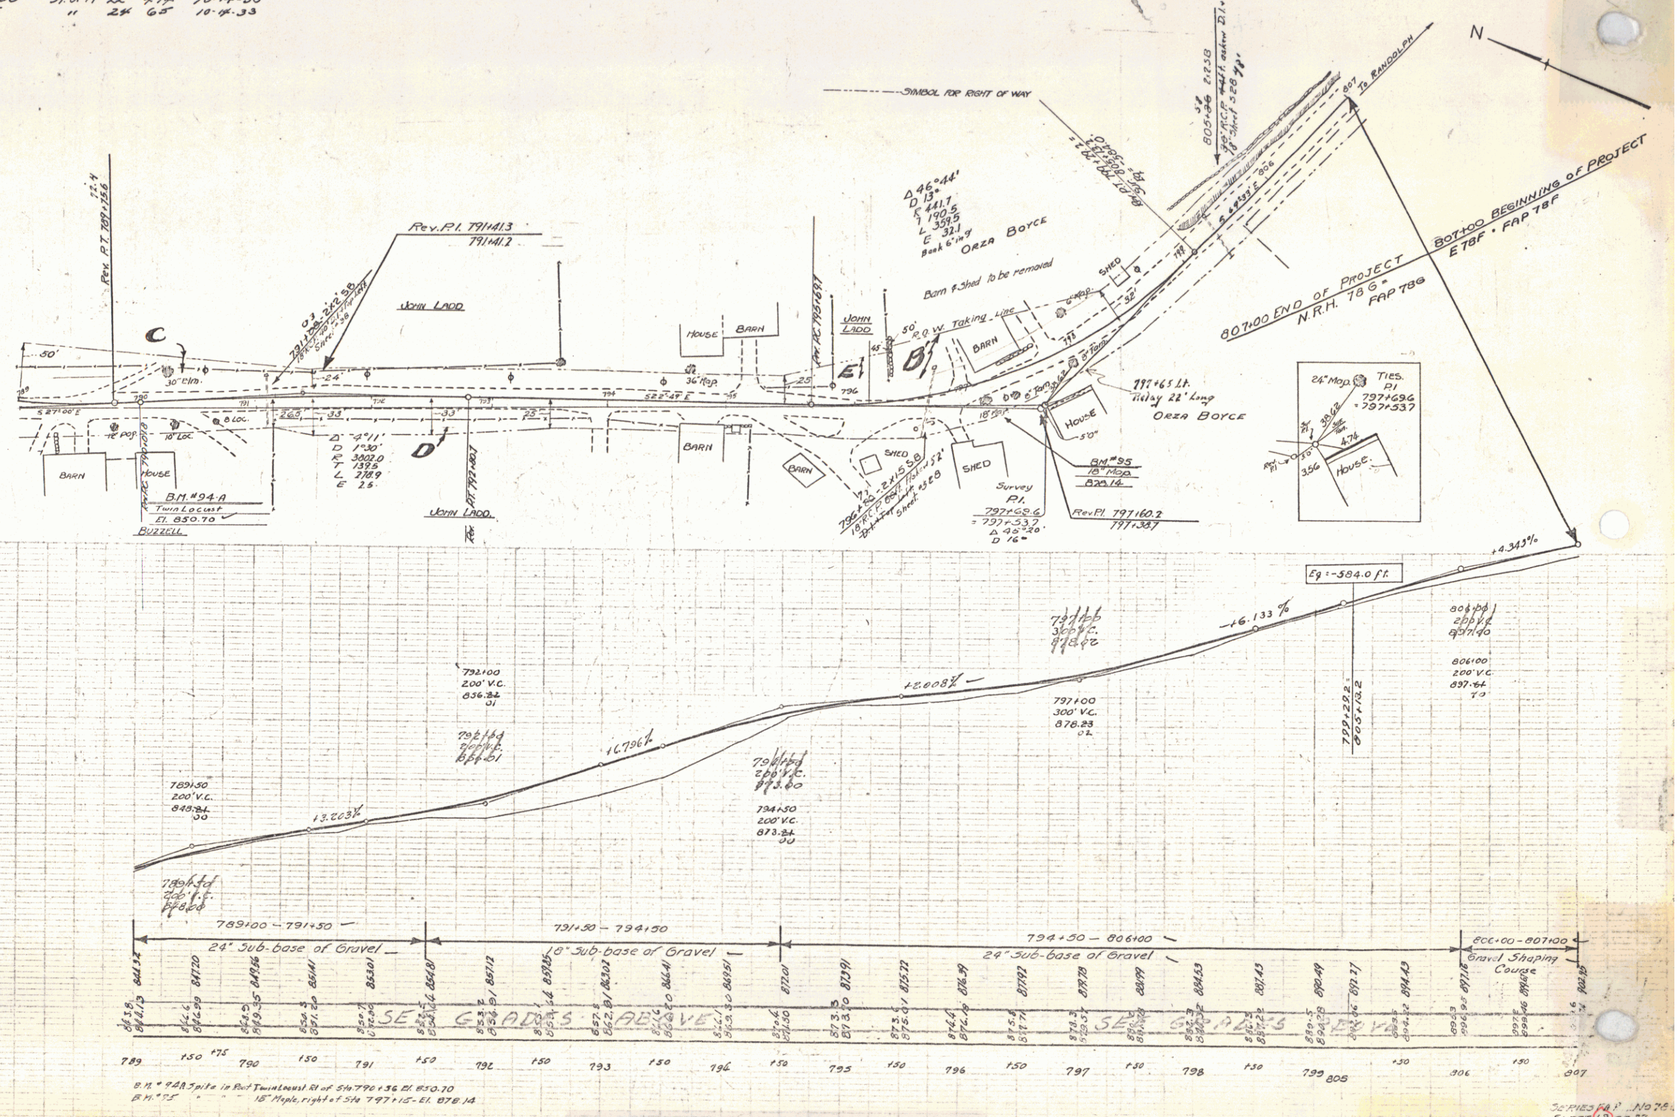

Series FAP No. 78
Sheet 19 of 22

18