



Amendment / Map Rev. 2 7/1/63

DATE	BY
7/1/63	W.A.L.
NO. OF SHEETS	3
NO. OF THIS SHEET	2
NO. OF ANY OTHER SHEETS	
NO. OF THIS SHEET	3

DATE	BY
NO. OF SHEETS	3
NO. OF THIS SHEET	2
NO. OF ANY OTHER SHEETS	
NO. OF THIS SHEET	3

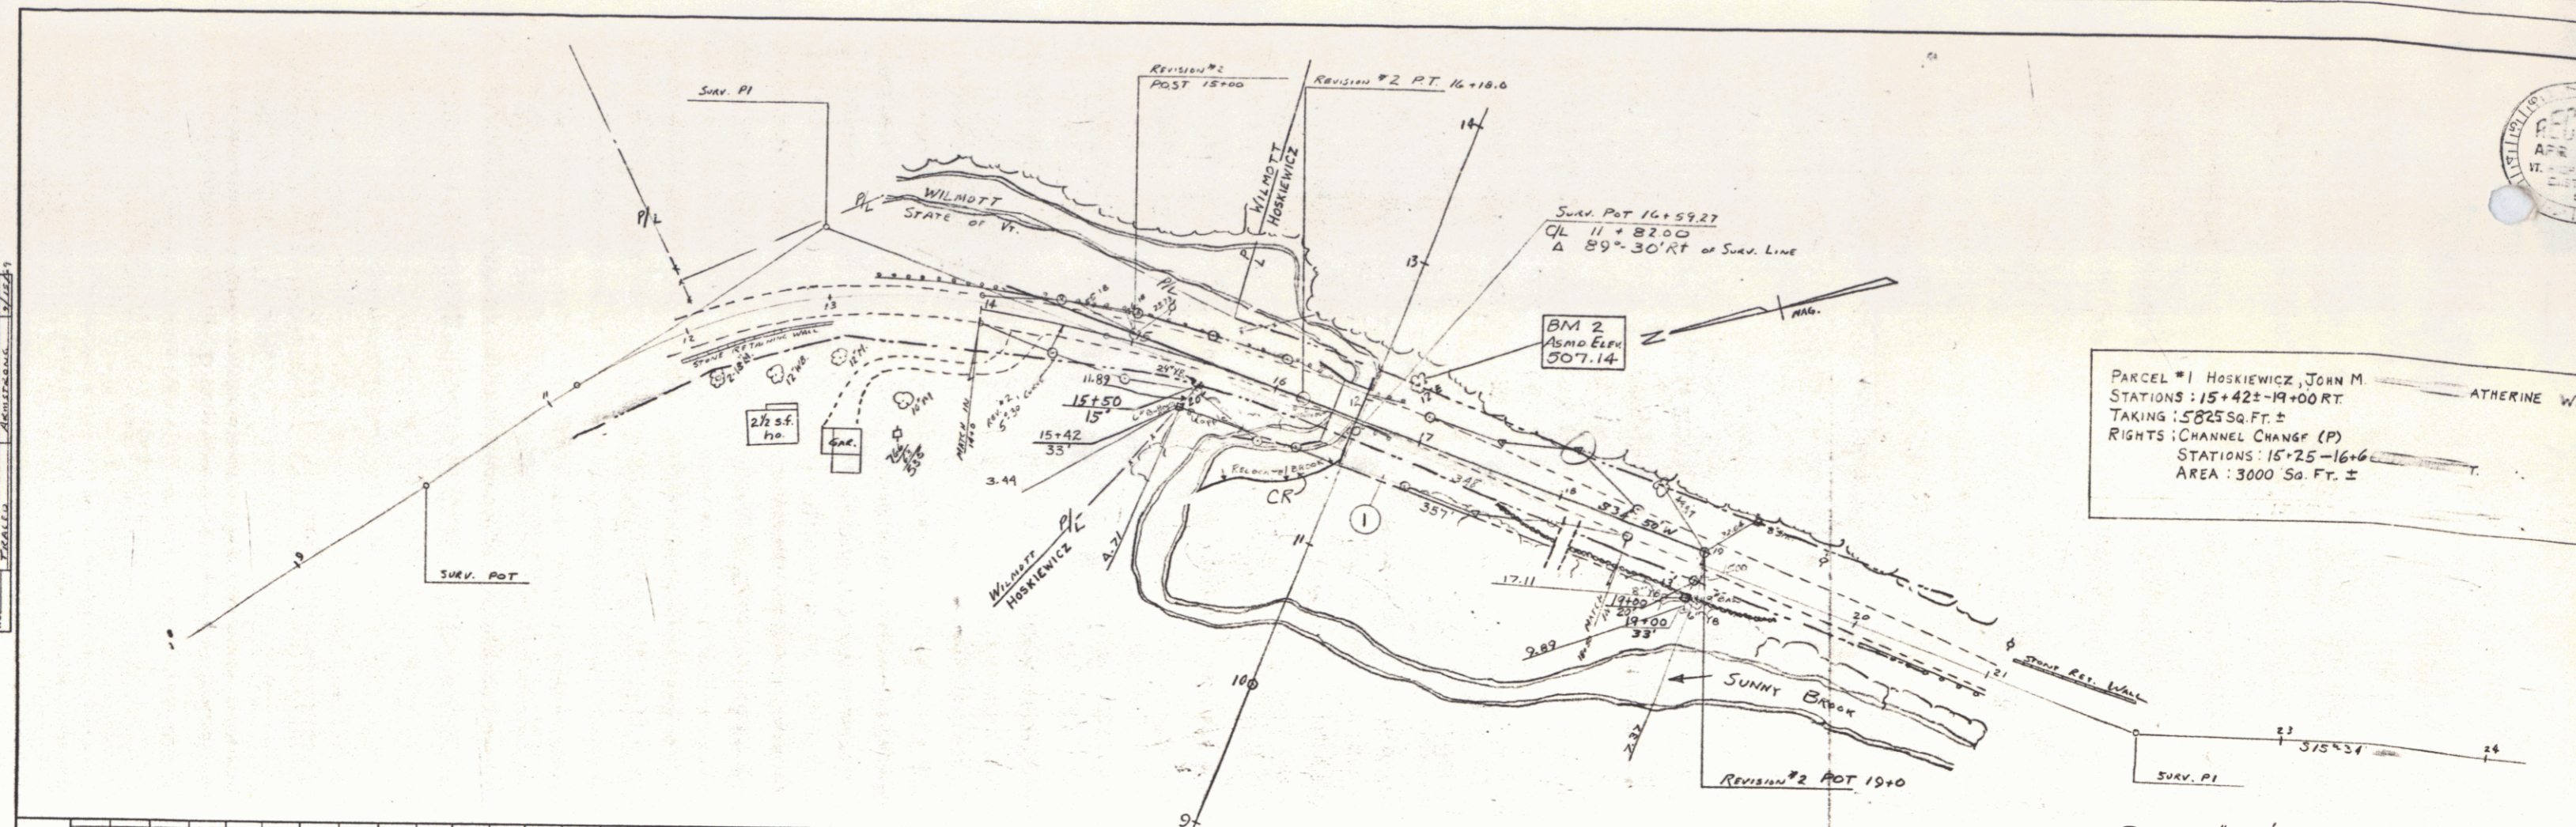

PARCEL #1 HOSKIEWICZ, JOHN M
 STATIONS: 15+42±-19+00 RT
 TAKING: 5825 SQ. FT. ±
 RIGHTS: CHANNEL CHANGE (P)
 STATIONS: 15+25-16+6
 AREA: 3000 SQ. FT. ±

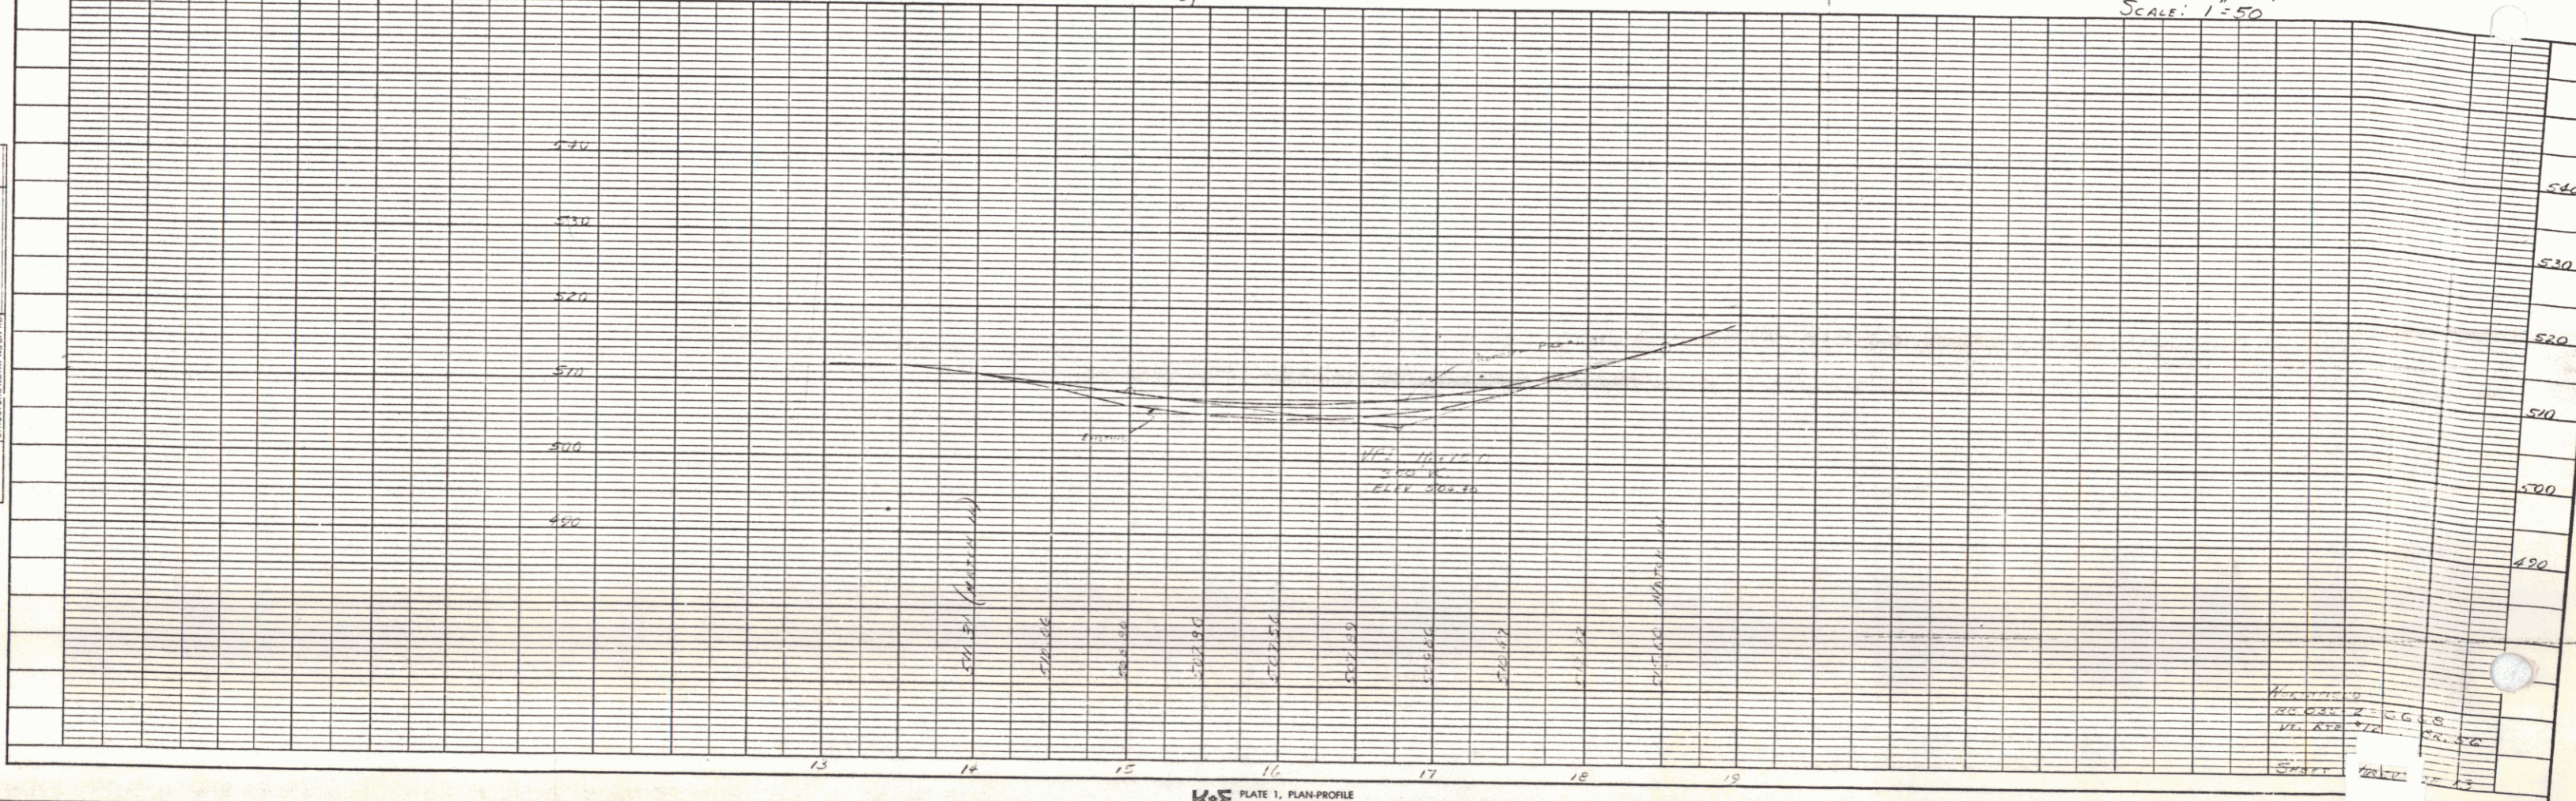

K&E PLATE 1, PLAN-PROFILE

SHEET 2

3