


Present Bridge Data
Concrete Bridge
 Cl Span 13.3'
 Bek Footings 11.2'
 Cl Height 7.7'
 Road way 20.2'
 Dead Load 2.3' (Cover)
 Stone Abut. Conc. faced
 Conc. Rails
 Footings setting on ledge

NOTE
 radius of at least 15'

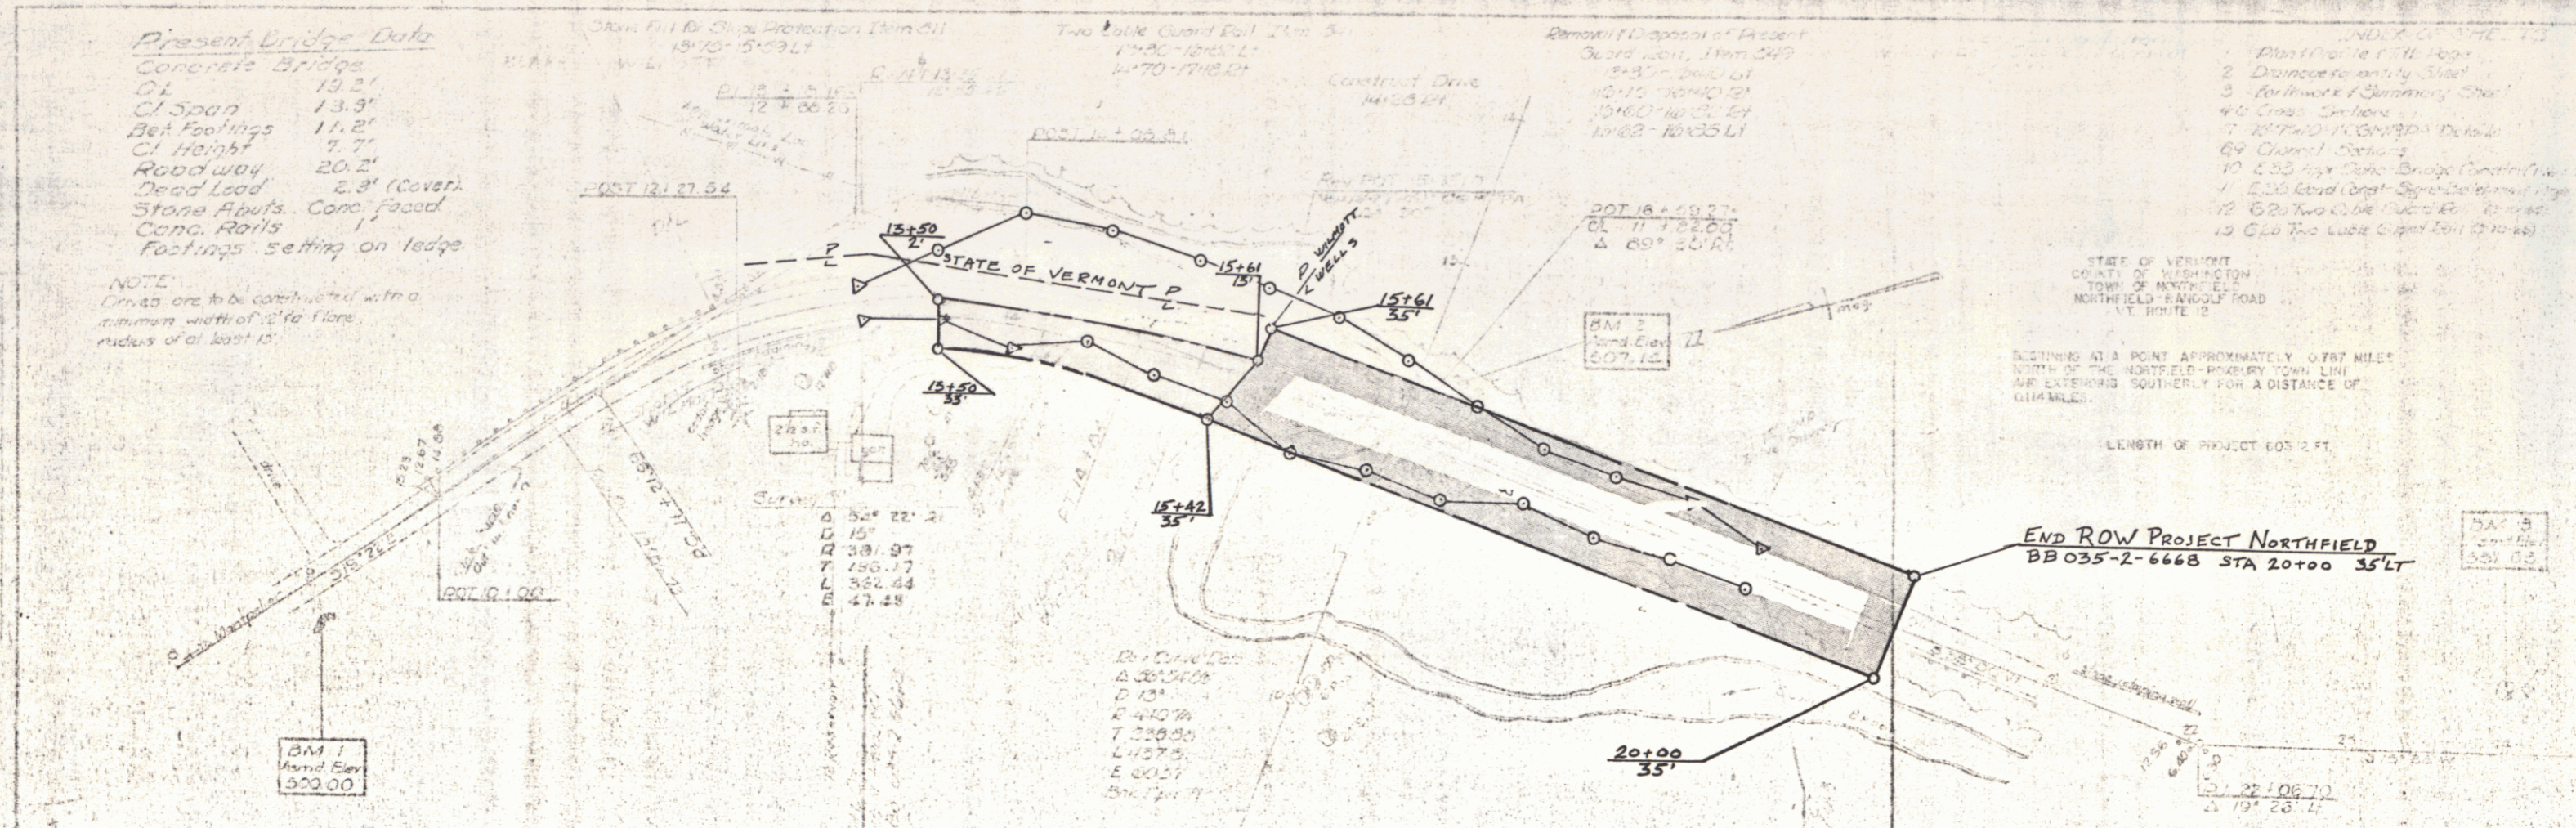

- INDEX OF SHEETS
STATE OF VERMONT
 COUNTY OF WASHINGTON
 TOWN OF NORTHFIELD


LENGTH OF PROJECT 603.2 FT

END ROW PROJECT NORTHFIELD
 BB 035-2-6668 STA 20+00 35' LT

POOR ORIGINAL COPY

SUPERCEDED

2A 2

4