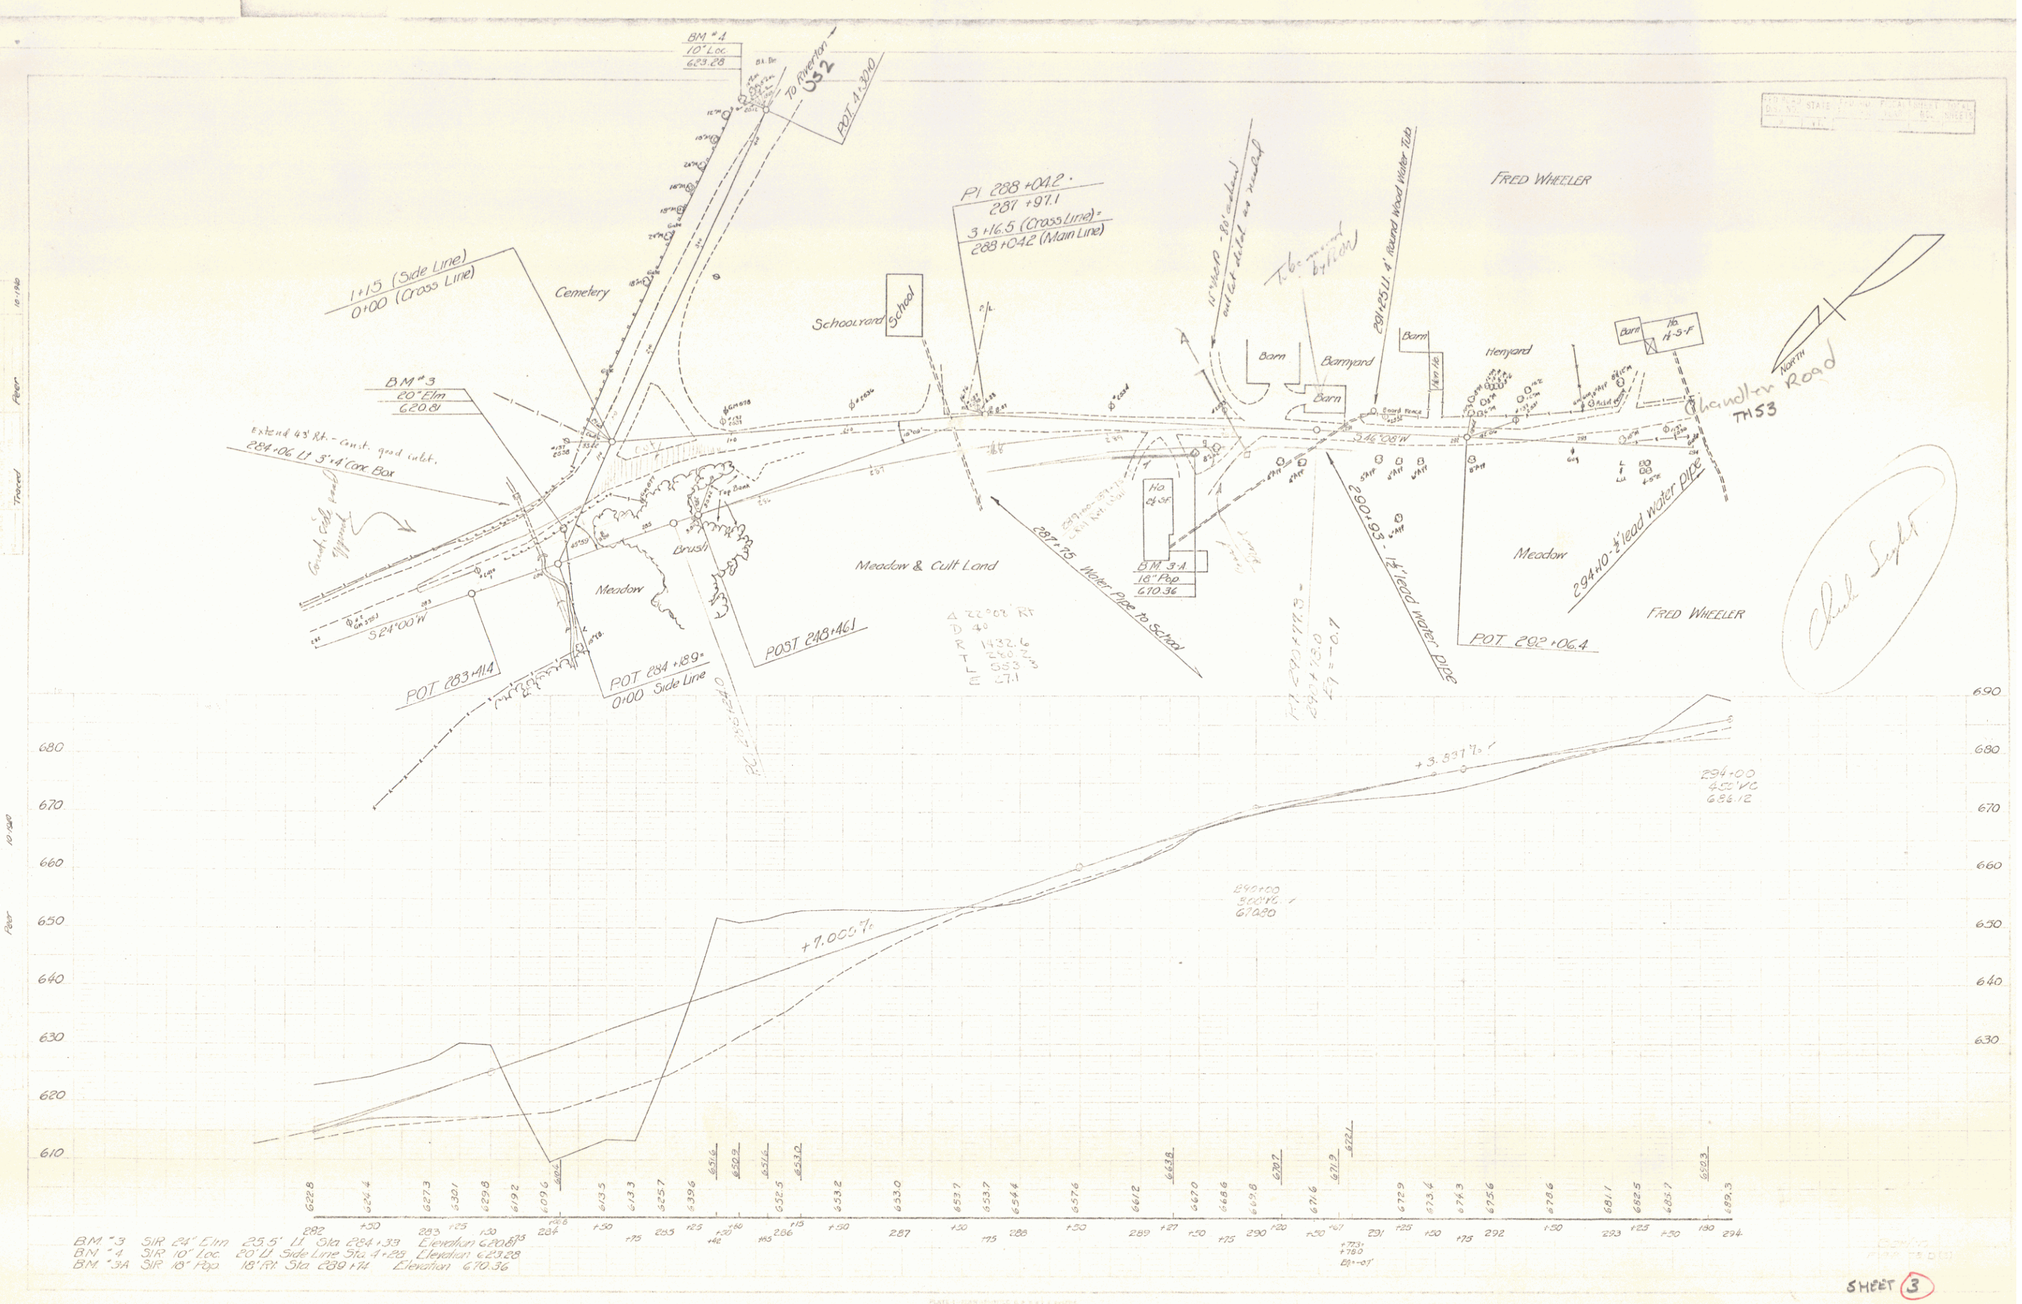
BM #4
10" Loc.
623.28
To Riverton
U32
POT 4+20.0
PI 288+04.2
287+97.1
3+16.5 (Cross Line)
288+04.2 (Main Line)
1+15 (Side Line)
0+00 (Cross Line)
Cemetery
Schoolyard
School
BM #3
20" Elm
620.81
Extend 43' Rt. - Cust. good cult.
284+06 Lt 5'+ Cox Box
Brush
Meadow
Meadow & Cult Land
POT 283+41.4
POT 284+18.9
0+00 Side Line
POST 248+46.1
287+75 Water Pipe To School
BM 3A
18" Pop
670.36
Barn
Barnyard
Henyard
Board Fence
Wire Fence
Fred Wheeler
Meadow
290+93 - 1½" lead water pipe
294+10 - ½" lead water pipe
POT 292+06.4
Chandler Road
T453
North
Chuck Sight
+7.000%
+3.537%
294+00
400' VC
686.12
290+00
500' VC
670.90
BM #3 SIR 24" Elm 23.5' Lt Sta 284+33 Elevation 620.81
BM #4 SIR 10" Loc 20' Lt Side Line Sta 4+23 Elevation 623.28
BM #3A SIR 18" Pop 18' Rt Sta 289+14 Elevation 670.36
SHEET 3

3