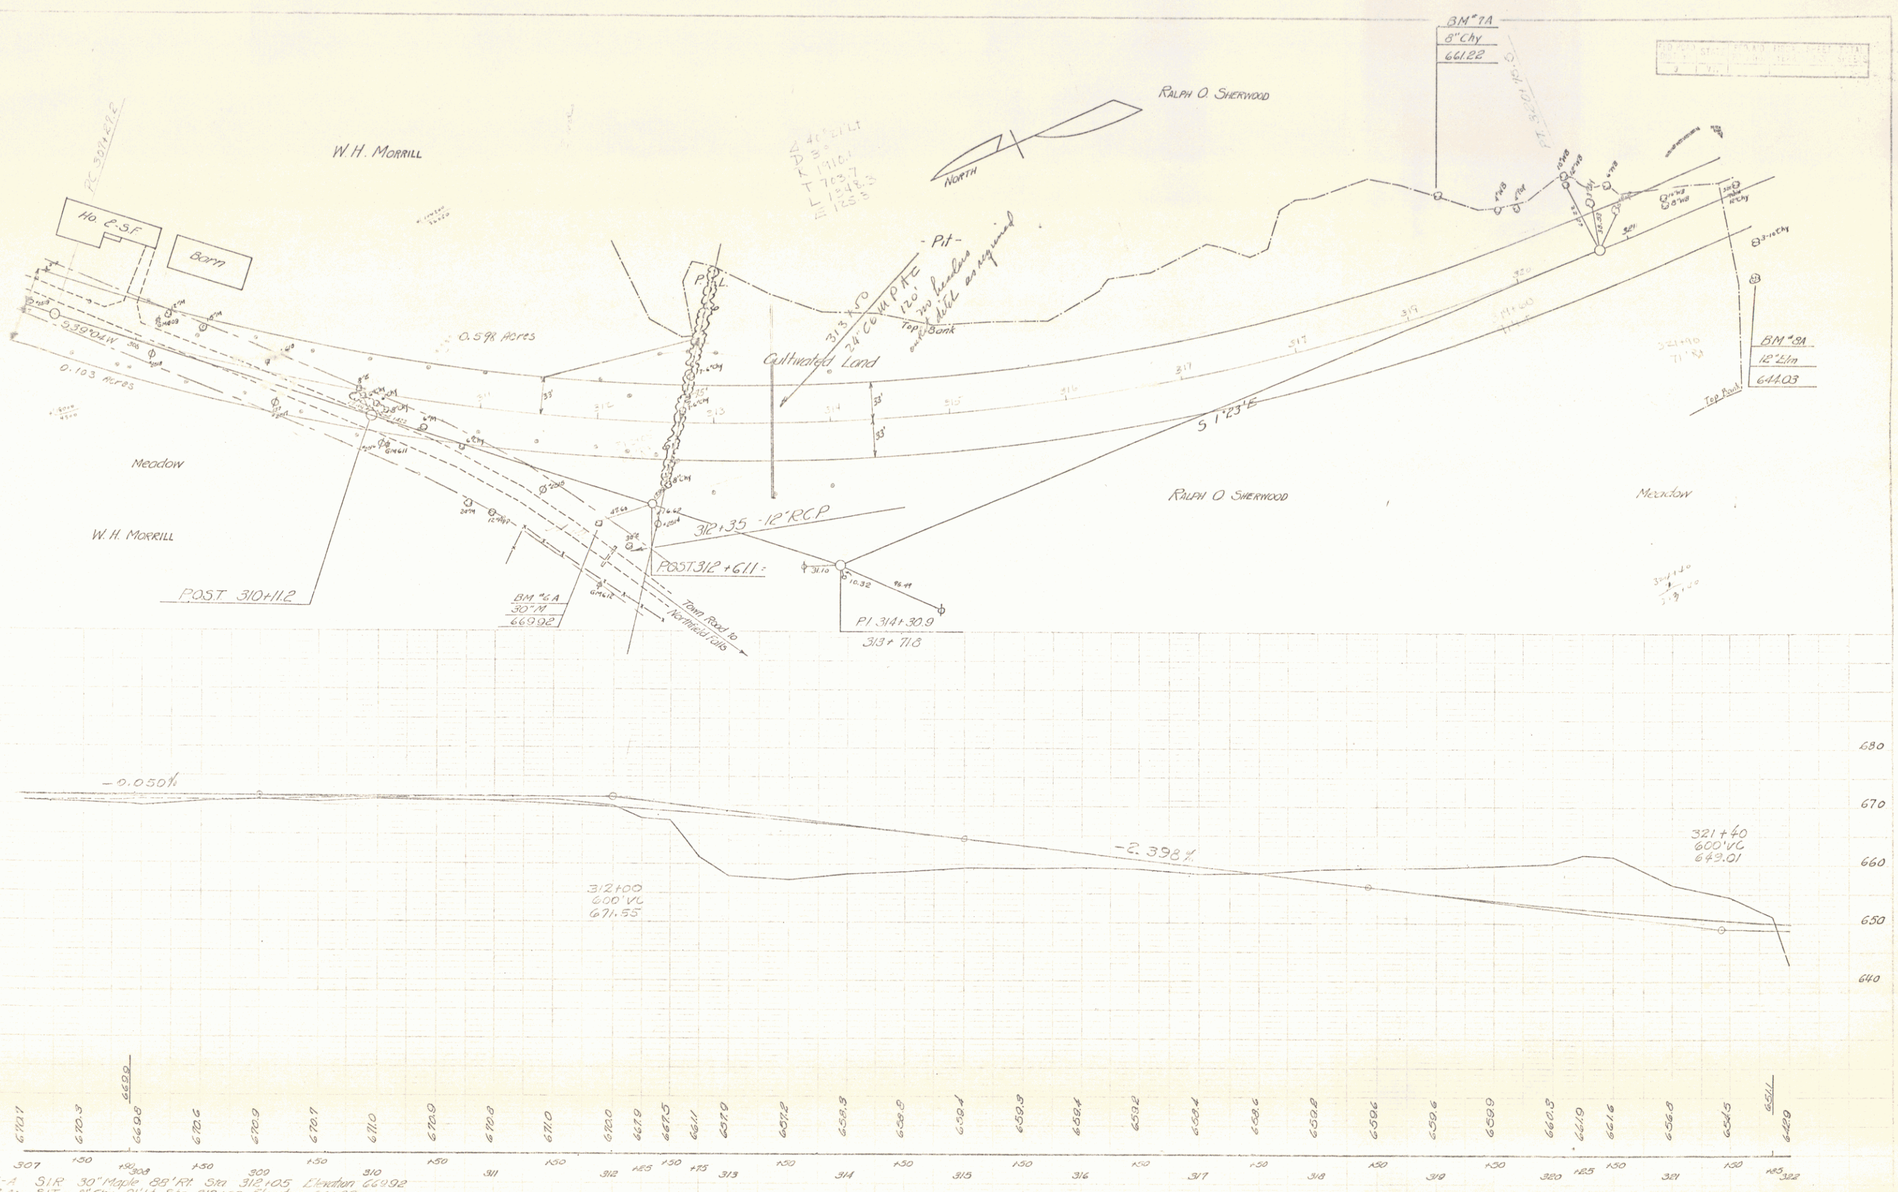

SHEET 5

FORM FASH 78 (3)

5