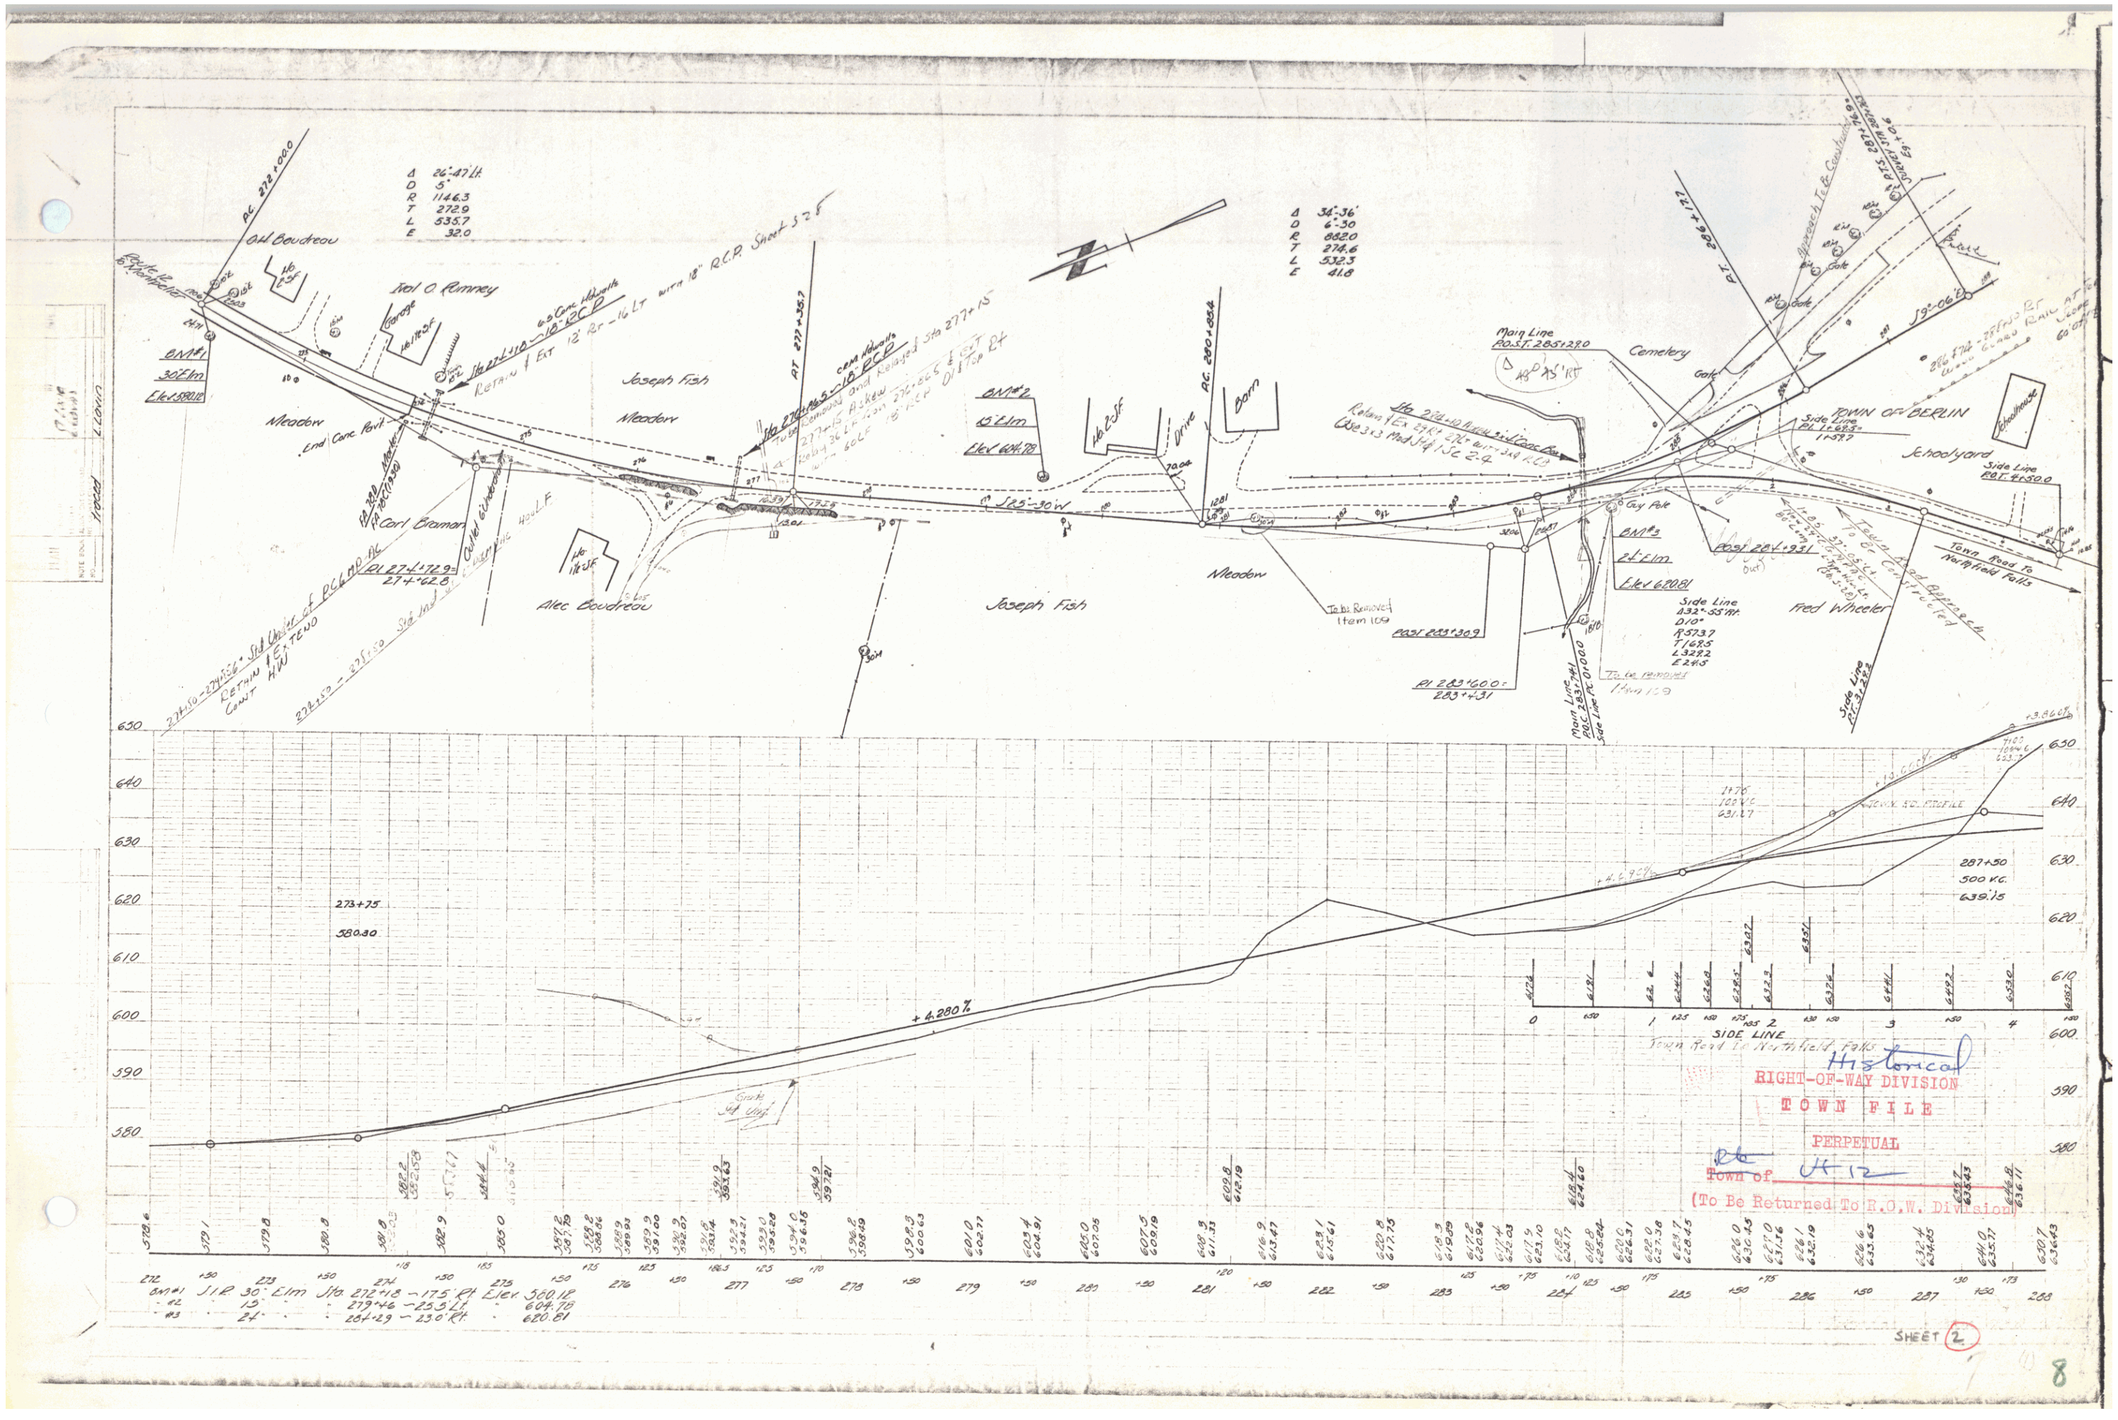
Old Boudreau
Hal O. Romney
Joseph Fish
Meadow
Carl Braman
Alec Boudreau
Barn
Drive
Cemetery
TOWN OF BERLIN
Schoolyard
Fred Wheeler
Town Road To Northfield Falls
Main Line
Side Line
Gate
Guy Pole
Approach To Culvert
Town Road Approach Culvert Constructed
Retain 1 Ex 12' Rt - 16' Lt with 18" R.C.P. Sheet 3 of 8
Remove Ex 12' Rt 27' Lt 34' R.C.P.
