88-104

FED. ROAD DIST. NO.	STATE	F.A.S. AID PROJ. NO.	FISCAL YEAR	SHEET NO.	TOTAL SHEETS
9	VT.	78-C	1930	10	66

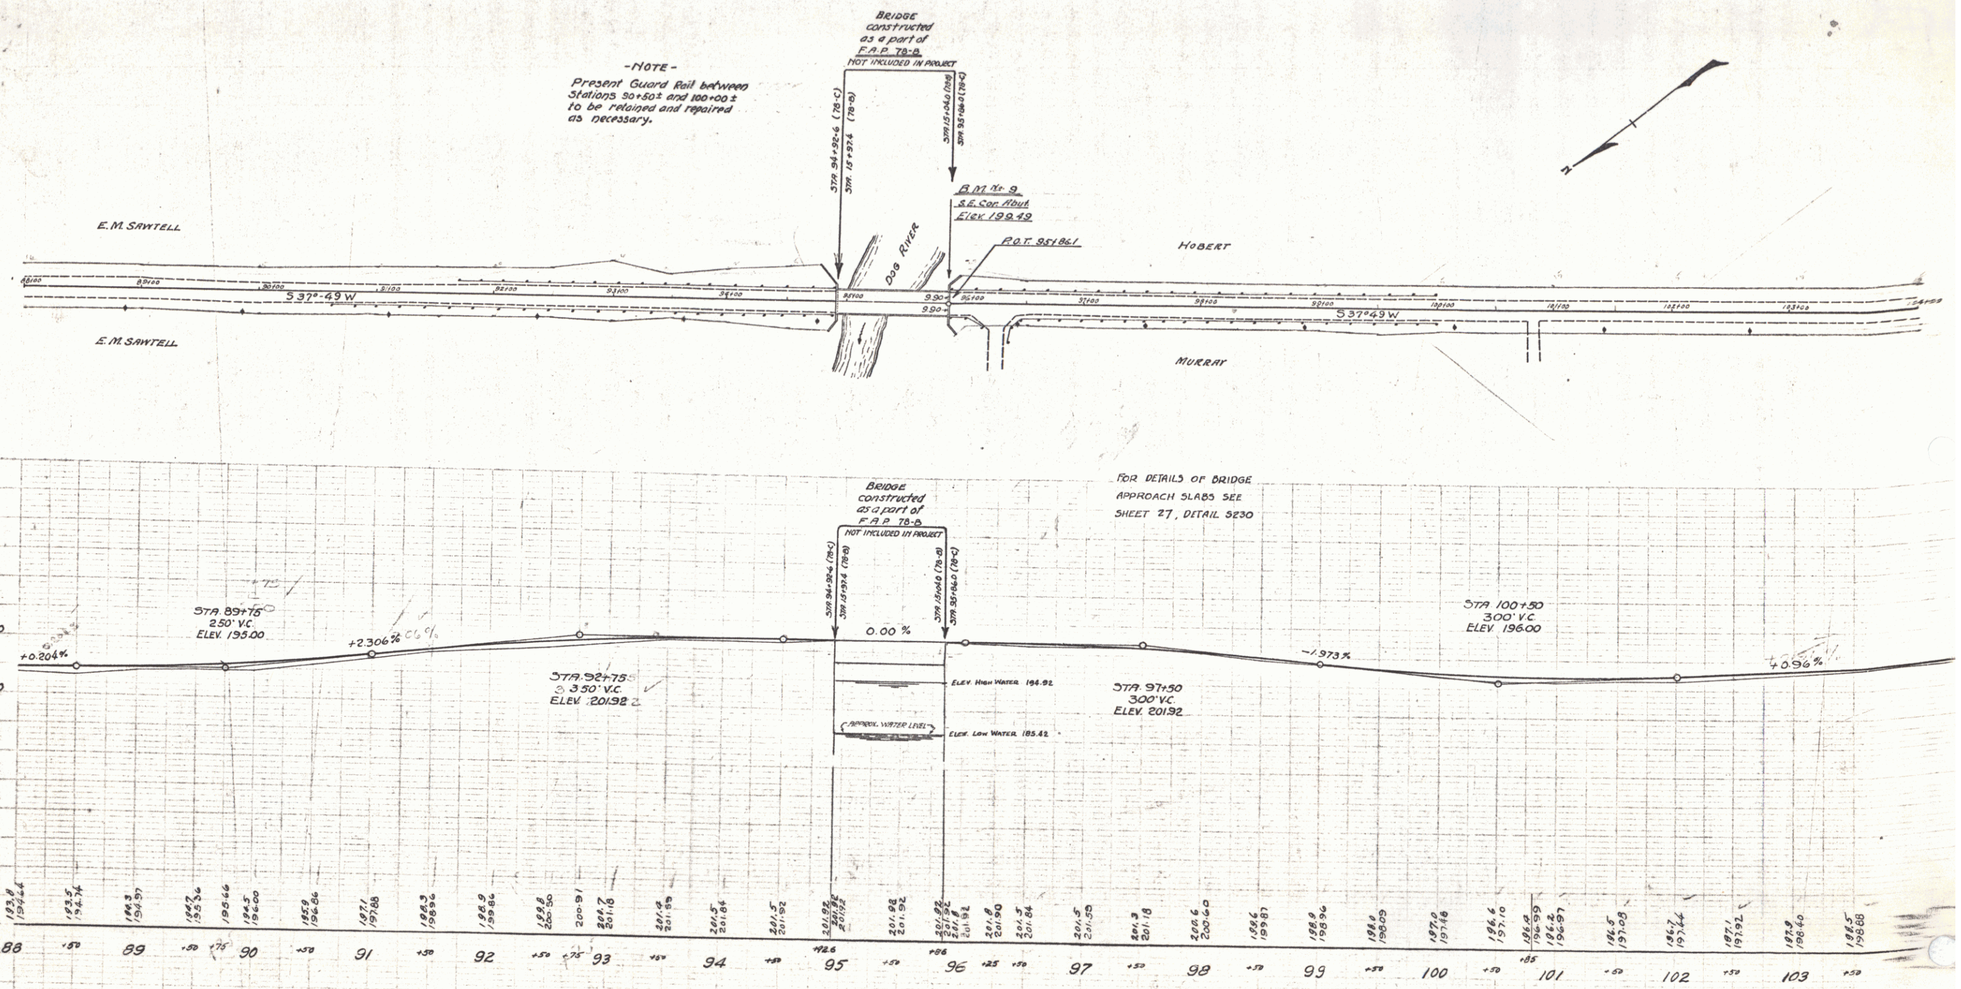

SERIES F
SHEET 10

8