FED. ROAD DIST. NO.	STATE	N.R.H.	FISCAL YEAR	SHEET NO.
3	Vt.	79-C (1935)	1935	6

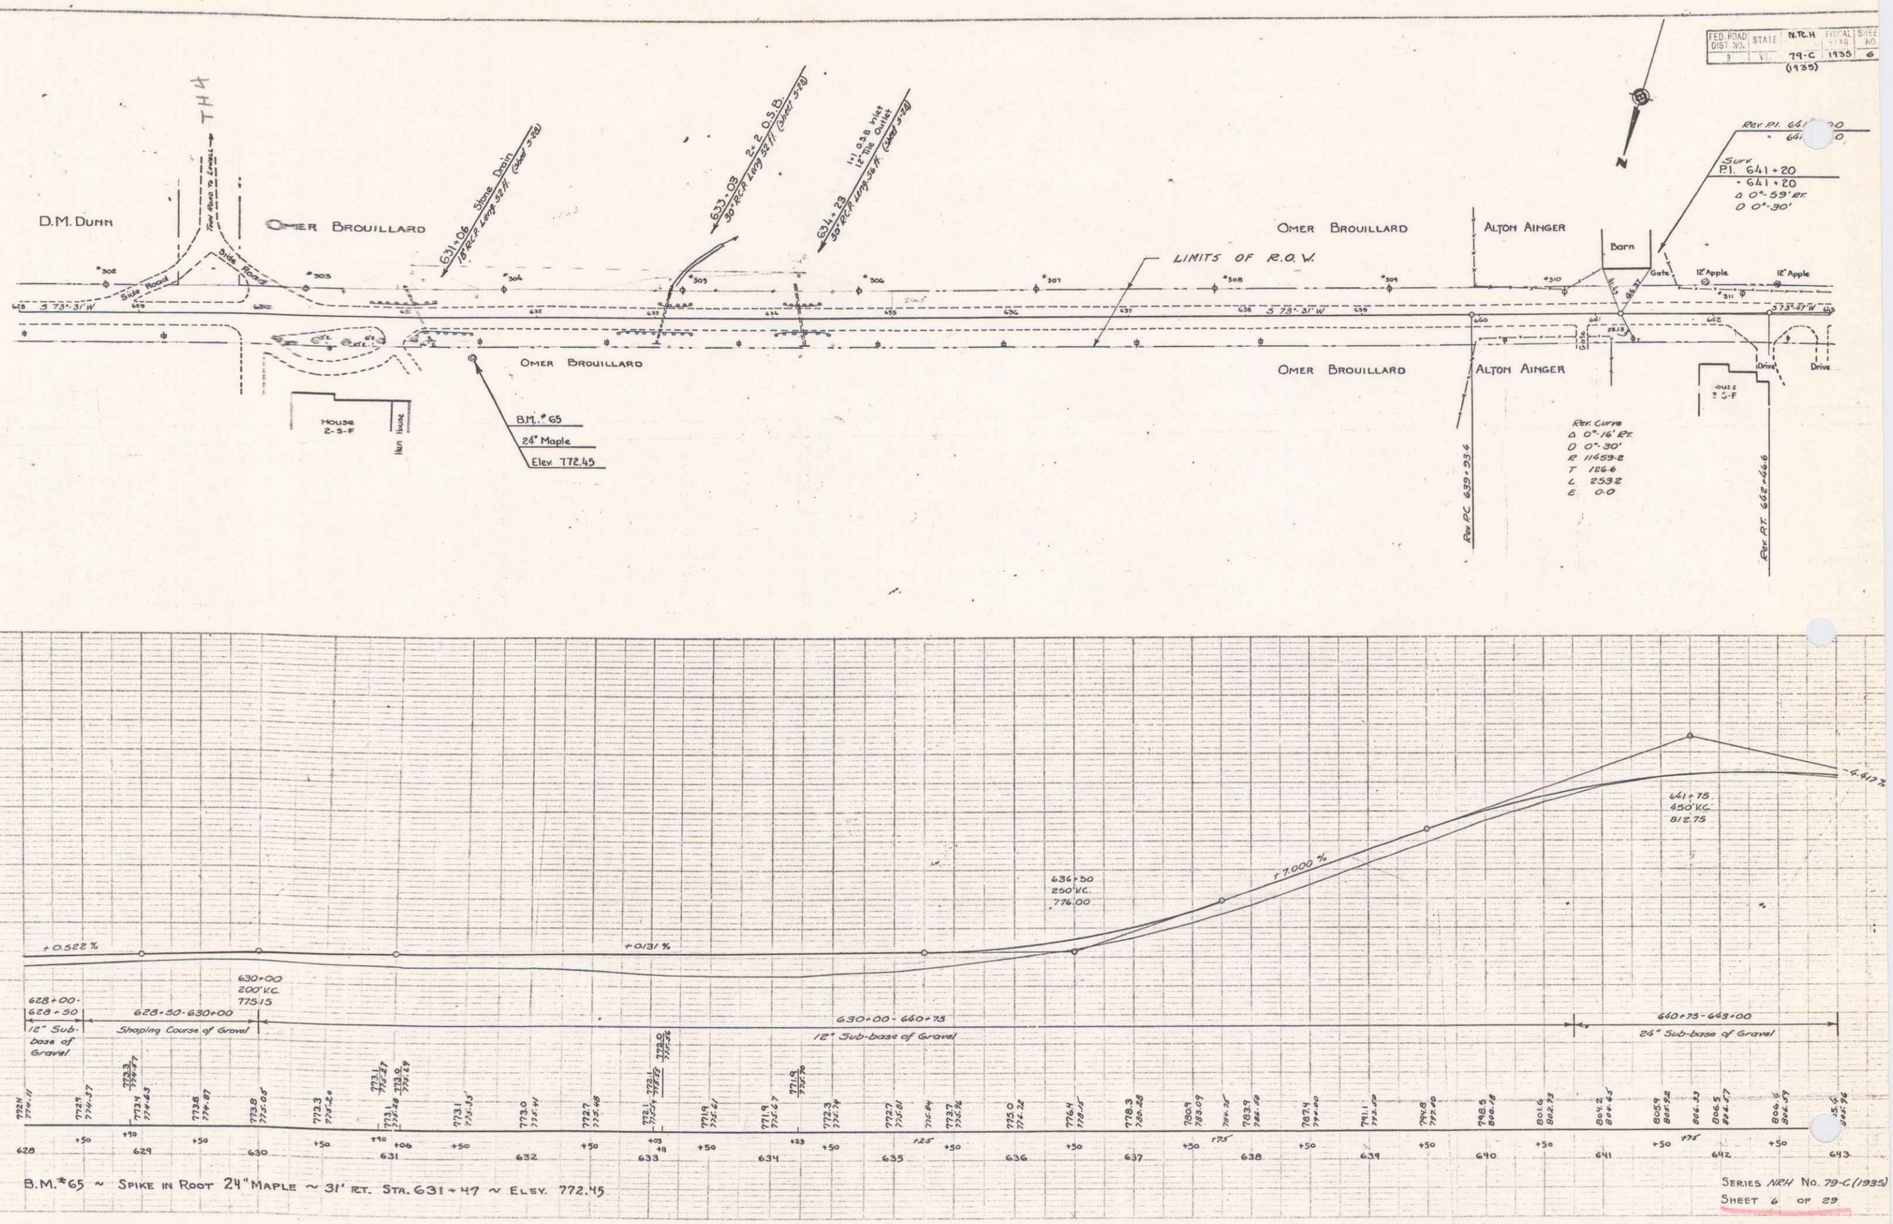

4