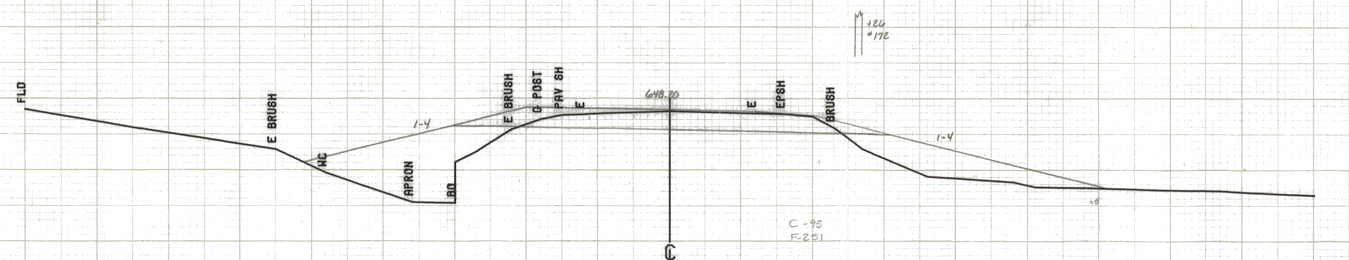

640

99+50
End Approach
Begin Project

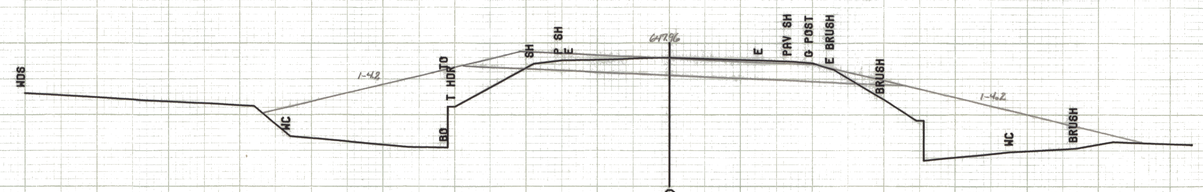

640

99+40 70° Lt
4'x4' Conc. Box

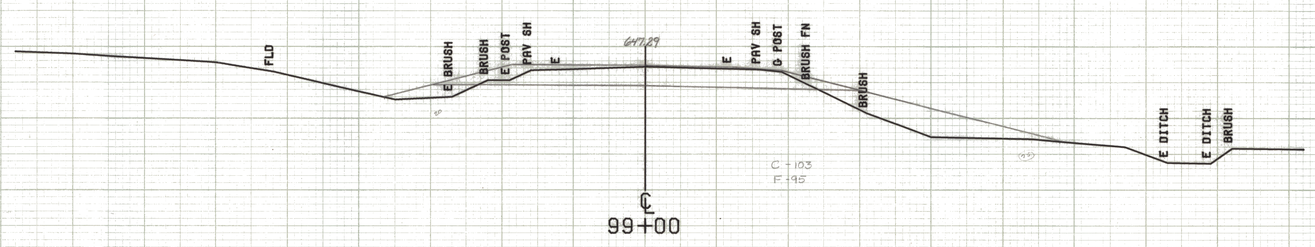

640

99+00

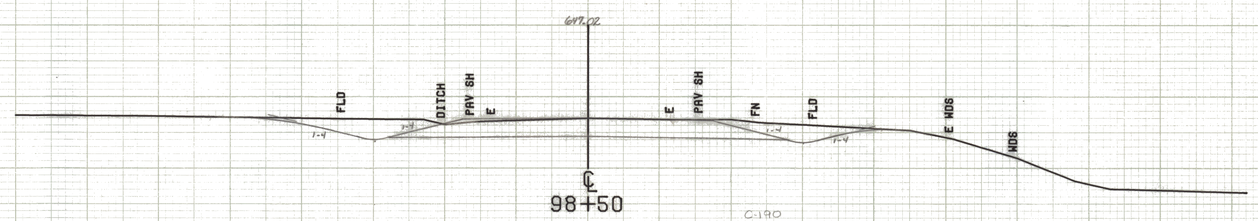

640

98+50

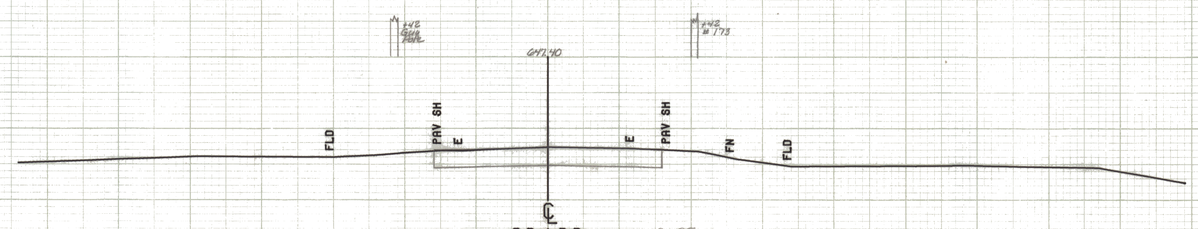

640

98+00
Begin Approach

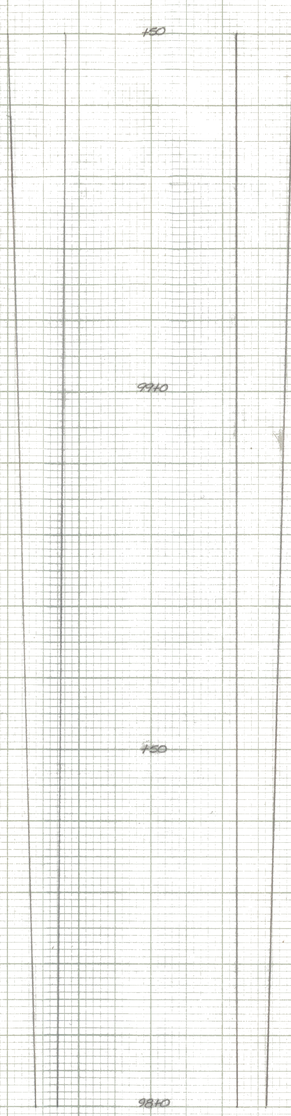

Width Transition
SCALE
1"= 10'

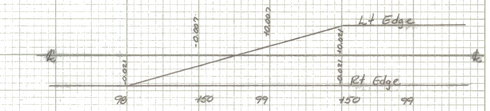

Banking Transition
Scale
Horiz 1"= 50'
Vert 1"= 0.05'

PC 99+26.95
D 1° Rt.

SCALE 10 FEET

FROM STA. 98+00		TO STA. 99+50	
PROJECT NAME	WALLINGFORD		
NO.	RS0137(5)		PLOTTED 10/06/80
SURVEYED BY	DAVIS		02/80
SHEET OF	SHEETS		