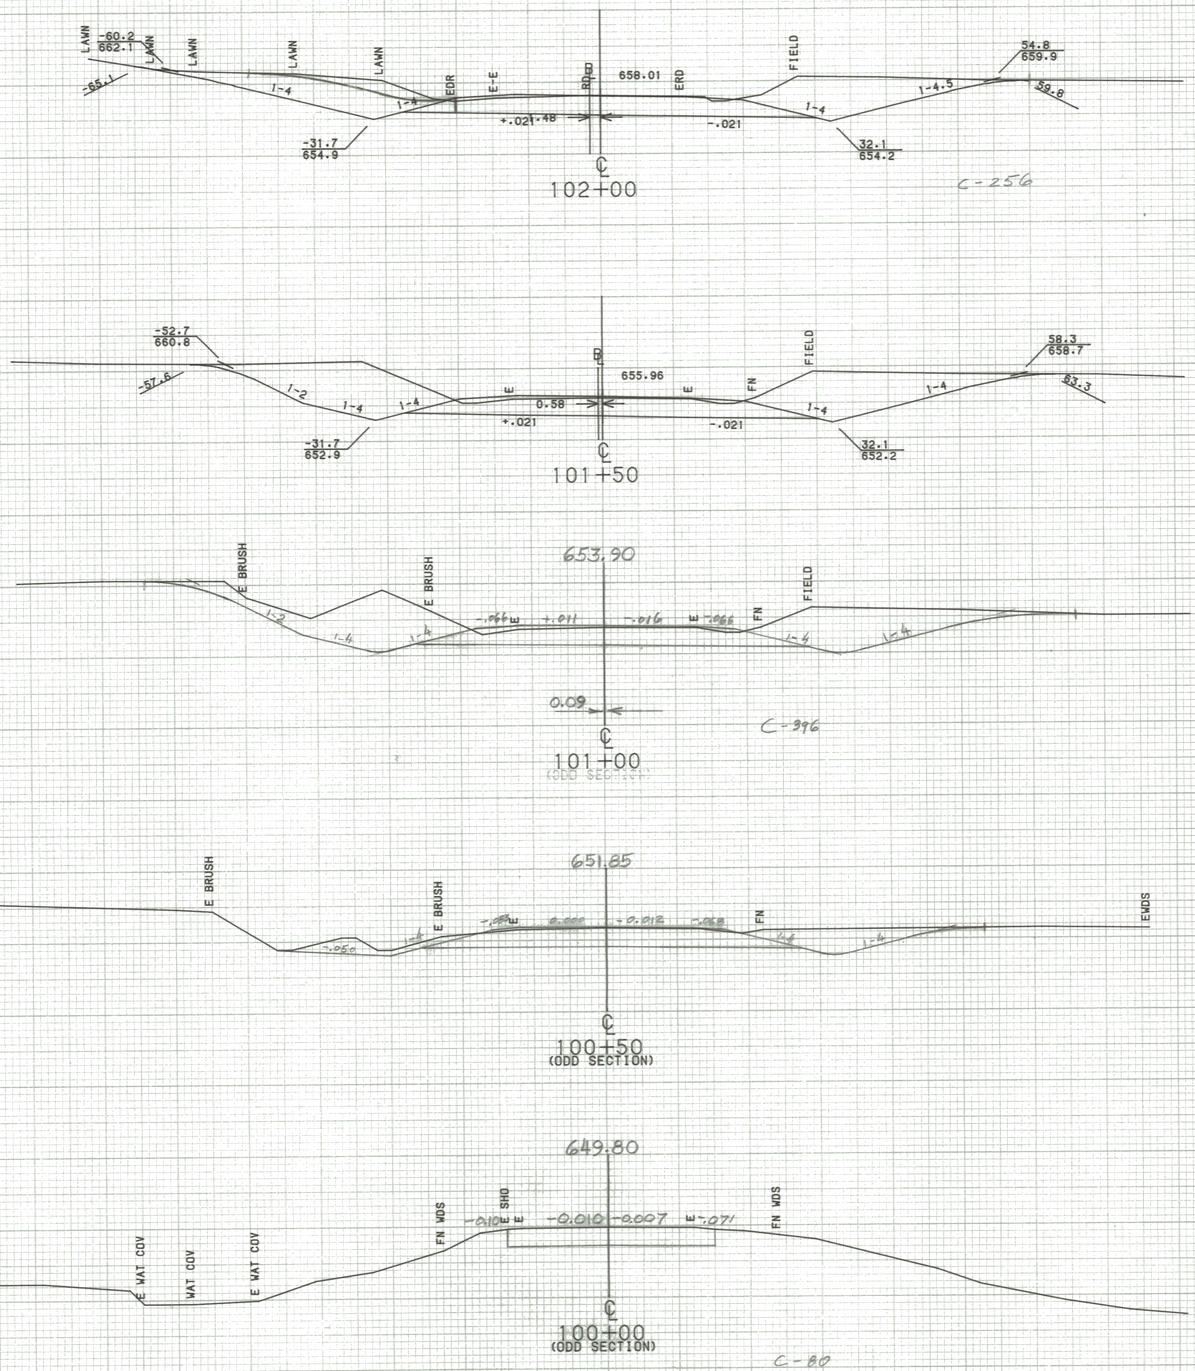


| | | |
|---|---|---|
| FROM STA. 100+00 | TO STA. 102+00 | |
| PROJECT NAME | WALLINGFORD | |
| NO. | RS0137(5) | PLOTTED 11/13/85 |
| SURVEYED BY | FANTONI | MAY - 85 |
| SHEET OF | SHEETS | |