


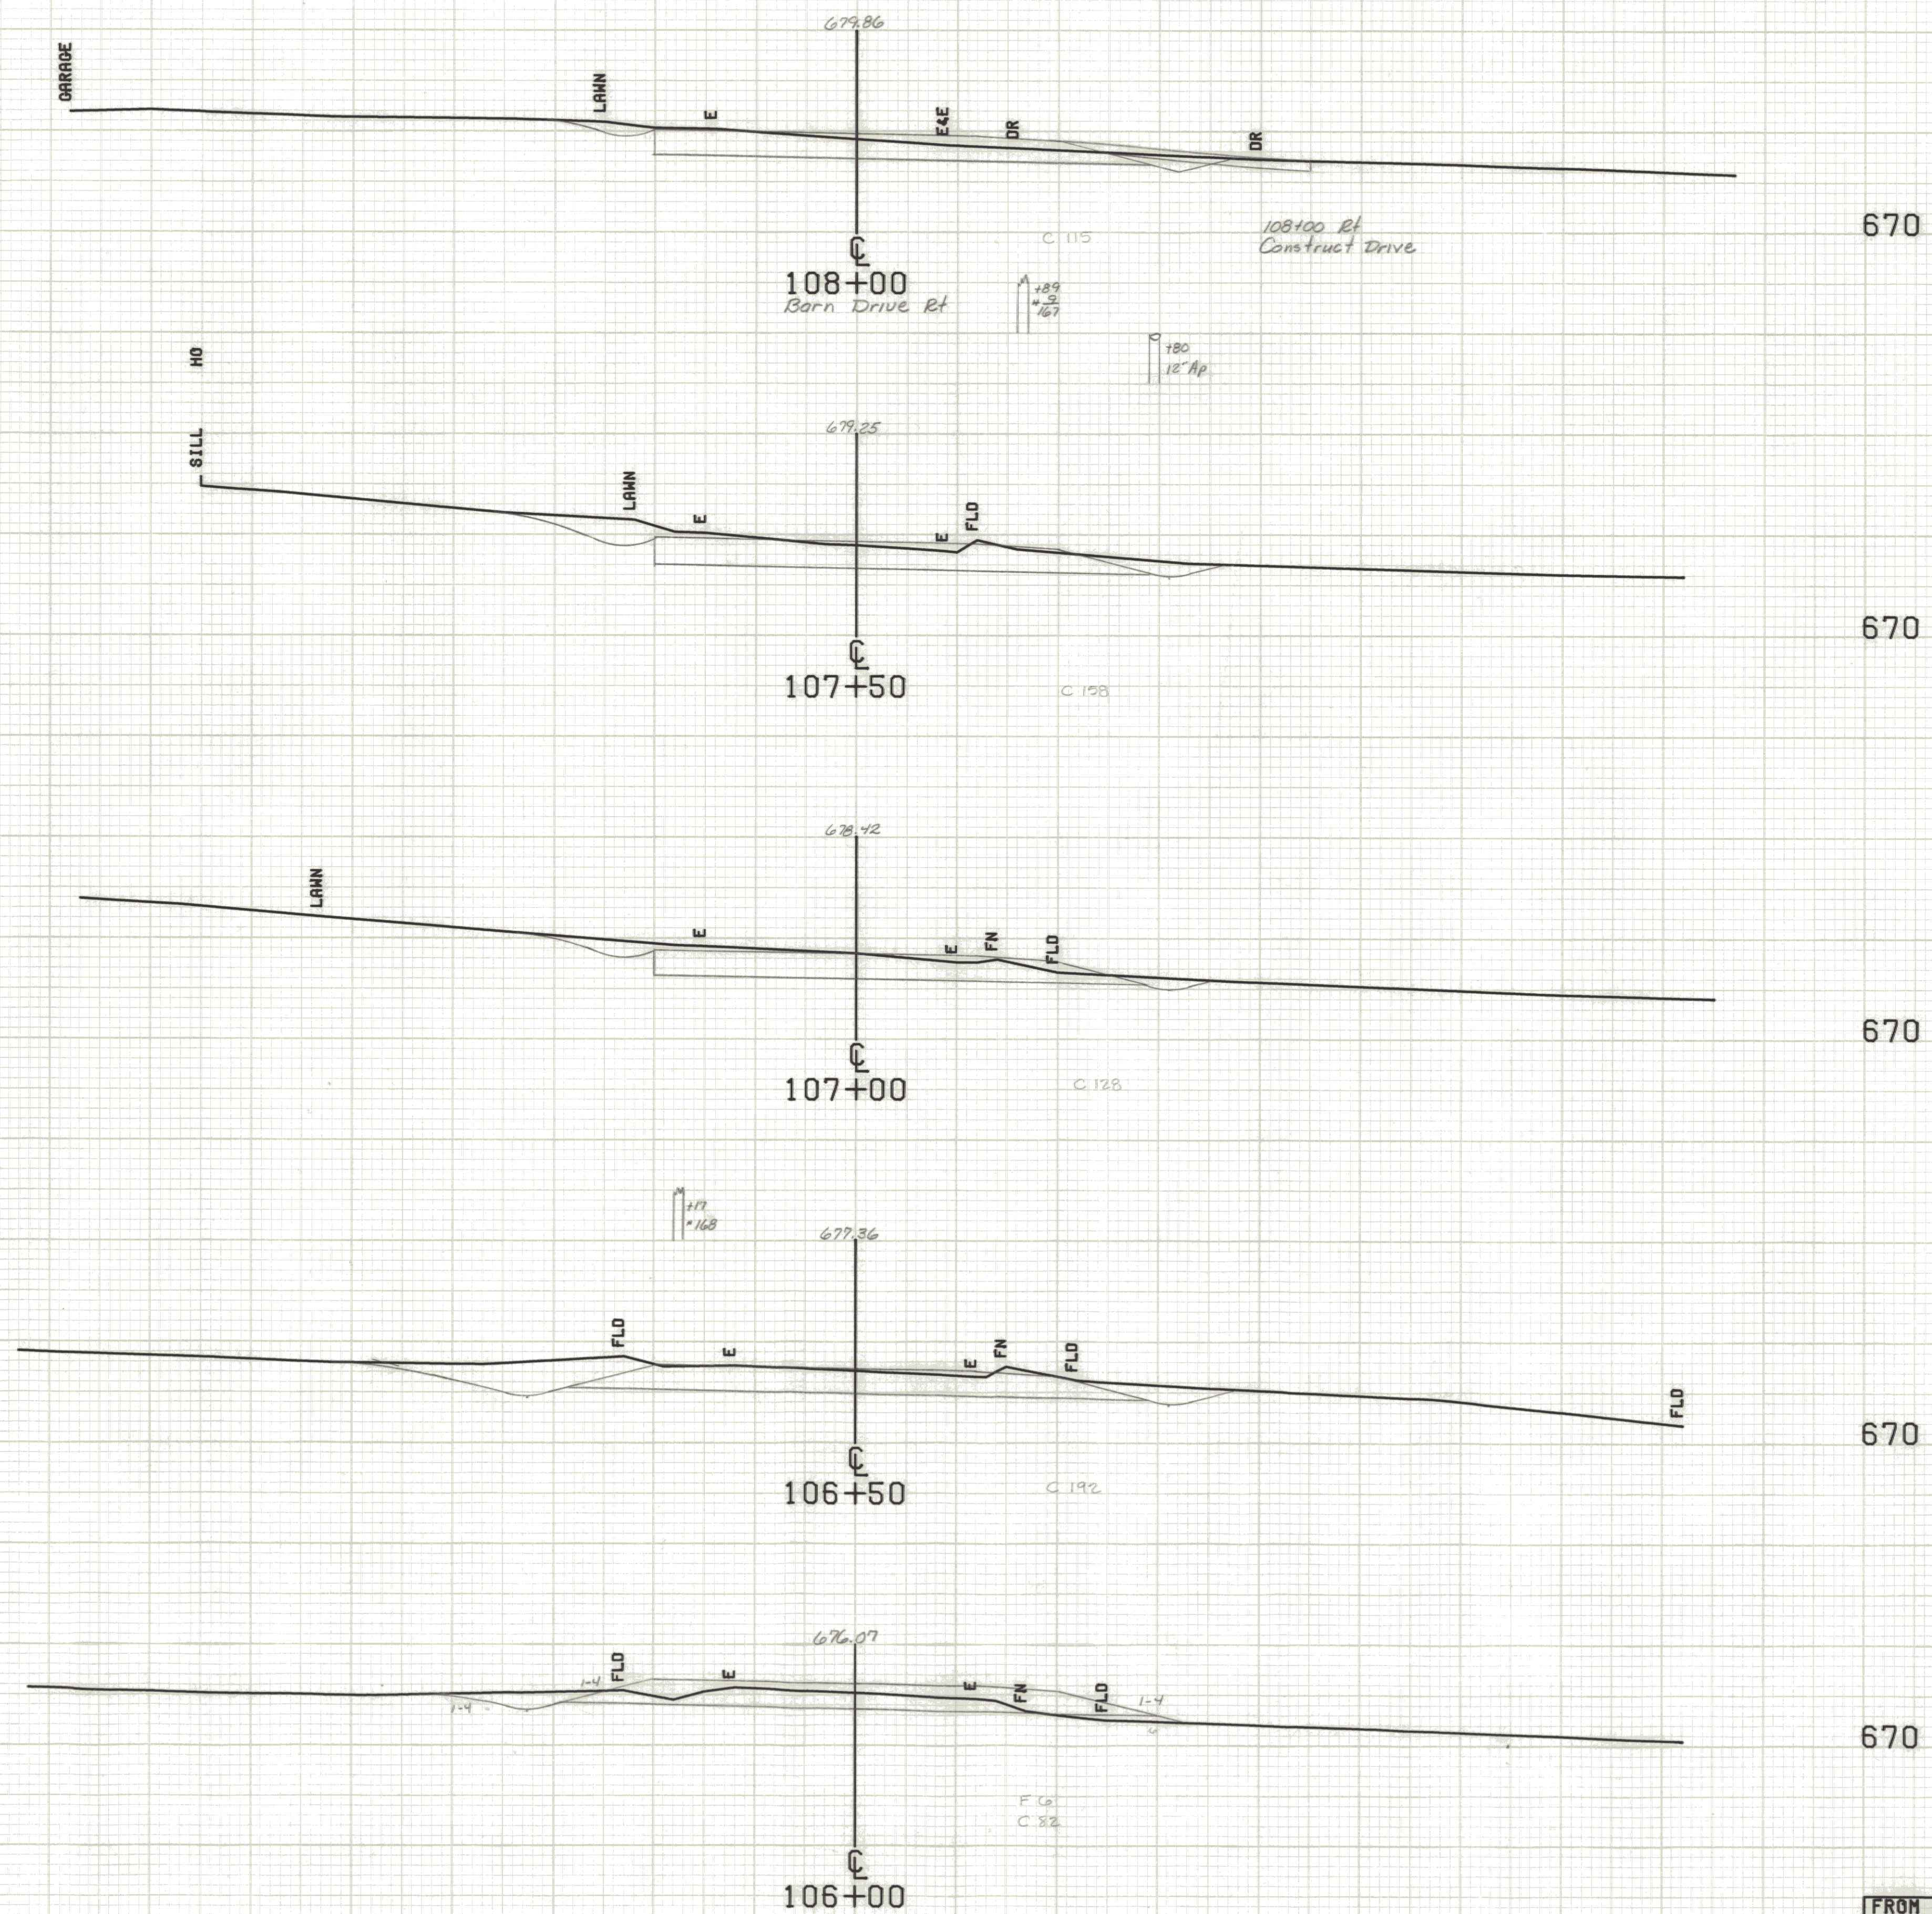

FROM STA. 106+00	TO STA. 108+00
PROJECT NAME	WALLINGFORD
NO.	RS0137(5)
SURVEYED BY	DAVIS
SHEET OF	SHEETS
	PLOTTED 10/06/80
	02/80