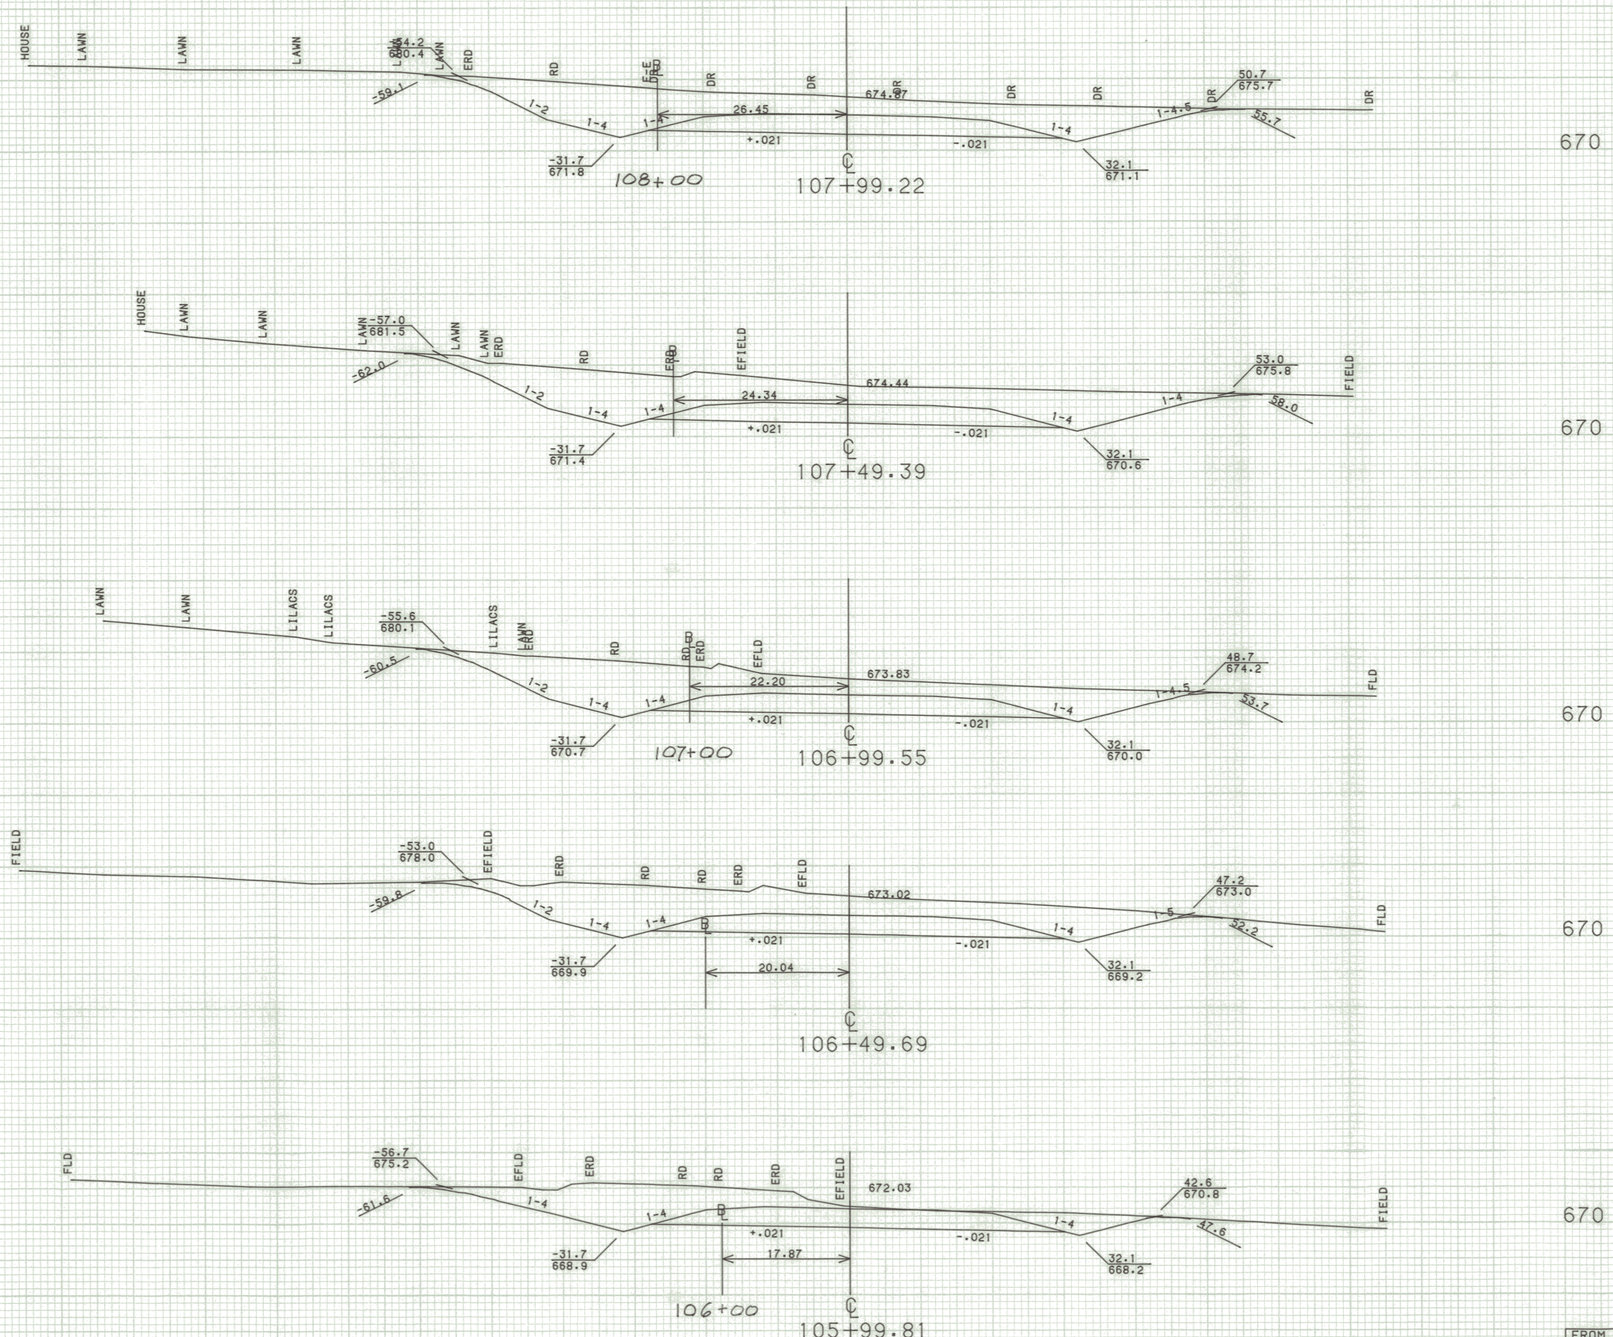

FROM STA. 105+99.81	TO STA. 107+99.22	
PROJECT NAME	WALLINGFORD	
NO.	RS0137(5)	PLOTTED 11/13/85
SURVEYED BY	FANTONI	MAY - 85
SHEET OF	SHEETS	