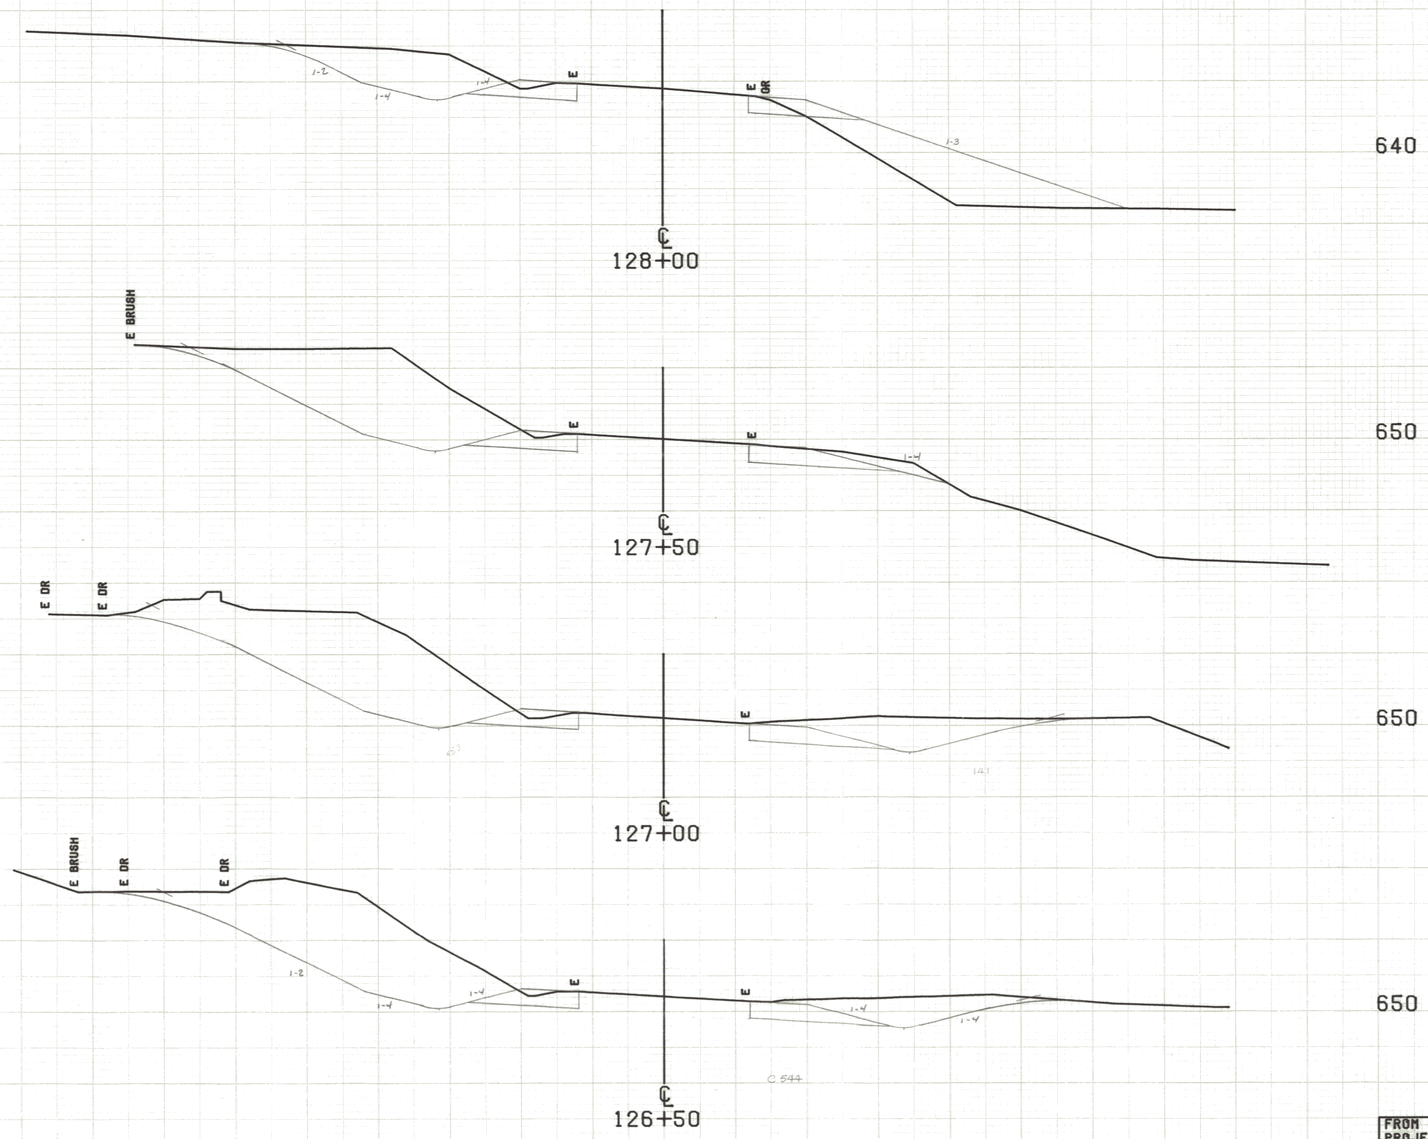

SCALE 10 FEET

FROM STA. 126+50		TO STA. 128+00	
PROJECT NAME	WALLINGFORD		
NO.		RS0137(5)	PLOTTED 10/06/80
SURVEYED BY	DAVIS		02/80
SHEET OF	SHEETS		