


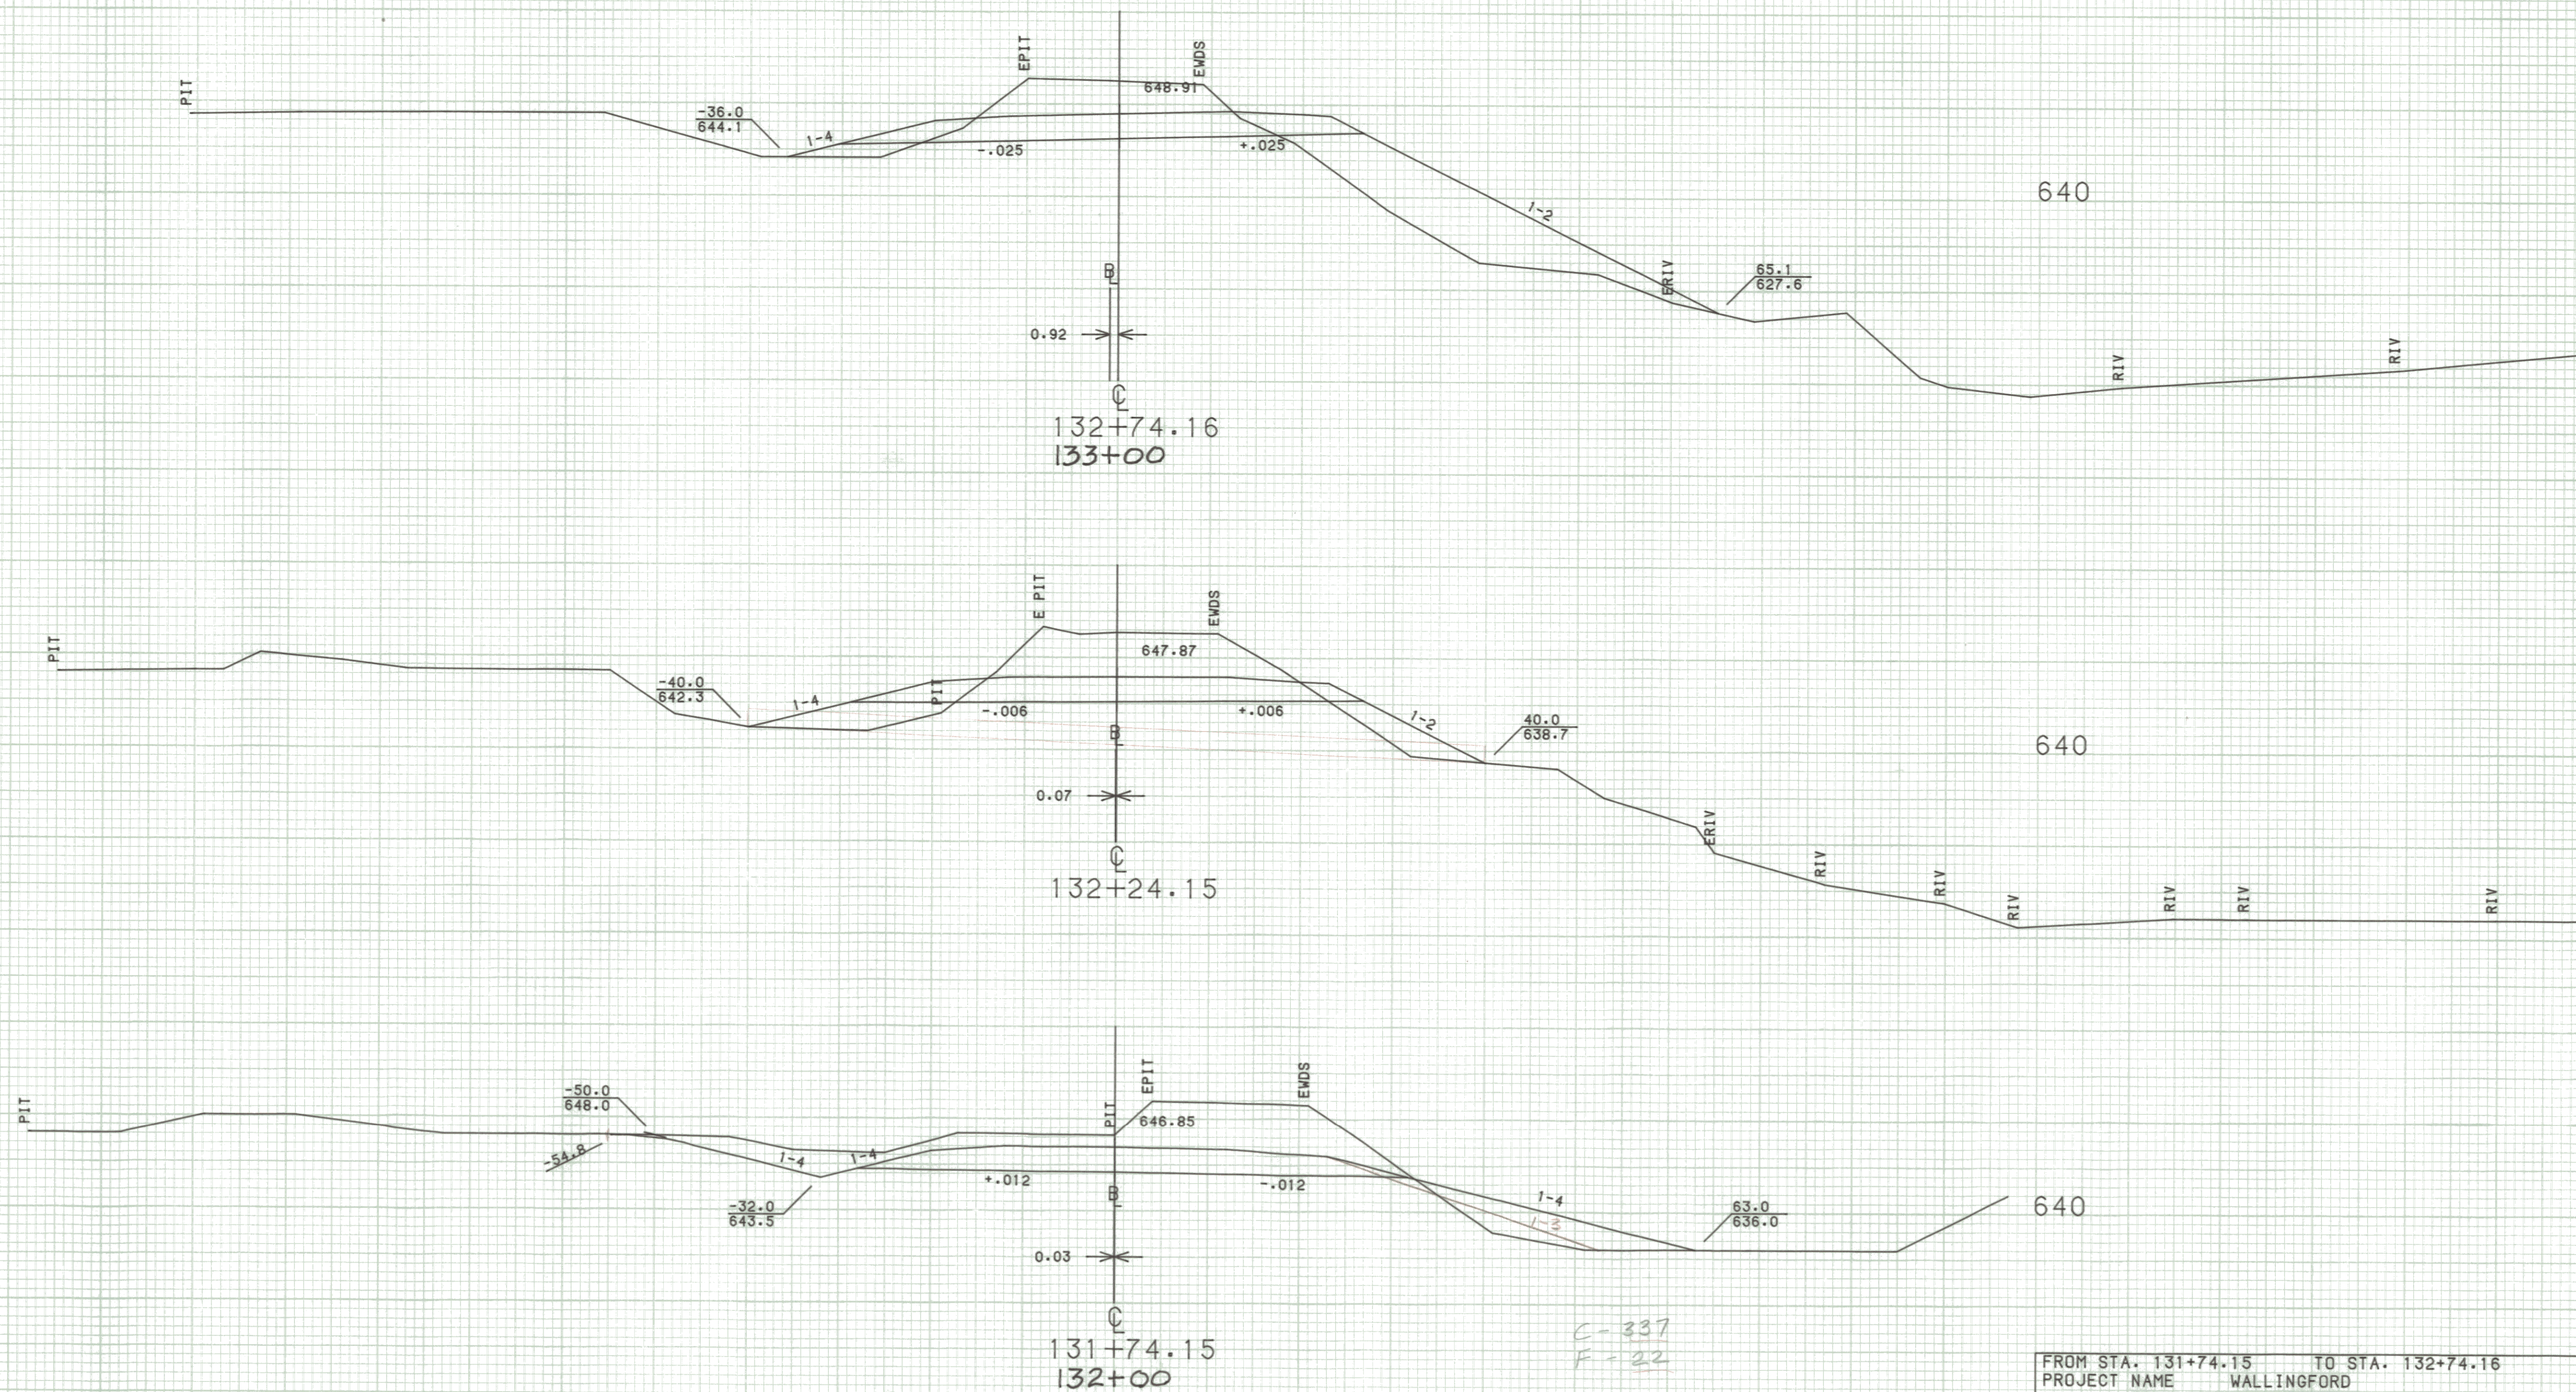

SCALE 1" = 10' FEET

FROM STA. 131+74.15	TO STA. 132+74.16
PROJECT NAME WALLINGFORD	
NO. RS0137 (5)	PLOTTED 11/13/85
SURVEYED BY FANTONI	MAY - 85
SHEET OF SHEETS	