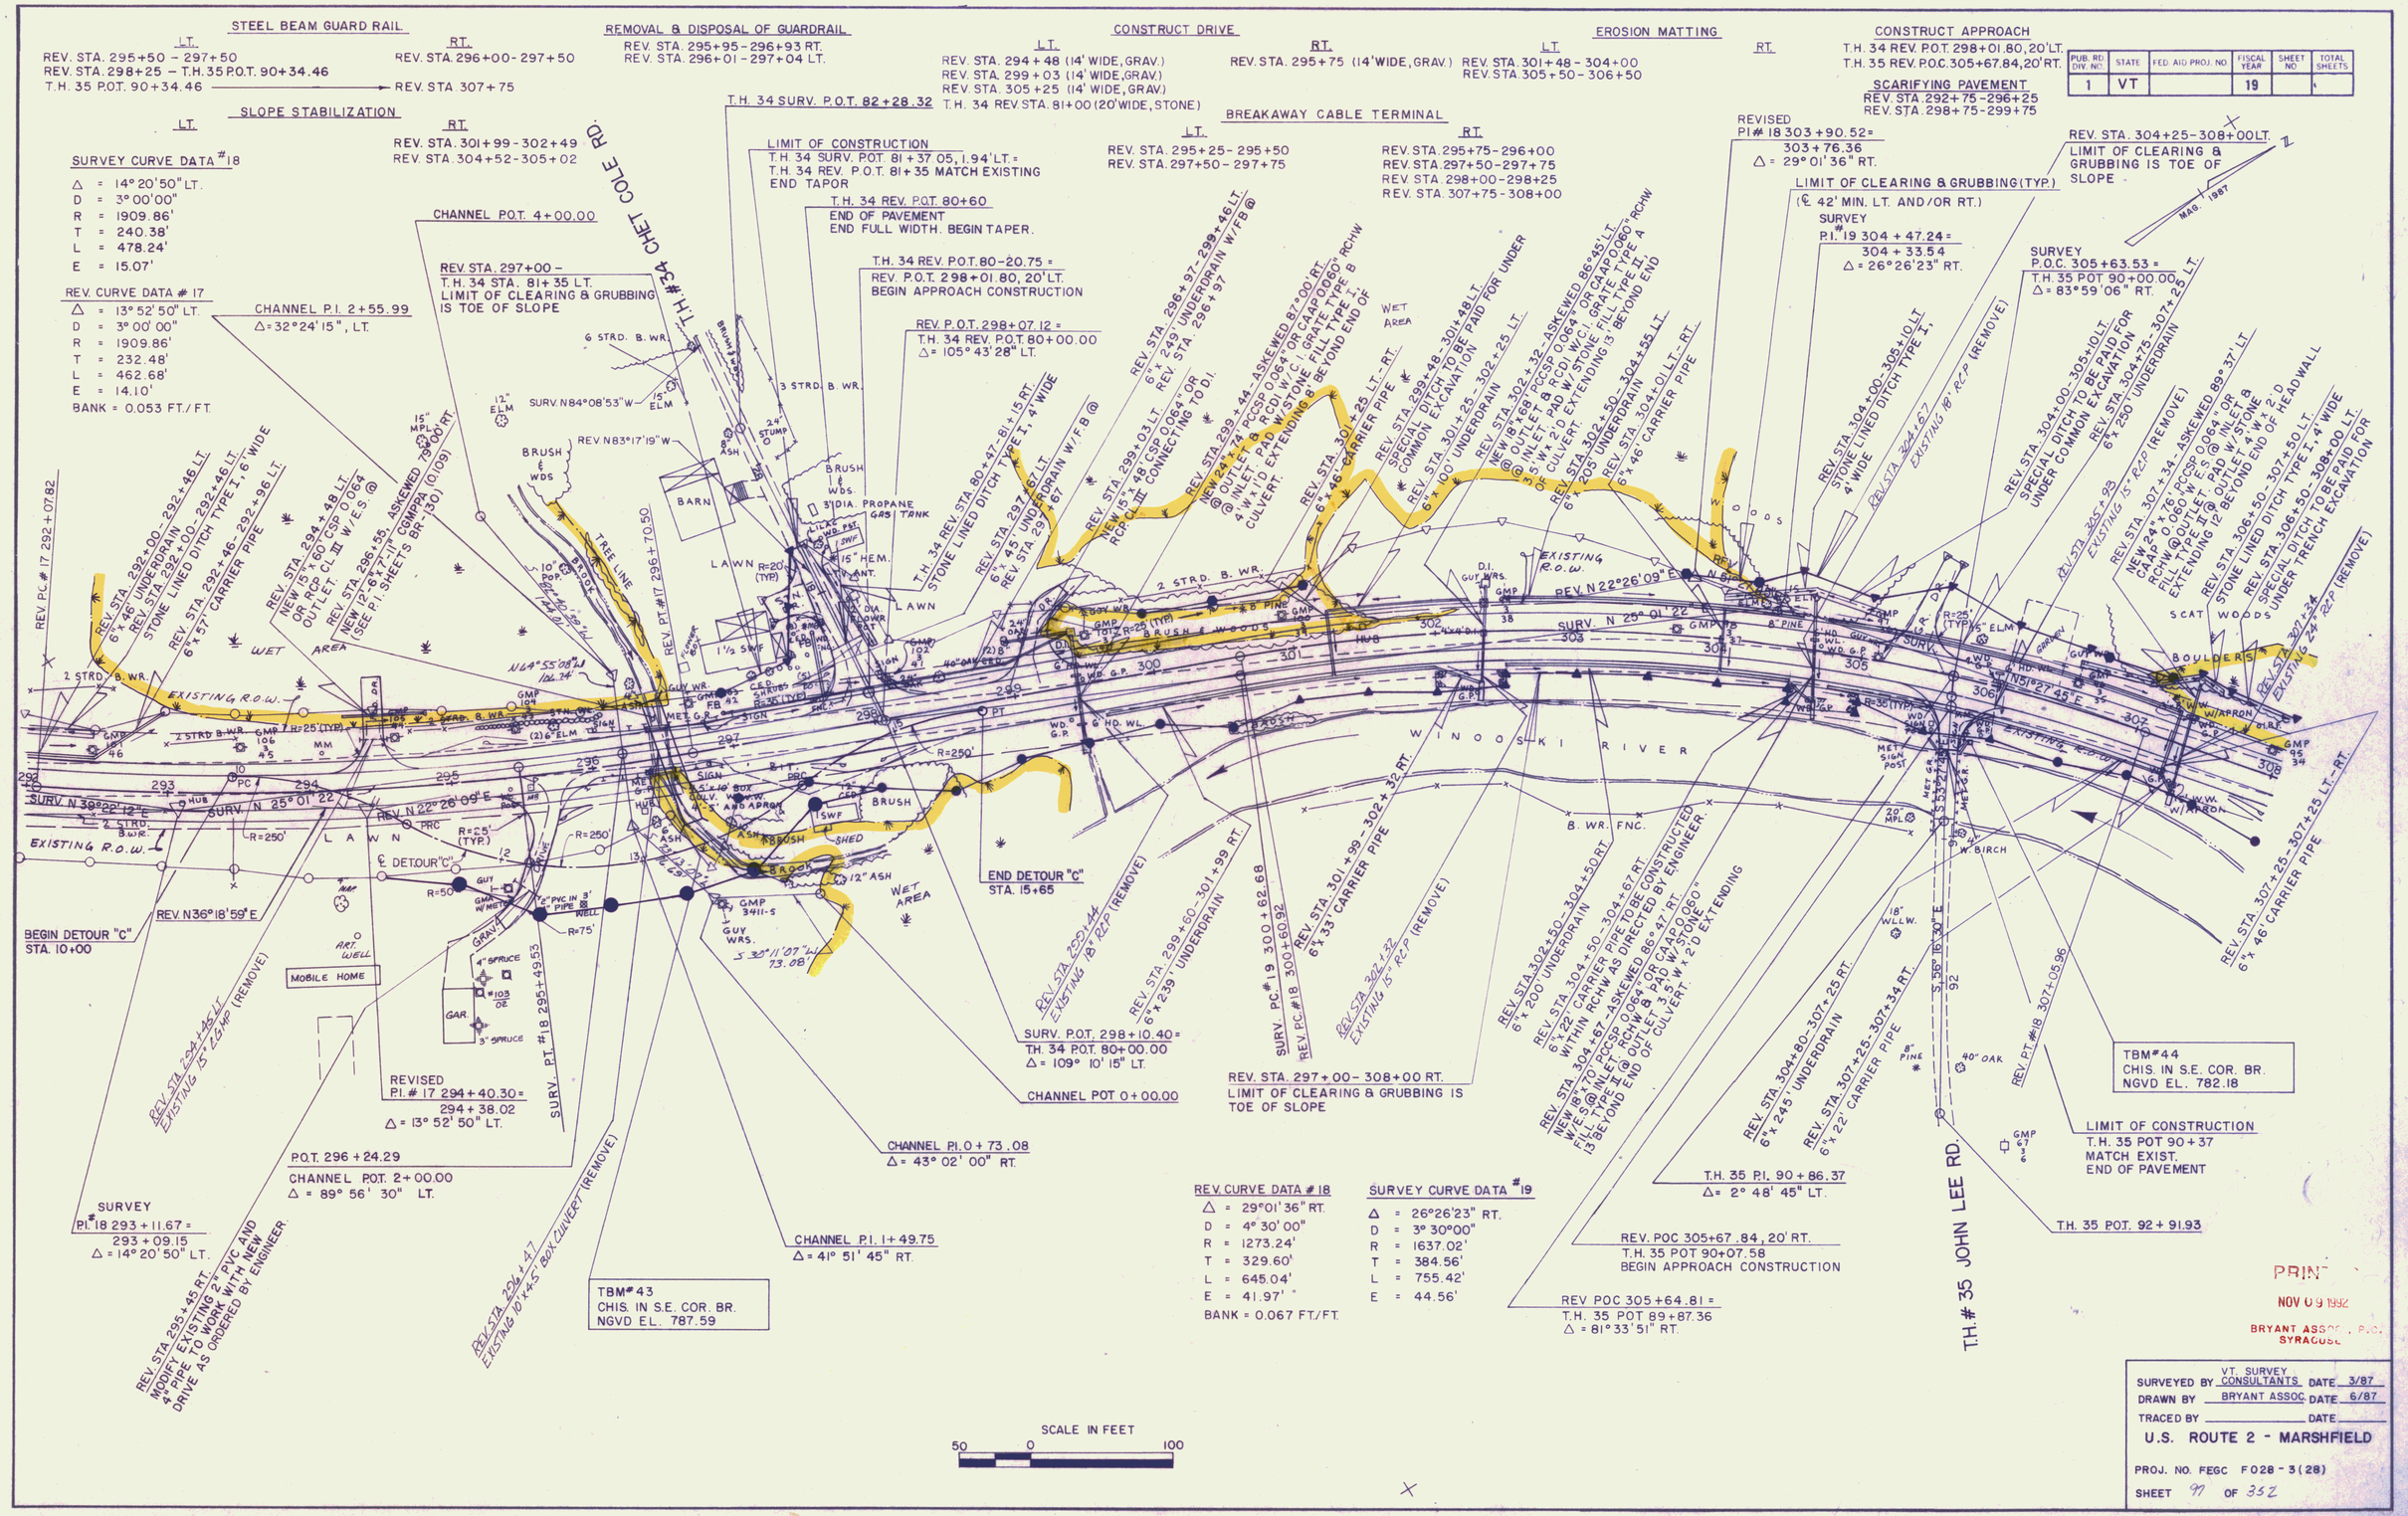

PUB. RD. DIV. NO.	STATE	FED. AID PROJ. NO.	FISCAL YEAR	SHEET NO.	TOTAL SHEETS
1	VT		19		

PRINT
NOV 09 1992
BRYANT ASSOC., P.C.
SYRACUSE

VT. SURVEY
SURVEYED BY CONSULTANTS DATE 3/87
DRAWN BY BRYANT ASSOC DATE 6/87
TRACED BY _____ DATE _____

U.S. ROUTE 2 - MARSHFIELD

PROJ. NO. FEGC F028-3(28)

SHEET 97 OF 352