U.S. ROUTE 2
MARSHFIELD
F028-3(28)

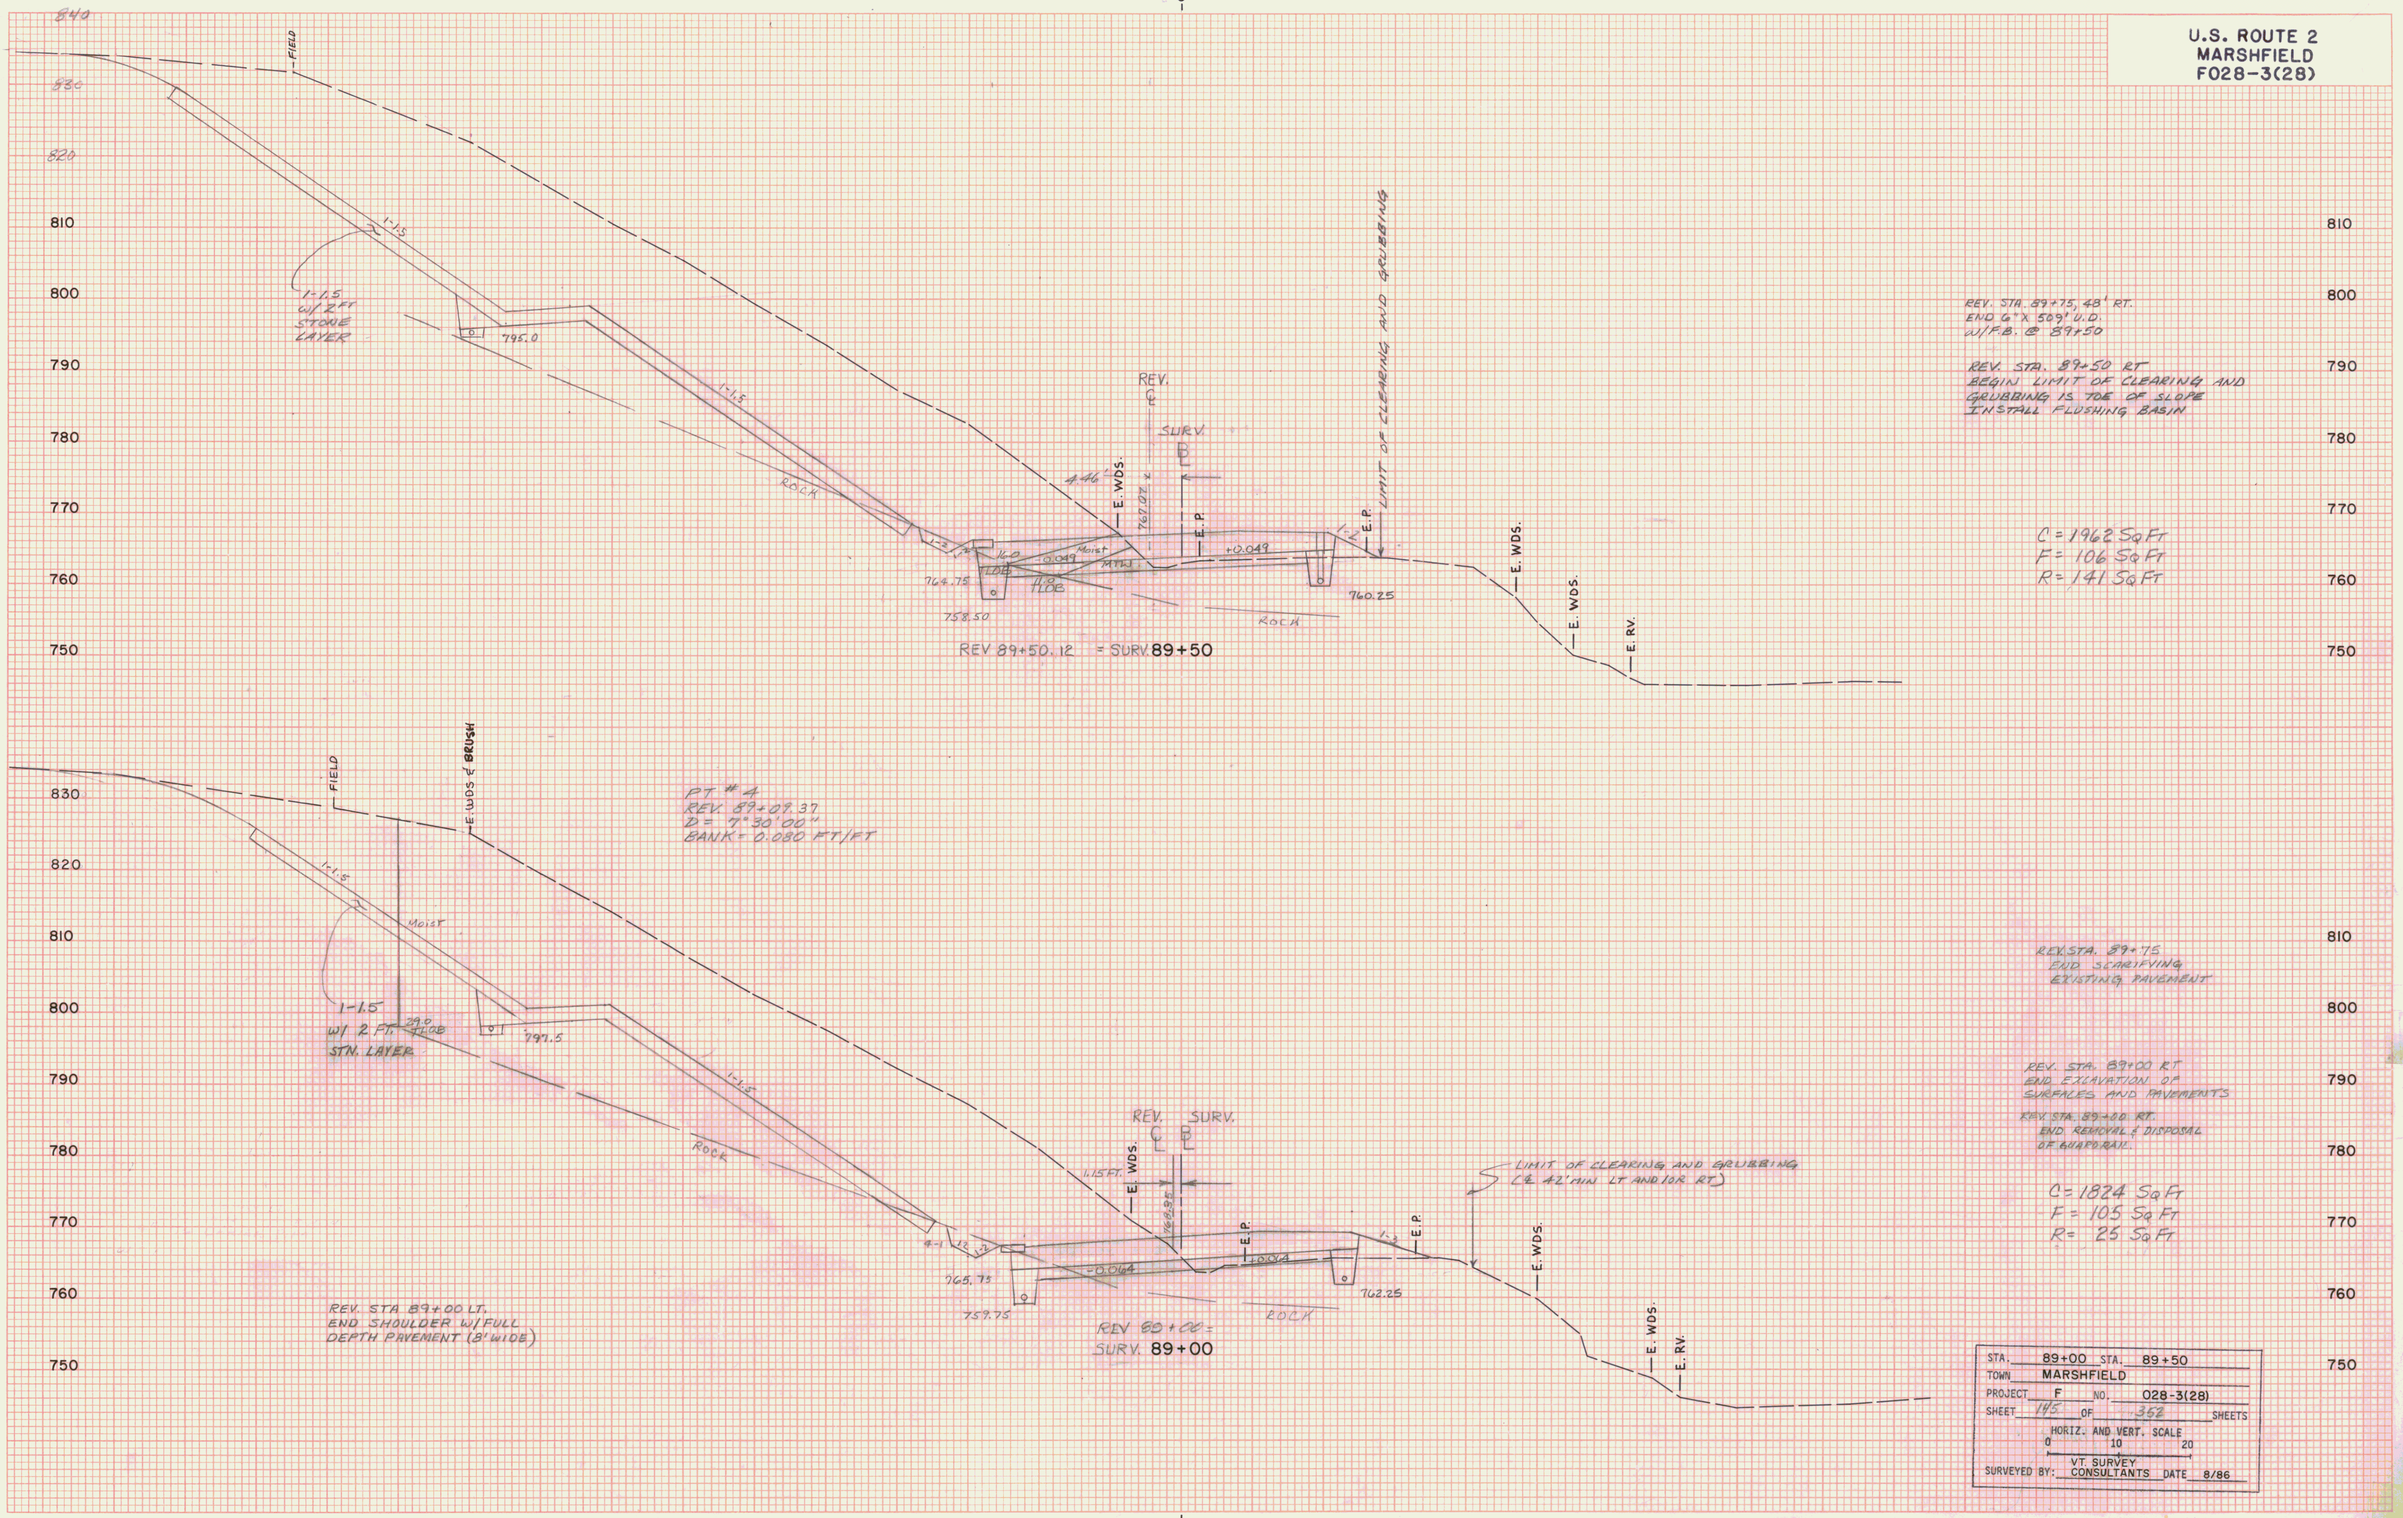

STA.	89+00 STA. 89+50
TOWN	MARSHFIELD
PROJECT	F NO. 028-3(28)
SHEET	145 OF 352 SHEETS
HORIZ. AND VERT. SCALE	0 10 20
SURVEYED BY:	VT SURVEY CONSULTANTS DATE 8/86

FINAL SURVEY — NOTE BOOK NO. — SURVEYED / PLOTTED / TEMPLATE / AREAS / AREAS CHECKED — BY — DATE

ORIGINAL SURVEY — NOTE BOOK NO. — SURVEYED / PLOTTED / TEMPLATE / AREAS / AREAS CHECKED — BY VT SURVEY CONSULT. BRYANT ASSOC. — DATE 8/86 7/86

PLATE 3 CROSS SECTION O. P. R. & R. E. STANDARD
DIETZGEN CORPORATION