U.S. ROUTE 2
MARSHFIELD
F028-3(28)

REV. STA. 104+70 LT
BEGIN 6"X 1080' U.D.
END 6"X 128' U.D.
(BEGINS @ 103+82)
W/ F.B. @ 104+70, 109+49
& 113+49

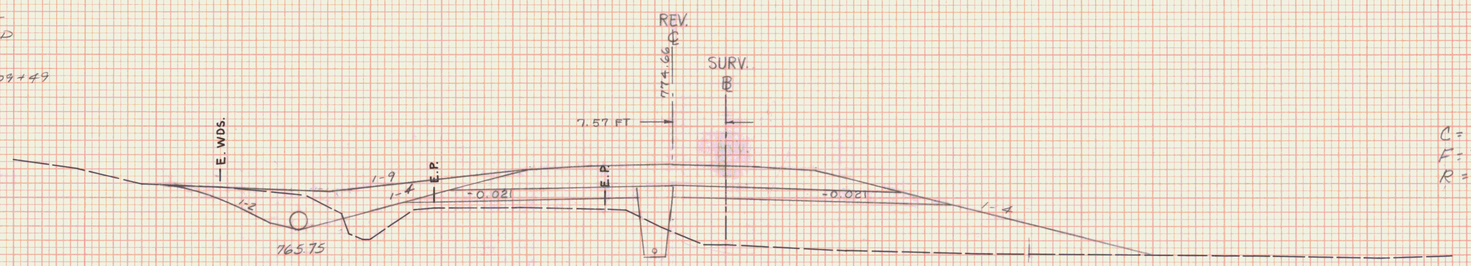

C = 42 SQ FT
F = 281 SQ FT
R = 0 SQ FT

REV STA 104+70 LT.
BEGIN SPECIAL DITCH

REV. 104 +48.58 = SURV. 104+50

T.H. 56 MARTIN JOHNSON RD.
T.H 56 REV. P.O.T. 20+20.28 =
REV. P.O.T. 104+07.58, 20' LT.
BEGIN APPROACH CONSTRUCTION

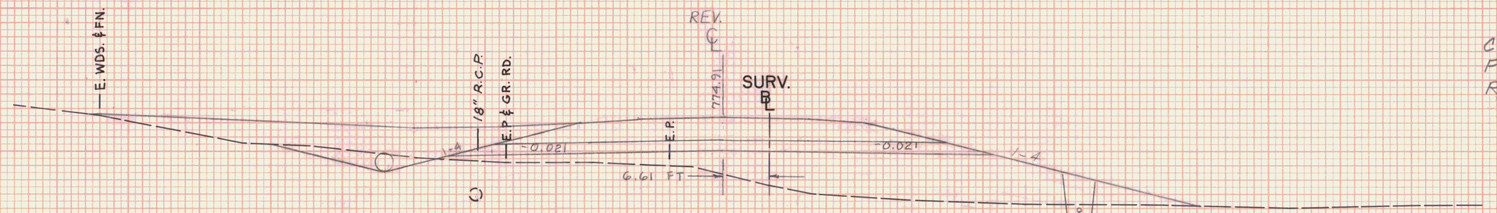

C = 32 SQ FT
F = 370 SQ FT
R = 0 SQ FT

REV. STA. 103+85 LT.
END STONE LINED DITCH TYPE I, 8' WIDE

REV STA 103+80 - ASKEWED 89°20' RT.
NEW 30"x 12" RCOSP 0.064", CMAP 0.060,
CPEP(SL) OR RCP CL III. NEW 4'x6'
RCDI W/ 2 TYPE A GRATES @ INLET. PAD
W/ STONE FILL TYPE II @ OUTLET
4'W x 2'D EXTENDING 15' BEYOND
END OF CULVERT

REV STA 103+80
EXIST 24" RCP
(TO BE REMOVED)

REV. 103+82. 70 RT
REG. 6"x 128" U.D.
(ENDS STA. 104+70 LT.)

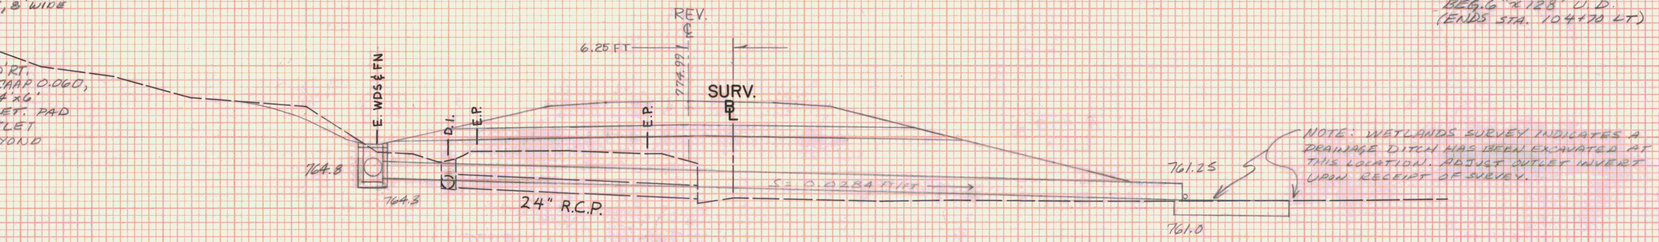

REV 103+79.57 = SURV. 103+81
ASKEWED @ 89° 20' RT.

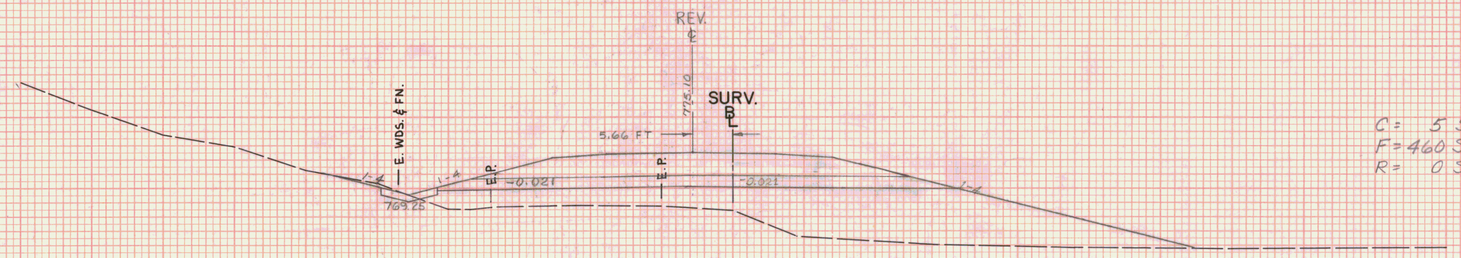

C = 5 SQ FT
F = 460 SQ FT
R = 0 SQ FT

REV. 103+48.57 = SURV. 103+50

STA:	103+50 STA. 104+50
TOWN	MARSHFIELD
PROJECT	F NO. 028-3(28)
SHEET	155 OF 352 SHEETS
HORIZ. AND VERT. SCALE	0 10 20
SURVEYED BY:	VT. SURVEY CONSULTANTS DATE 8/86

FINAL SURVEY — NOTE BOOK — NO. — SURVEYED — PLOTTED — TEMPLATE — AREAS — AREAS CHECKED — BY — DATE

VT. SURVEY CONSULT. 8/86
BRYANT ASSOC.

ORIGINAL SURVEY — NOTE BOOK — NO. — SURVEYED — PLOTTED — TEMPLATE — AREAS — AREAS CHECKED

PLATE 3 CROSS SECTION O. P. R. & R. E. STANDARD
DIETZGEN CORPORATION