


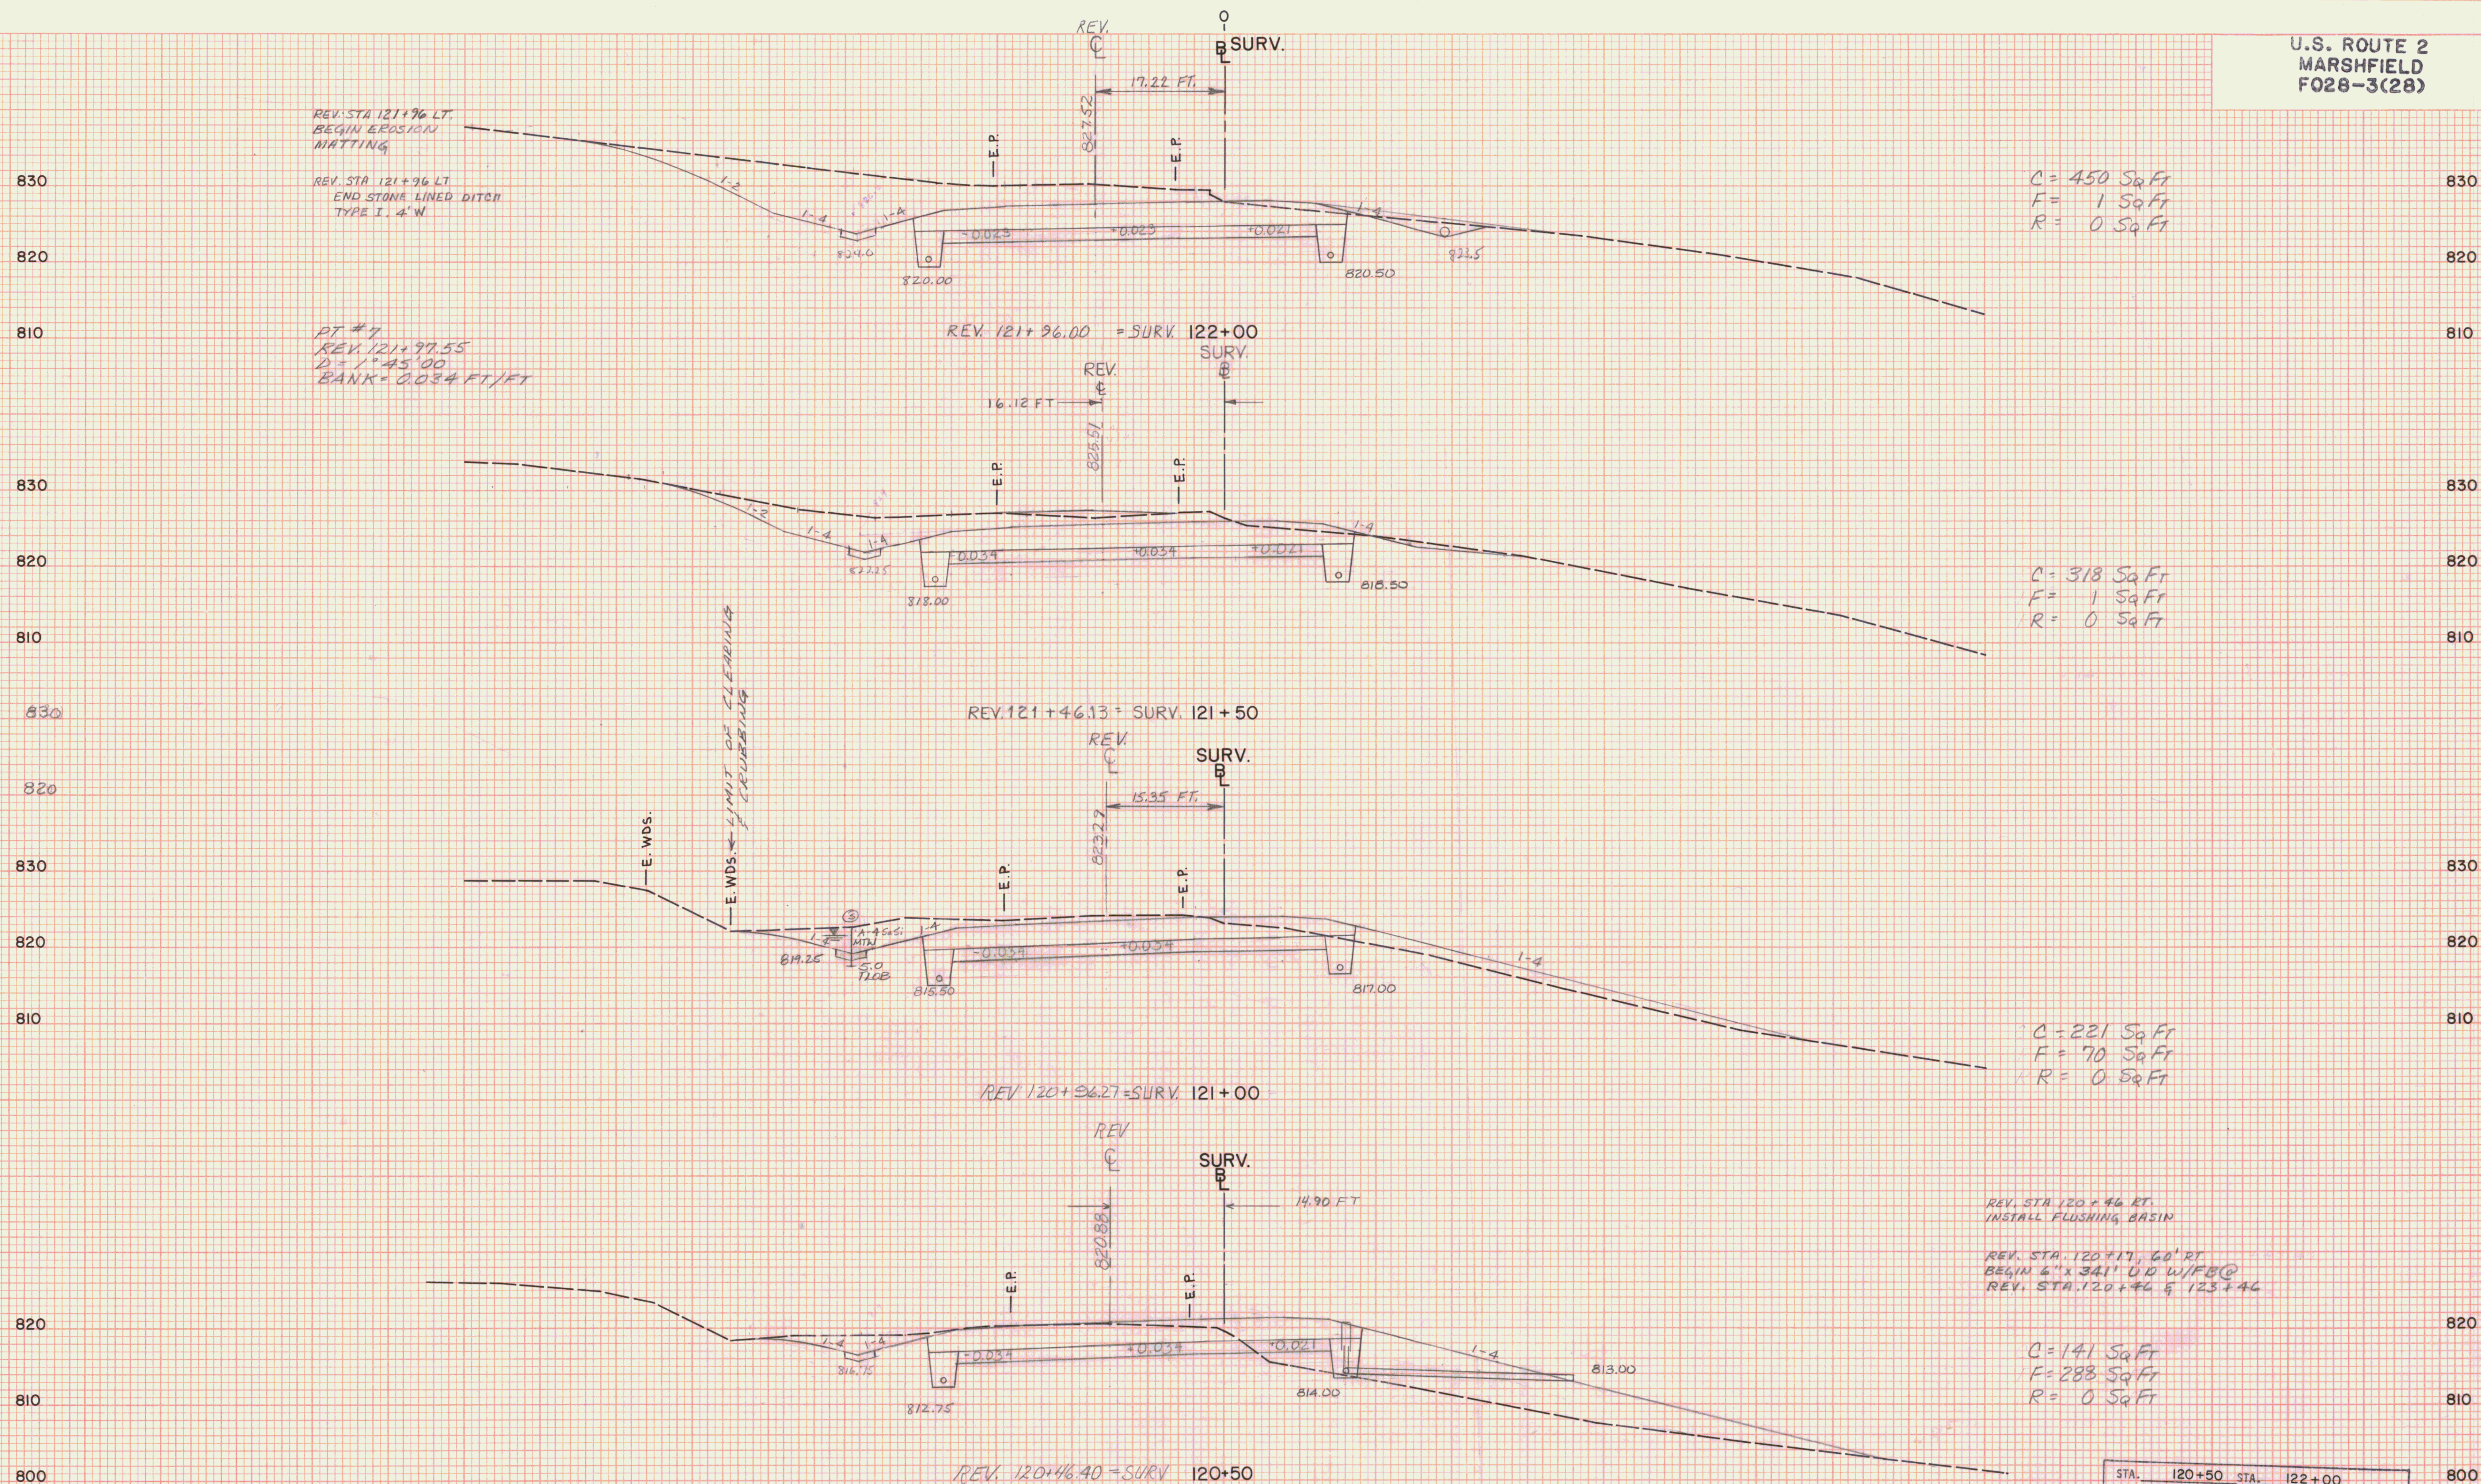

STA. 120+50 STA. 122+00
TOWN MARSHFIELD
PROJECT F NO. 028-3(28)
SHEET 165 OF 1362 SHEETS
HORIZ. AND VERT. SCALE
0 10 20
VT SURVEY
SURVEYED BY: CONSULTANTS DATE 8/86