


DATE	
BY	
SURVEYED	
TEMPLATE	
AREAS	
NO.	

DATE	
BY	
SURVEYED	
TEMPLATE	
AREAS	
NO.	

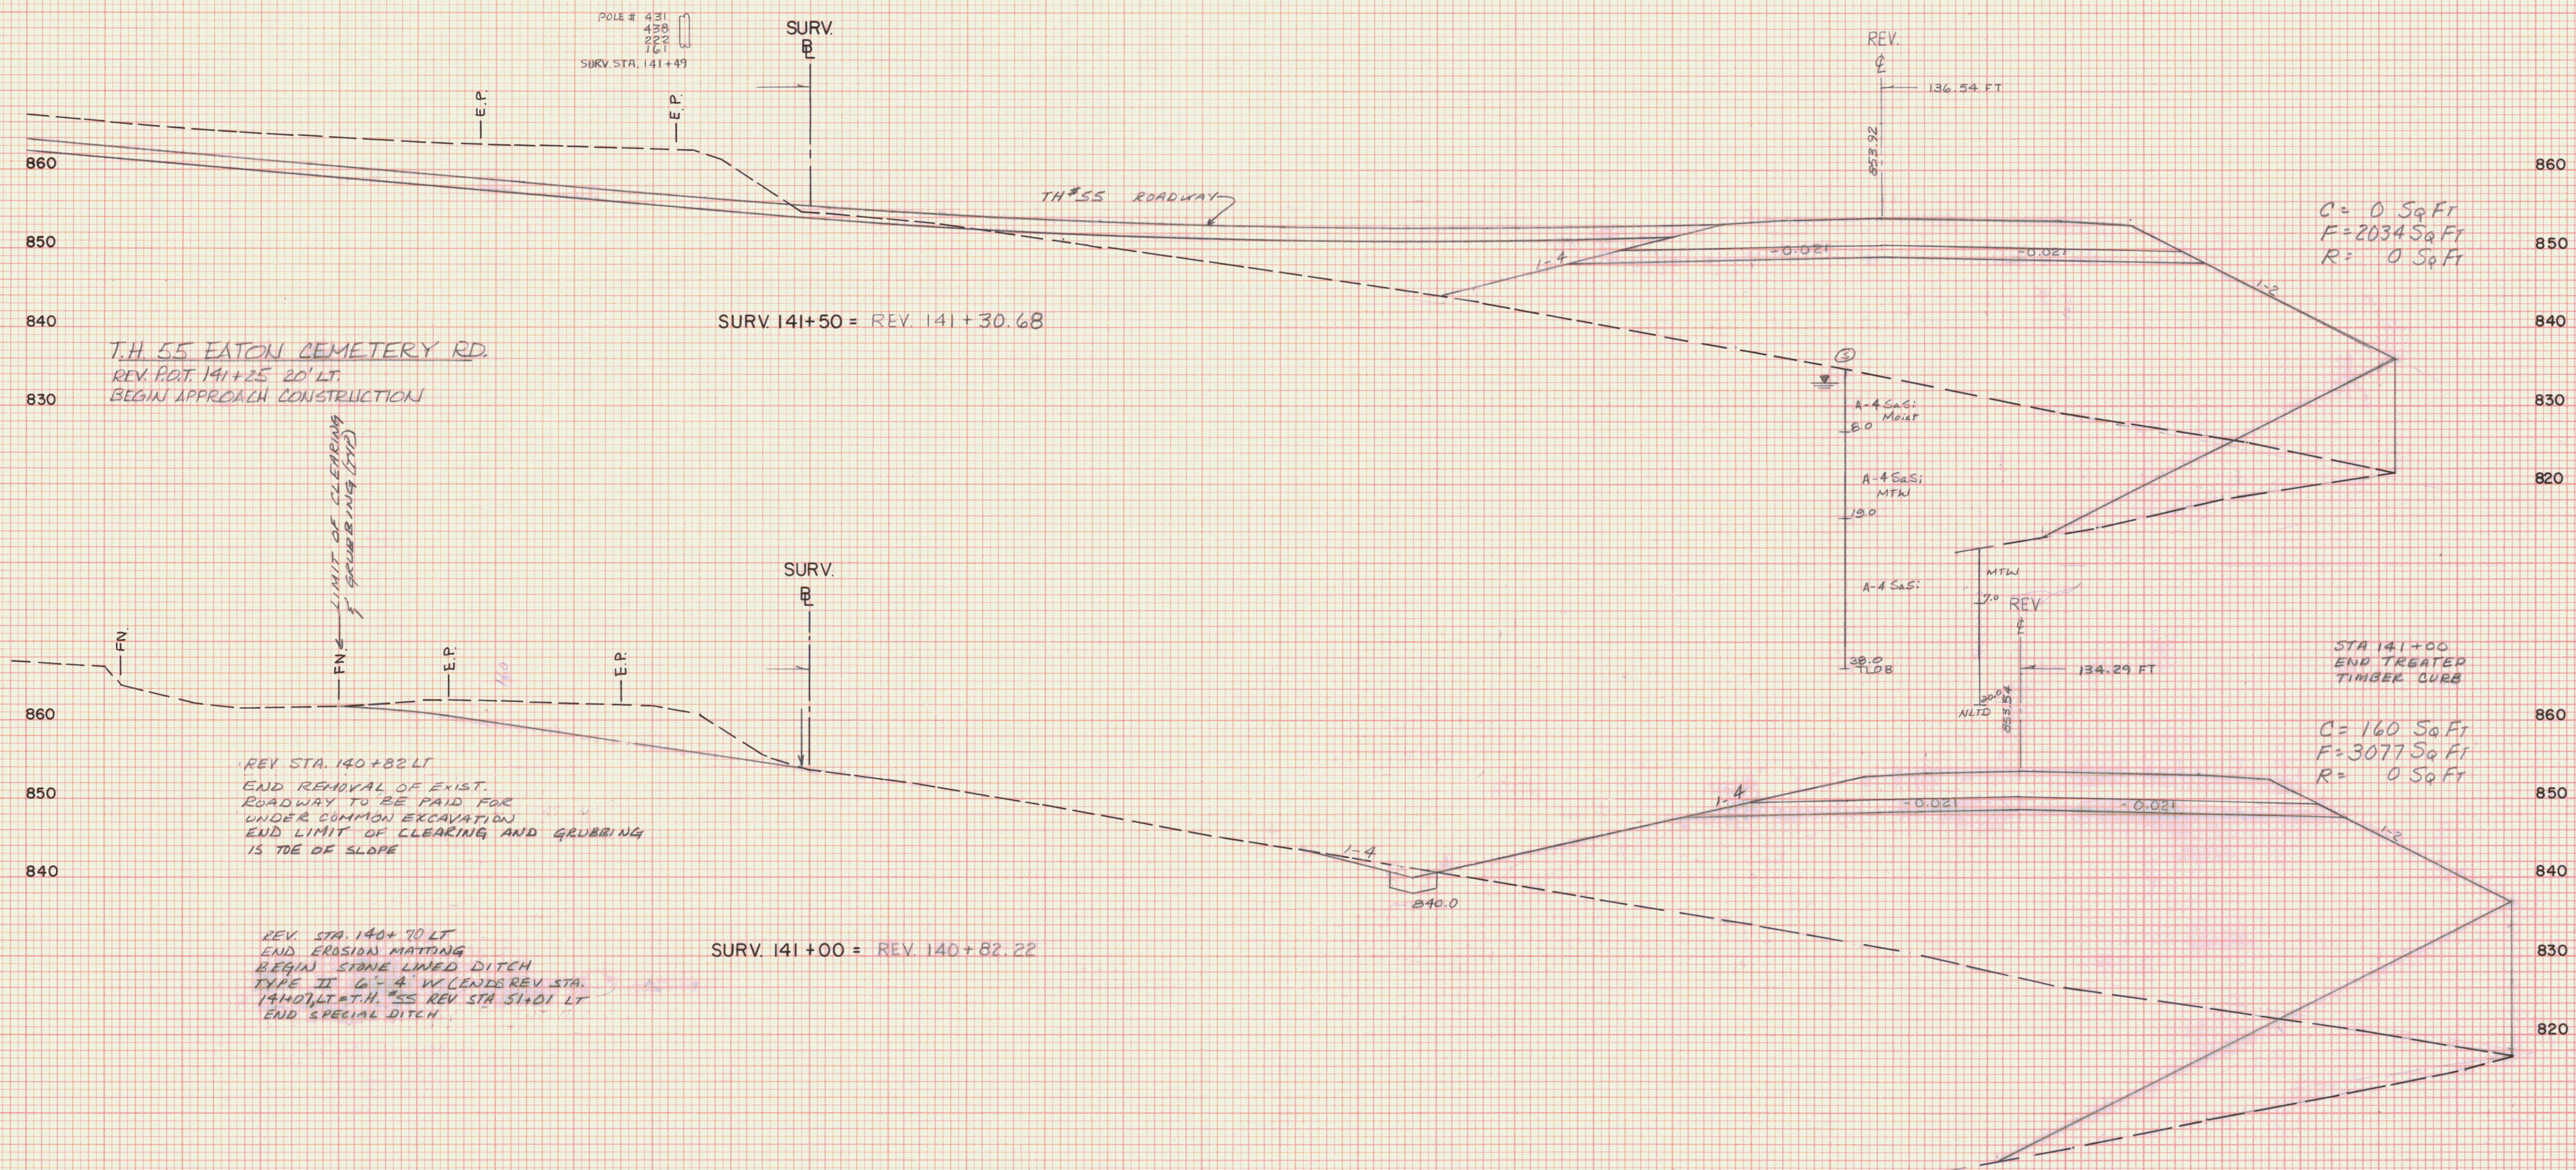

STA. 141+00	STA. 141+50
TOWN MARSHFIELD	
PROJECT F	NO. 028-3(28)
SHEET 183	OF 352 SHEETS
HORIZ. AND VERT. SCALE	
0 10 20	
VT. SURVEY	
SURVEYED BY: CONSULTANTS DATE 10/86	